


CITY OF GARDEN GROVE, CALIFORNIA

SURVEY OF Gilbert & Catherine TB NO. 3 PAGE 122
SURVEY BY Prickett & Party TRACT NO.
DATE Sept. 12, 1979

SURVEYORS SERVICE COMPANY OSTA MESA - STOCK NO. 411


DO NOT EXTEND NOTES THIS SIDE OF LINE

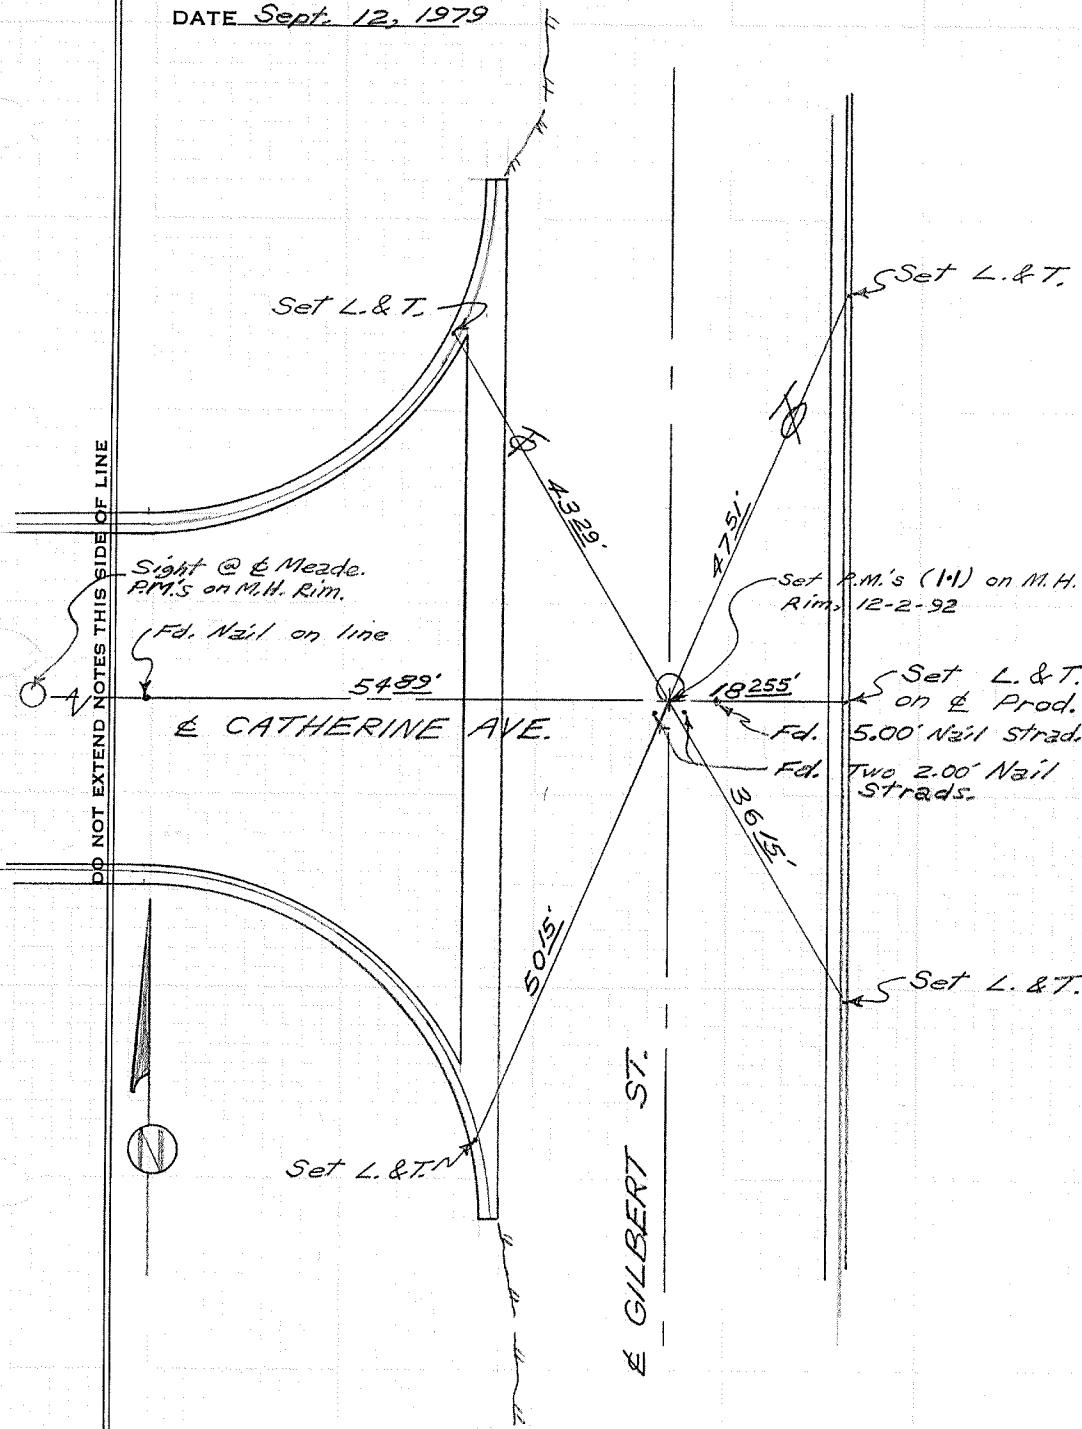

CITY OF GARDEN GROVE, CALIFORNIA

SURVEY OF Gilbert St. & Bixby Ave. TB NO. 3 PAGE 123
SURVEY BY Prickett & Party TRACT NO. 1684
DATE Sept. 12, 1979

DO NOT EXTEND NOTES THIS SIDE OF LINE

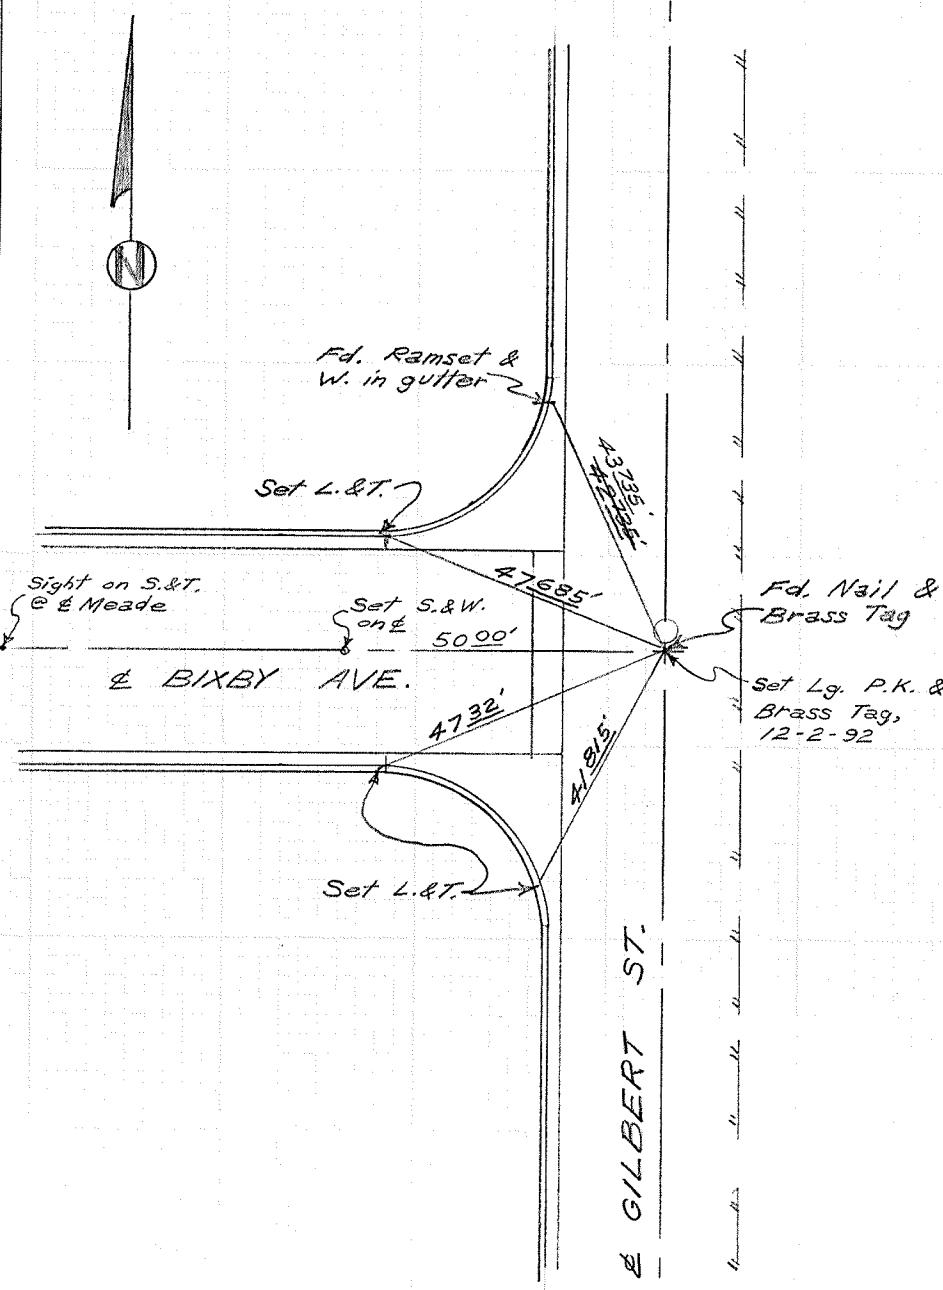


CITY OF GARDEN GROVE, CALIFORNIA

SURVEY OF VOLKWOOD ST. & LAMPSON AVE.
T. B NO. 3 PAGE 124

SURVEY BY PRICKETT + PARTY TRACT NO.

DATE 2-9-79

DO NOT EXTEND NOTES THIS SIDE OF LINE

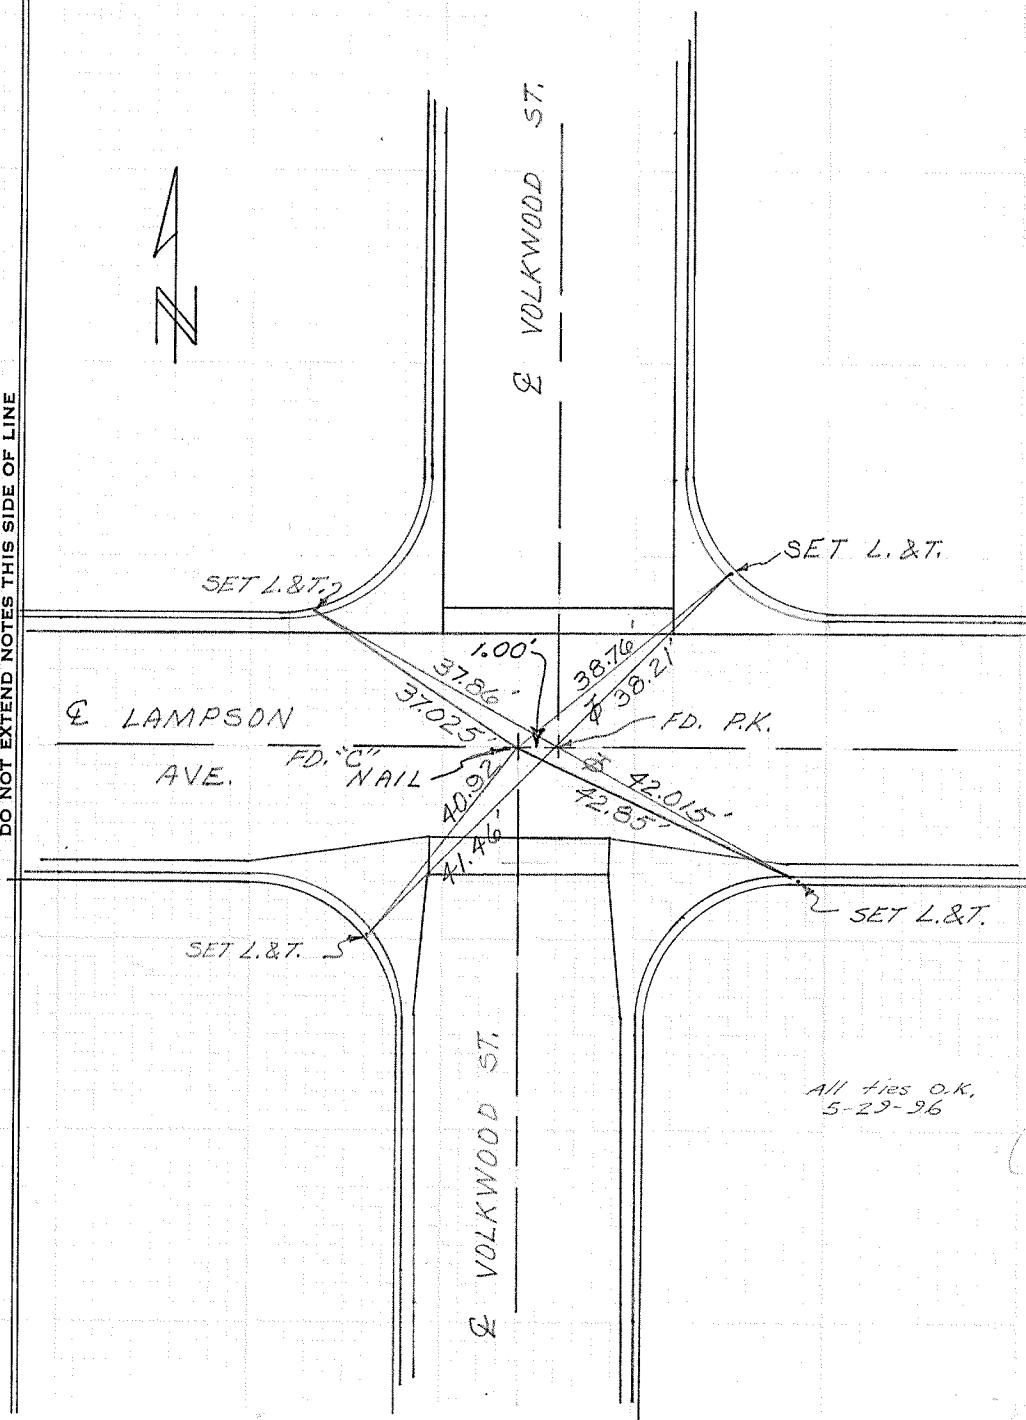


CITY OF GARDEN GROVE, CALIFORNIA

SURVEY OF LAMPSON AVE & CHOISER RD. T B NO. 3 PAGE 125
SURVEY BY PRICKETT + PARTY TRACT NO.
DATE 2-13-73

SURVEYORS SERVICE COMPANY - COSTA MESA - STOCK NO. 411

DO NOT EXTEND NOTES THIS SIDE OF LINE

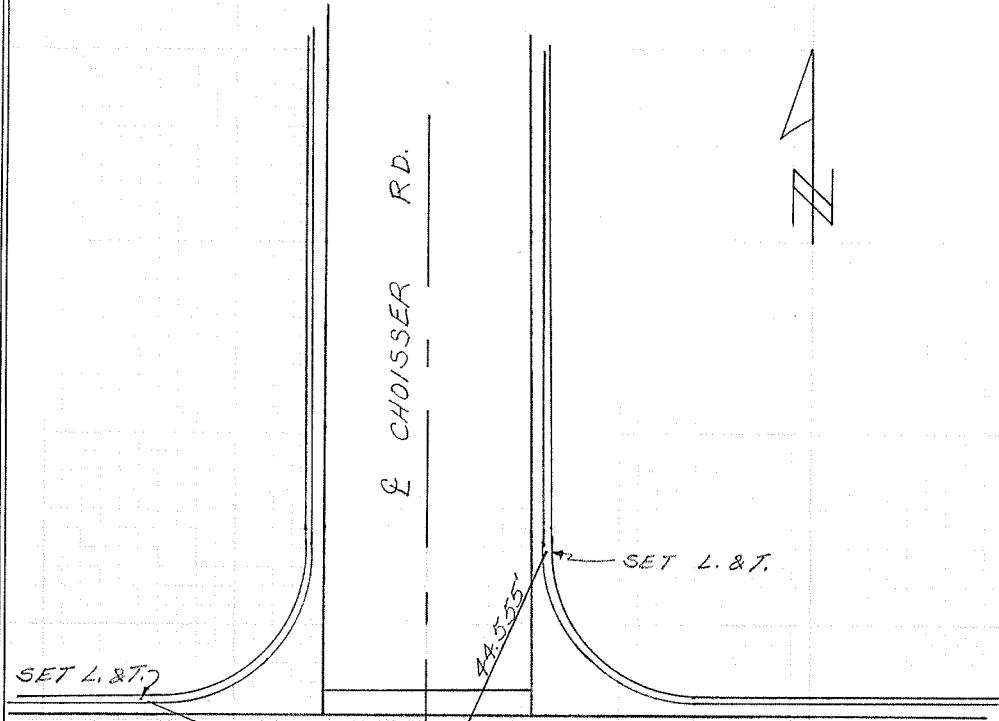

SET L.&T.


All ties present.
5-29-96

CITY OF GARDEN GROVE, CALIFORNIA

SURVEY OF Galway St. & Larson Ave. TB NO. 3 PAGE 126
SURVEY BY Prickett & Party TRACT NO. 1539

DATE May 18, 1979


DO NOT EXTEND NOTES THIS SIDE OF LINE

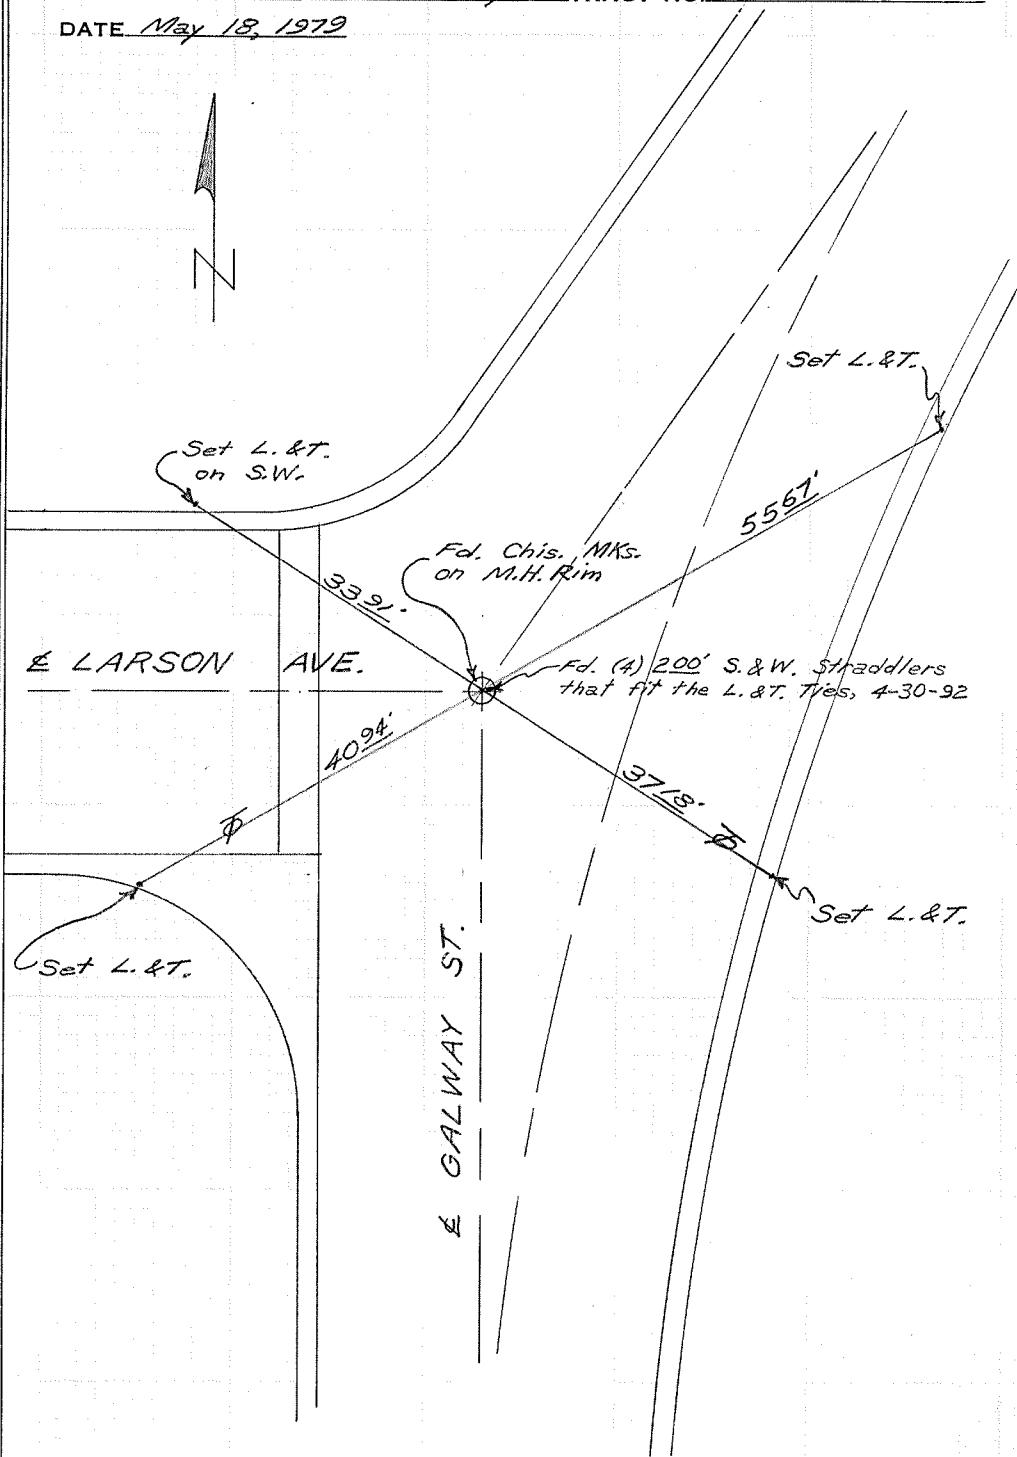

CITY OF GARDEN GROVE, CALIFORNIA

SURVEY OF LARSON AVE - W LINE TR. 1539^T B NO. 3 PAGE 127
SURVEY BY PRICKETT + PART^Y TRACT NO. 1539
DATE 5-18-79


DO NOT EXTEND NOTES THIS SIDE OF LINE

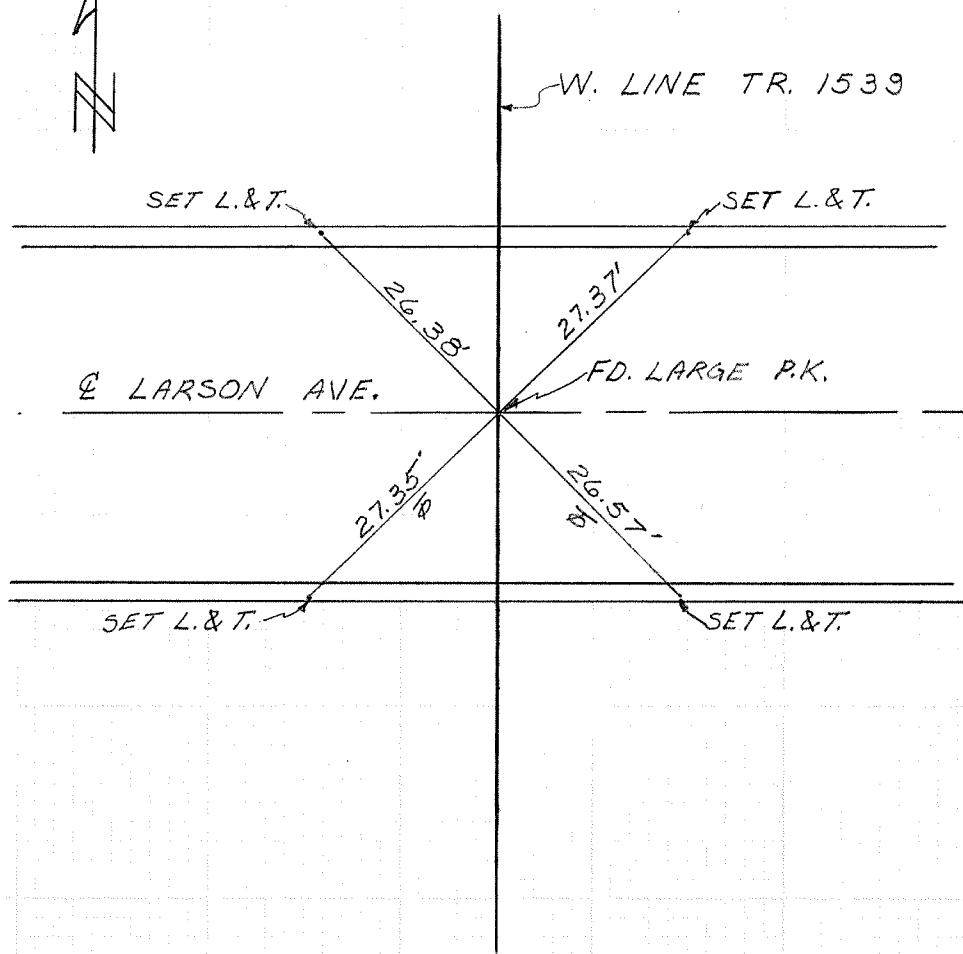

DO NOT EXTEND NOTES THIS SIDE OF LINE

CITY OF GARDEN GROVE, CALIFORNIA


SURVEY OF GALWAY ST + CROSBY AVE. T B NO. 3 PAGE 128
SURVEY BY PRICKETT + PART Y TRACT NO. 1539
DATE 5-18-79

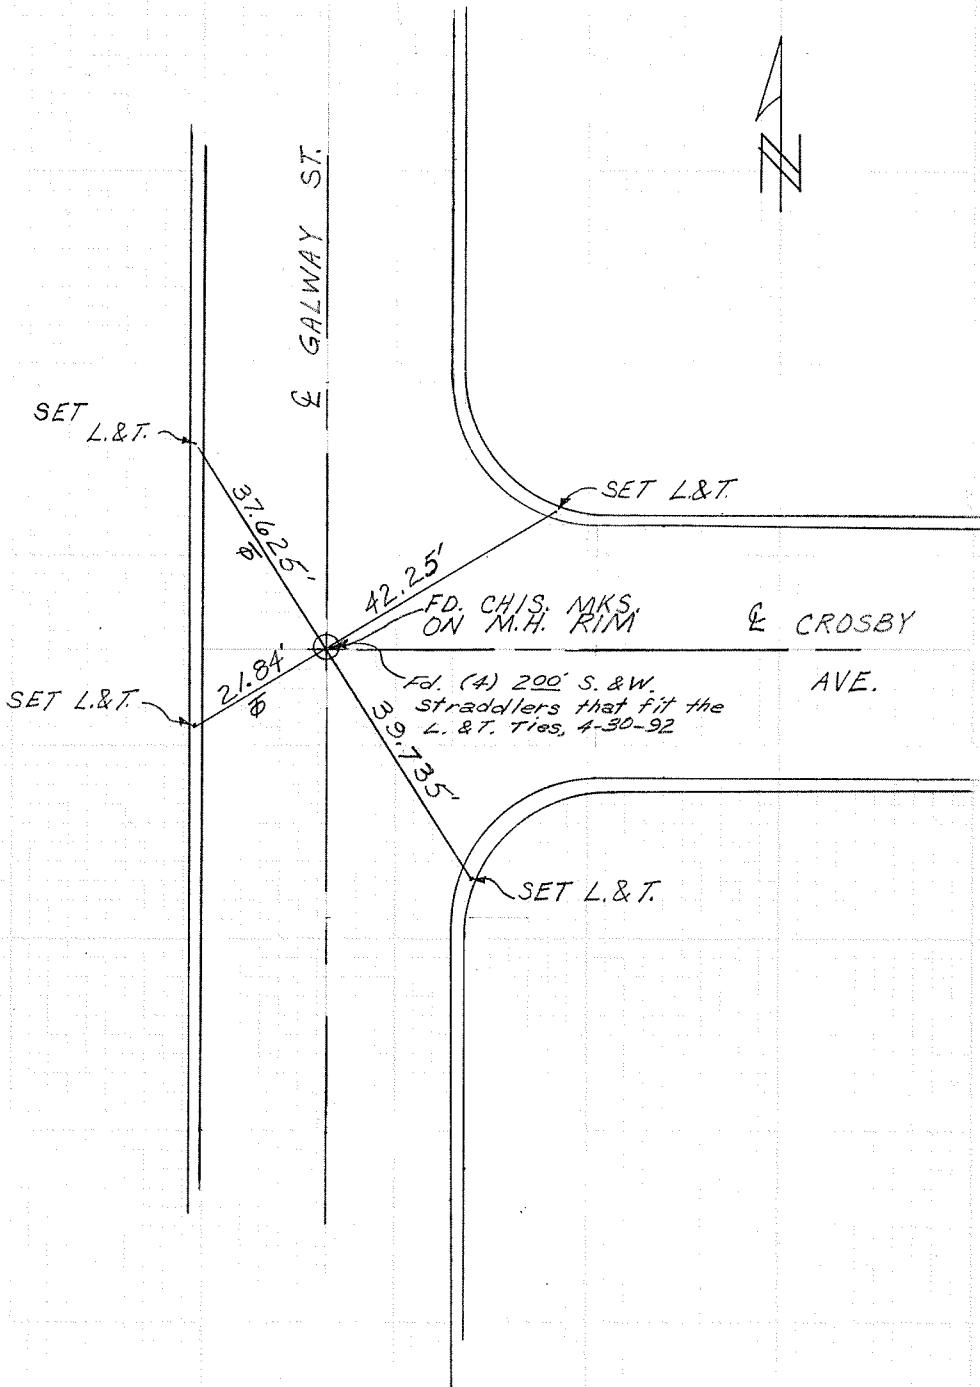

CITY OF GARDEN GROVE, CALIFORNIA

SURVEY OF Russell St. & Kerry St. TB NO. 3 PAGE 129
SURVEY BY Prickett & Party TRACT NO. 2030
DATE May 18, 1979

DO NOT EXTEND NOTES THIS SIDE OF LINE

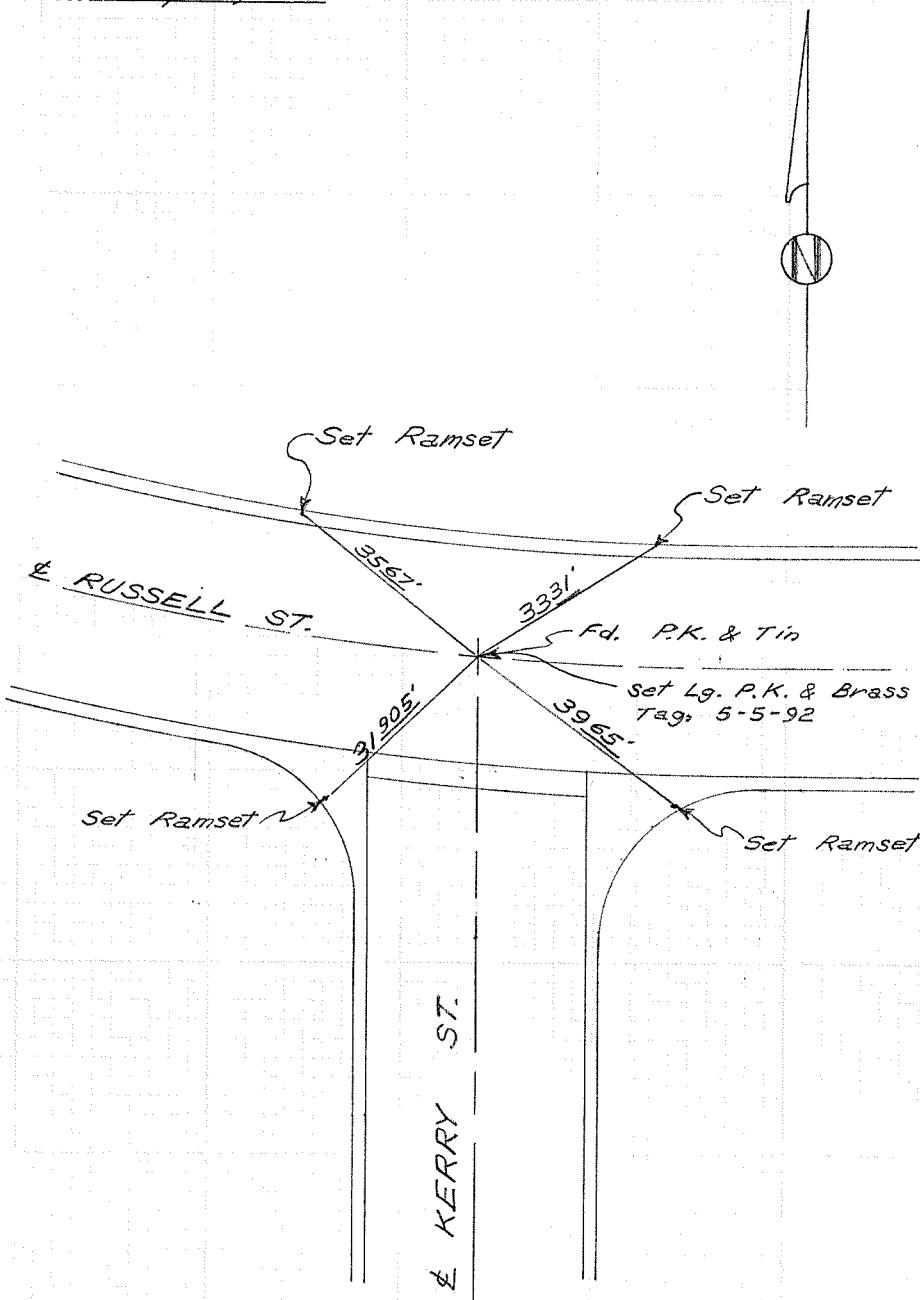


CITY OF GARDEN GROVE, CALIFORNIA

SURVEY OF DONEGAL DR + LUDERS AVE, T B NO. 3 PAGE 130
SURVEY BY PRICKETT + PARTY TRACT NO. 2030
DATE 5-21-79

SURVEYORS SERVICE COMPANY - OSTA MESA - STOCK NO. 411


DO NOT EXTEND NOTES THIS SIDE OF LINE

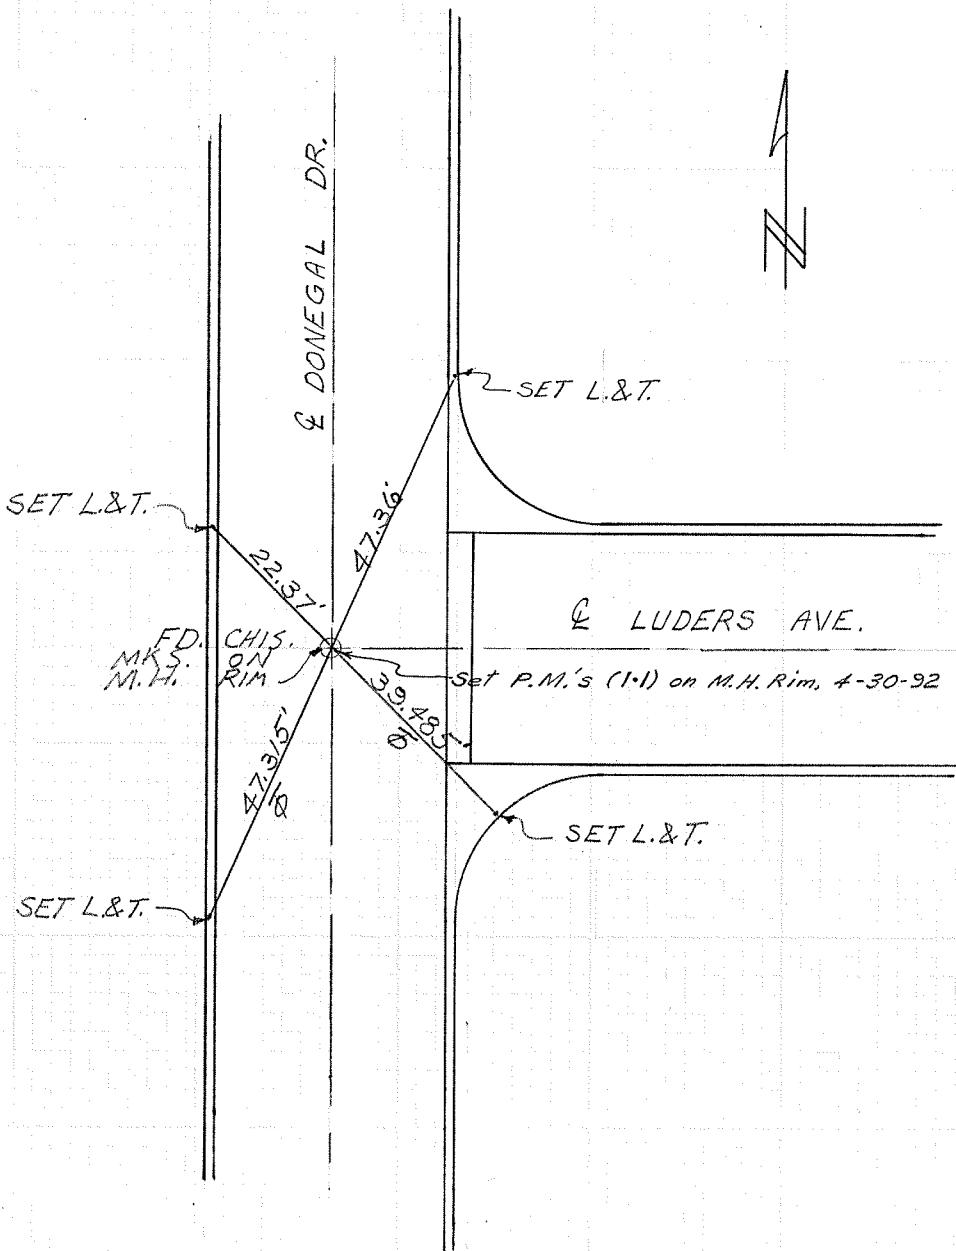

CITY OF GARDEN GROVE, CALIFORNIA

SURVEY OF DONEGAL & CENTRAL AVE B NO. 3 PAGE 131
SURVEY BY PRICKETT TRACT NO. 1165
DATE 5-21-79


DO NOT EXTEND NOTES THIS SIDE OF LINE

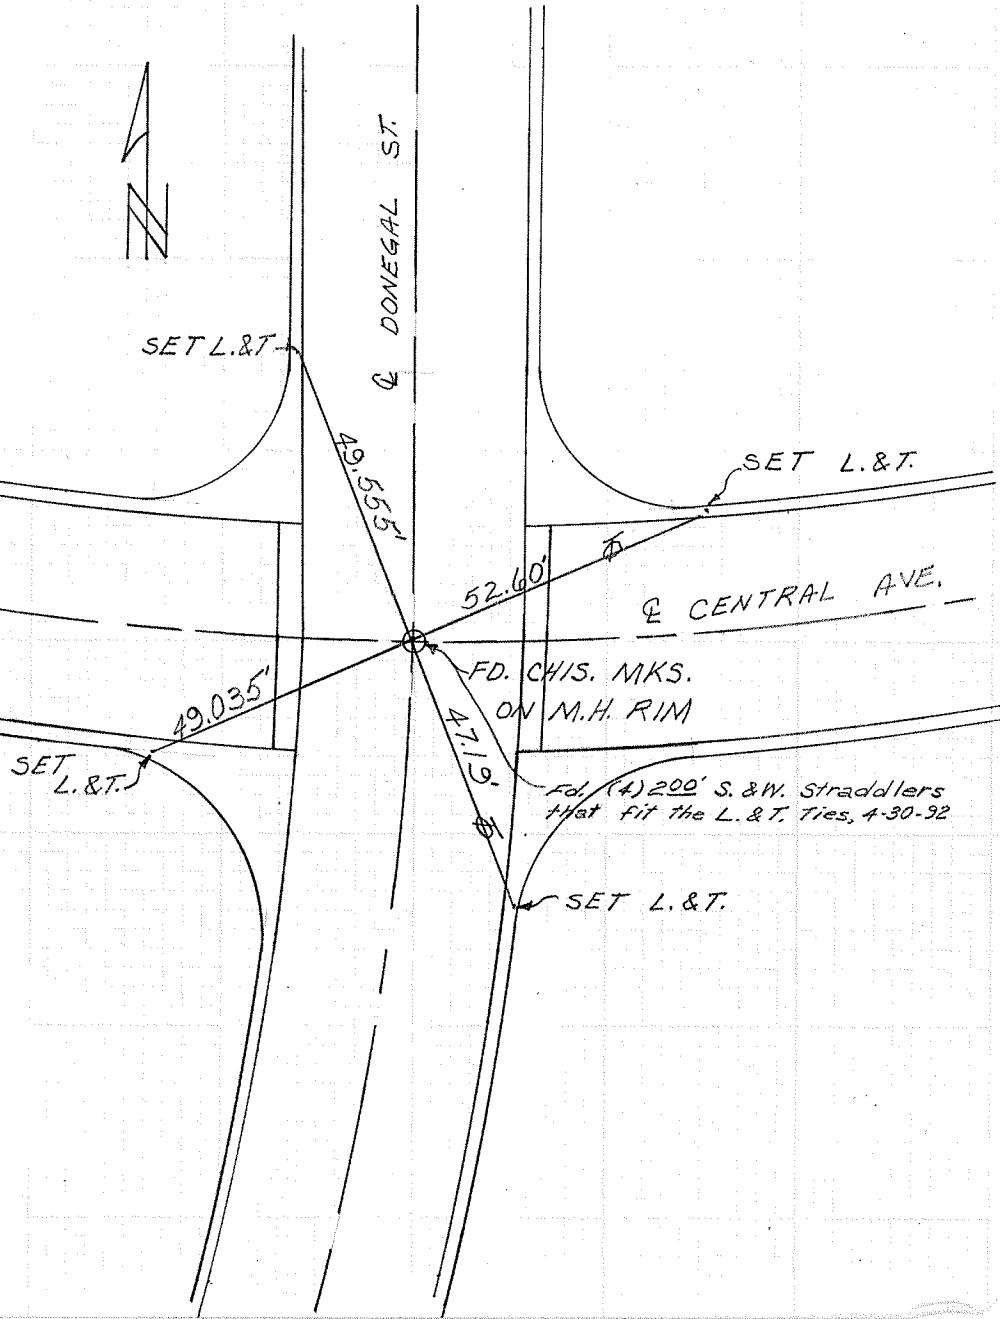

DO NOT EXTEND NOTES THIS SIDE OF LINE

CITY OF GARDEN GROVE, CALIFORNIA

SURVEY OF DONEGAL DR. + CROSBY AVE. T B NO. 3 PAGE 132
SURVEY BY PRICKETT + PARTY TRACT NO. 1165
DATE 5-21-79

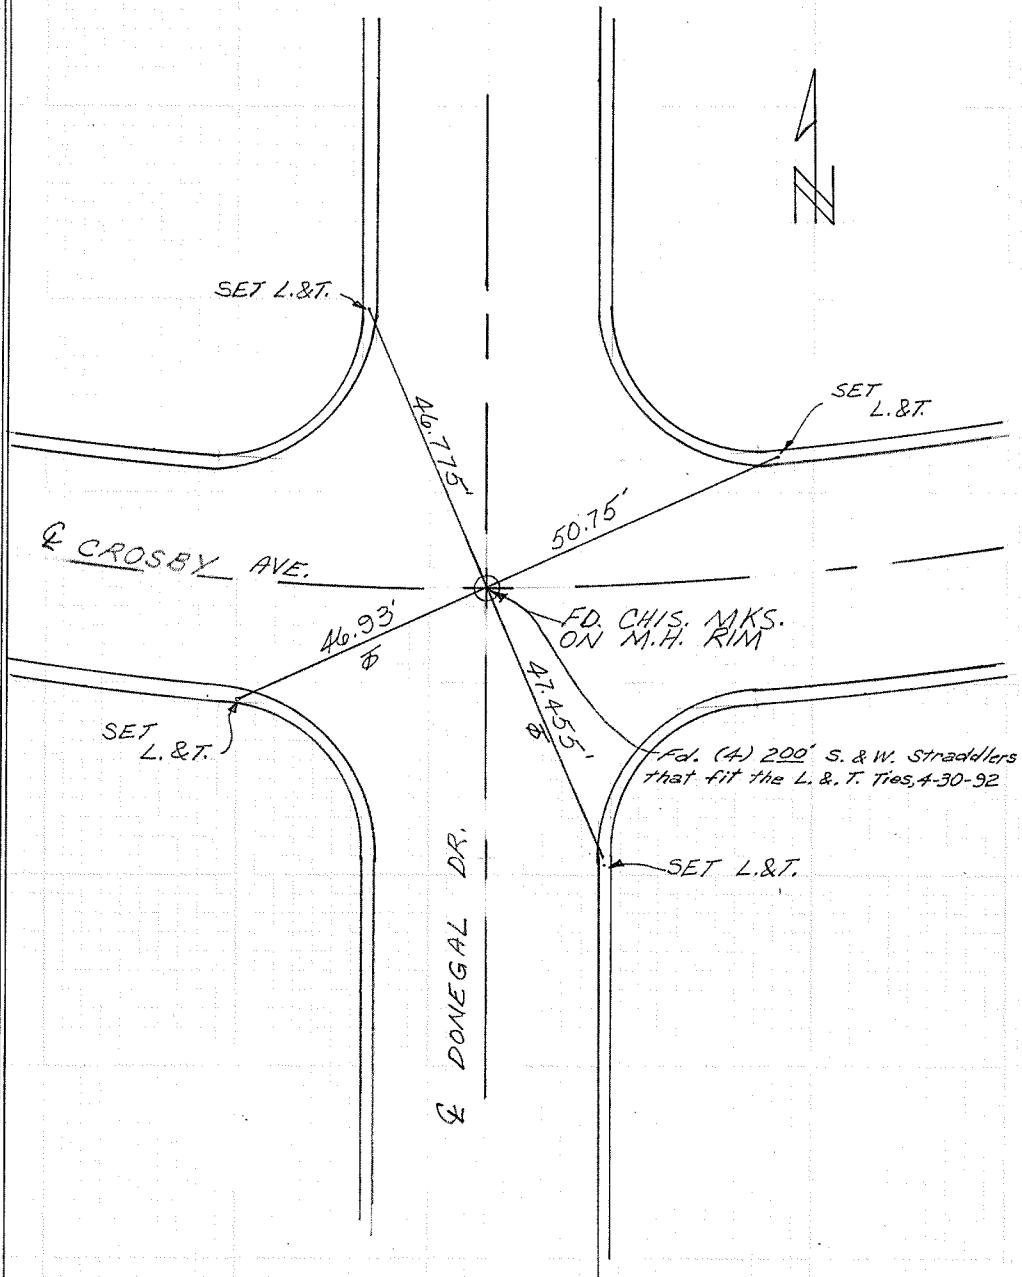


CITY OF GARDEN GROVE, CALIFORNIA

SURVEY OF BELFAST DR. & KERRY ST. B NO. 3 PAGE /33
SURVEY BY PRICKETT & PARTY TRACT NO. 1165
DATE 5-21-79

NOTE: Upon further investigation
the Chisel MKs. as found on the
M. H. Rim and tied out on May
21, 1979 have been found to have
no longer been valid at that time.

2-1-93, W.R.P.

DO NOT EXTEND NOTES THIS SIDE OF LINE

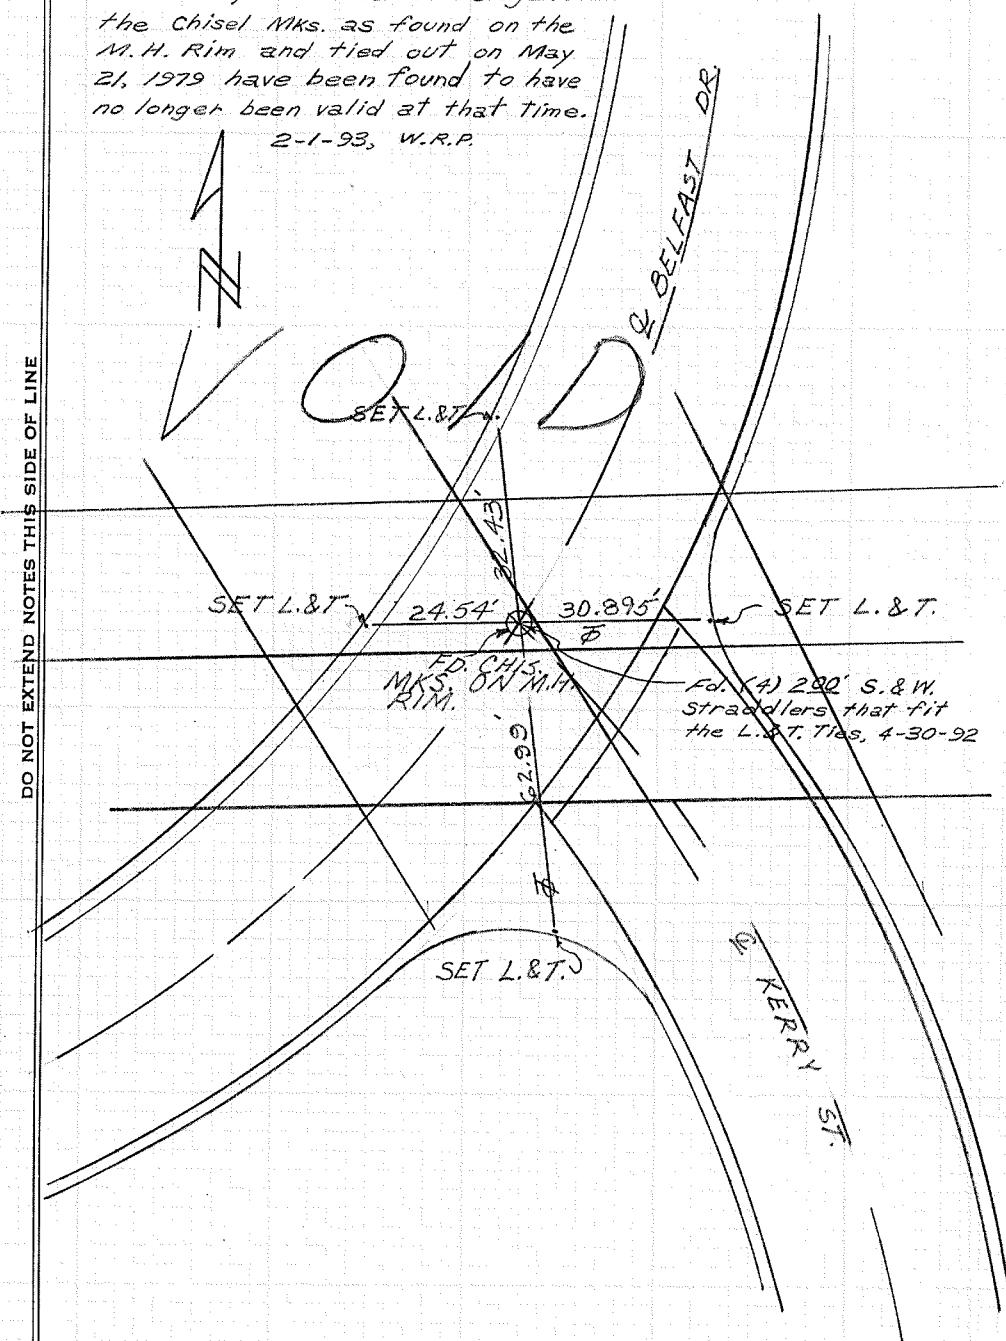


CITY OF GARDEN GROVE, CALIFORNIA

SURVEY OF KERRY ST. & CENTRAL AVE. T B NO. 3 PAGE 134
SURVEY BY PRICKETT + PARTY TRACT NO. 1165
DATE 5-22-79

DO NOT EXTEND NOTES THIS SIDE OF LINE

SURVEYORS SERVICE COMPANY COSTA MESA - STOCK NO. 411

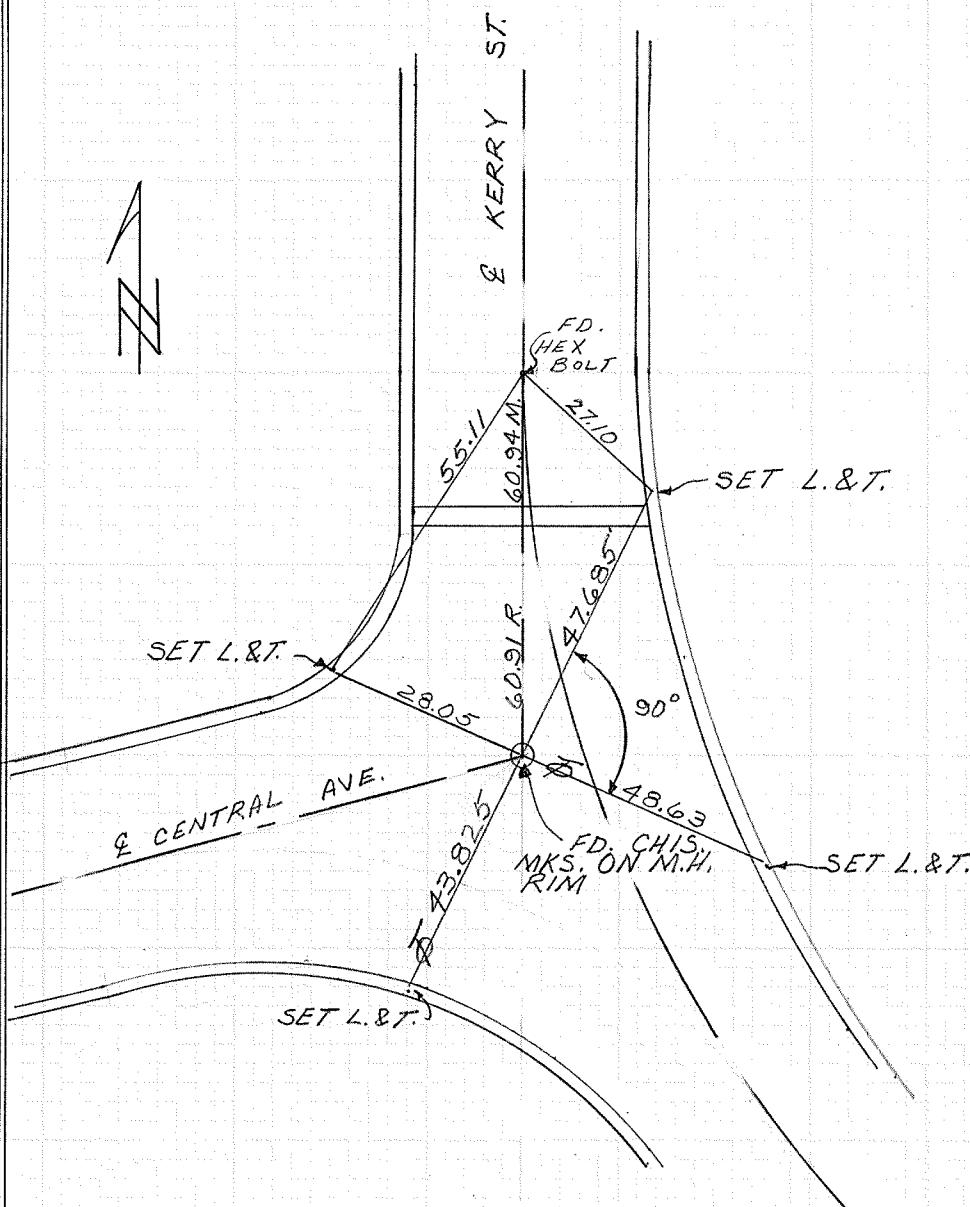

CITY OF GARDEN GROVE, CALIFORNIA

SURVEY OF Kerry St. & Central Ave.

T B NO. 3 PAGE 134A


SURVEY BY Prickett & Party

TRACT NO. 1165

DATE May 5, 1992

DO NOT EXTEND NOTES THIS SIDE OF LINE

SURVEYORS SERVICE COMPANY, TA MESA - STOCK NO. 411

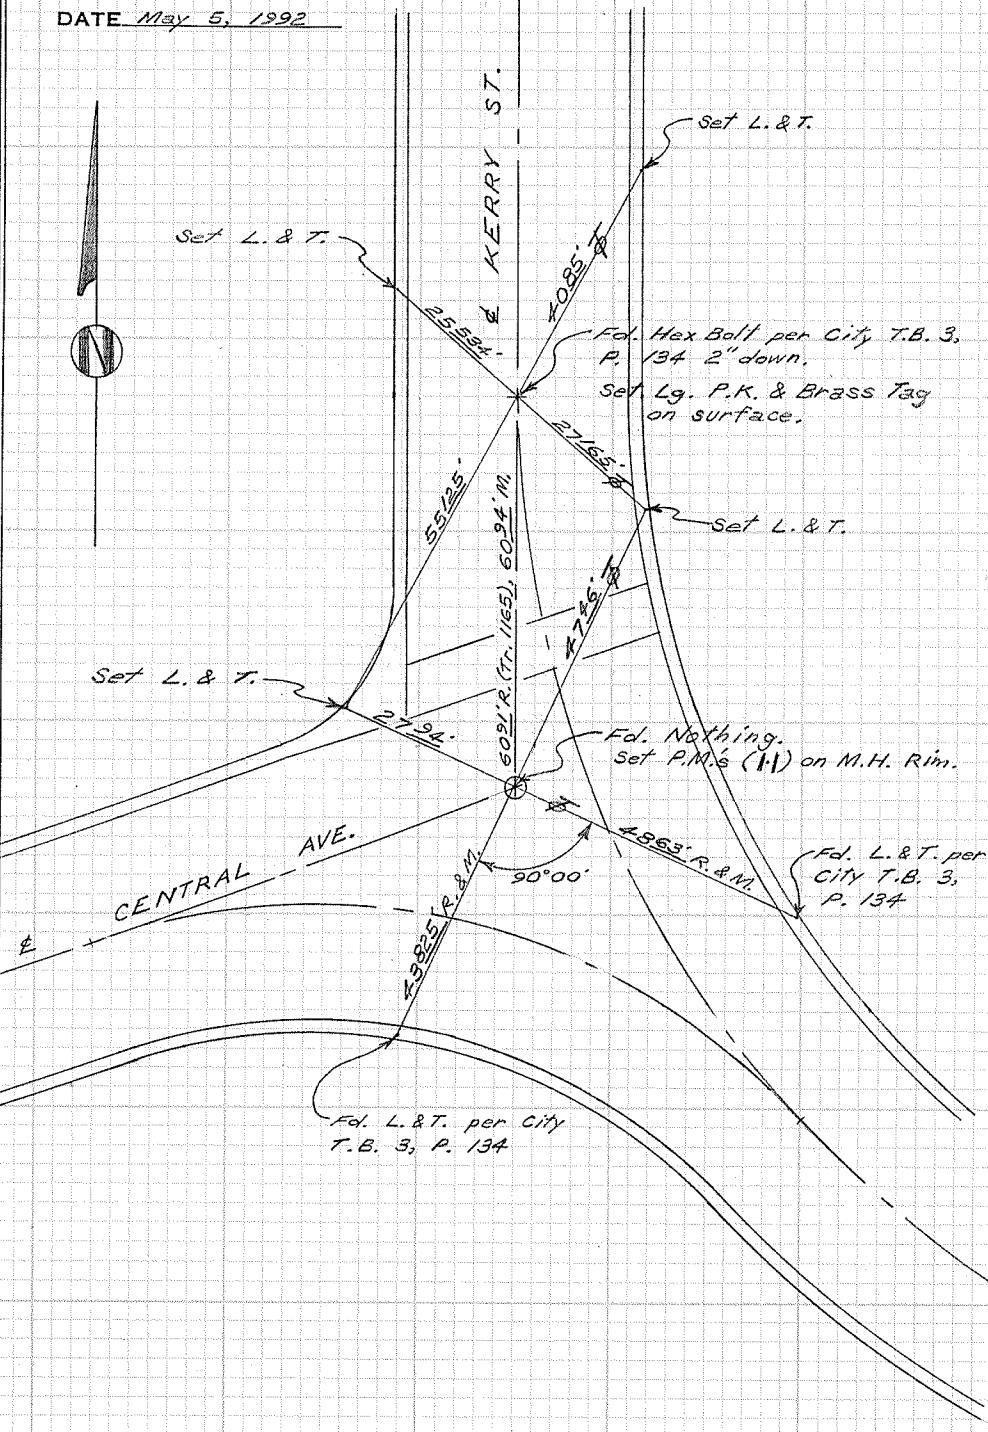


CITY OF GARDEN GROVE, CALIFORNIA

SURVEY OF MILLS RD. AND LINNELL AVE.
T B NO 3 PAGE 135
SURVEY BY PRICKETT + PARTY TRACT NO. 2433
DATE 5-23-79

DO NOT EXTEND NOTES THIS SIDE OF LINE

SURVEYORS SERVICE COMPANY COSTA MESA - STOCK NO. 411

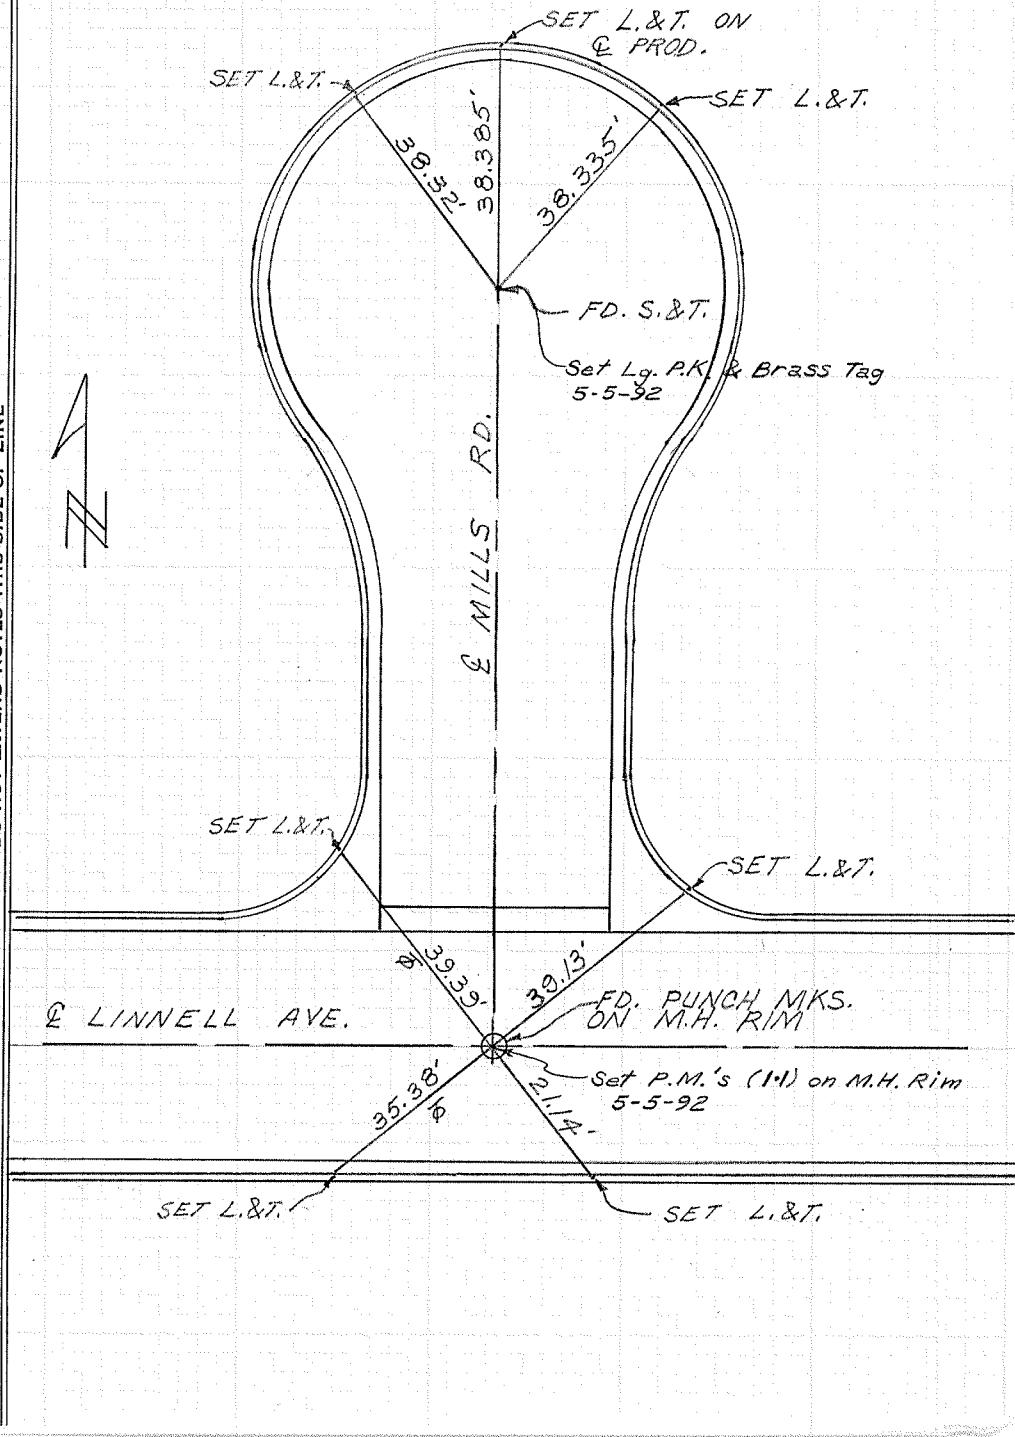


CITY OF GARDEN GROVE, CALIFORNIA

RD.
SURVEY OF LINNELL AVE. & LOMBARDY T B NO. 3 PAGE 136
SURVEY BY PRICKETT + PARTY TRACT NO. 2433
DATE 5-23-79

DO NOT EXTEND NOTES THIS SIDE OF LINE


SURVEYORS SERVICE COMPANY - COSTA MESA - STOCK NO. 411

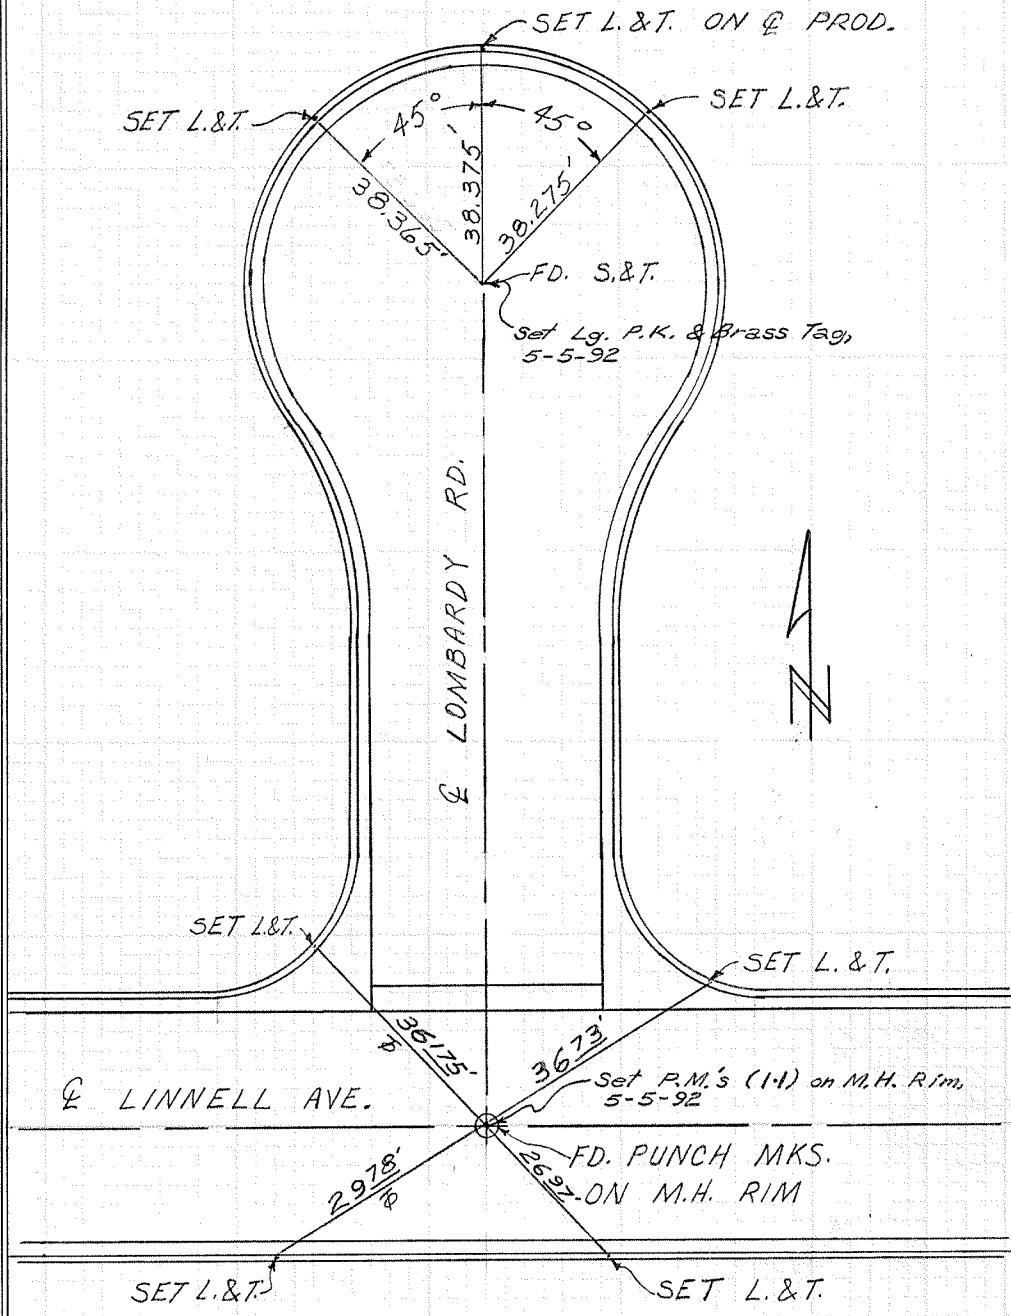

CITY OF GARDEN GROVE, CALIFORNIA

SURVEY OF FERNWOOD DR AND RANNEY AVE. T B NO. 3 PAGE 137
SURVEY BY PRICKETT + PARTY TRACT NO. 2433
DATE 5-24-79


DO NOT EXTEND NOTES THIS SIDE OF LINE

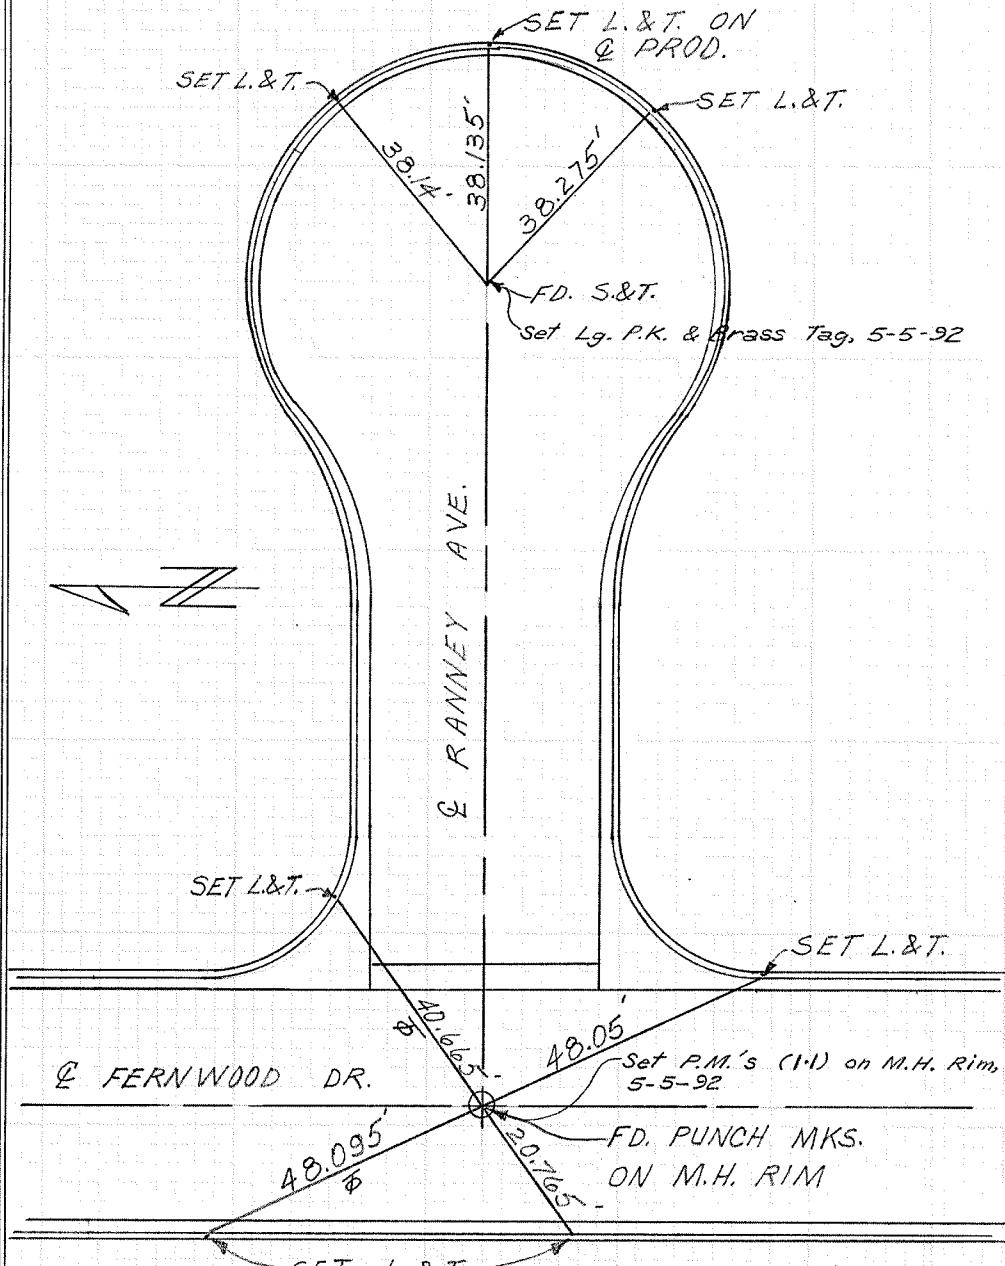

CITY OF GARDEN GROVE, CALIFORNIA

SURVEY OF LINNELL DR. & FERNWOOD DR. T B NO. 3 PAGE 138
SURVEY BY PRICKETT + PARTY TRACT NO. 2433
DATE 5-24-79


DO NOT EXTEND NOTES THIS SIDE OF LINE

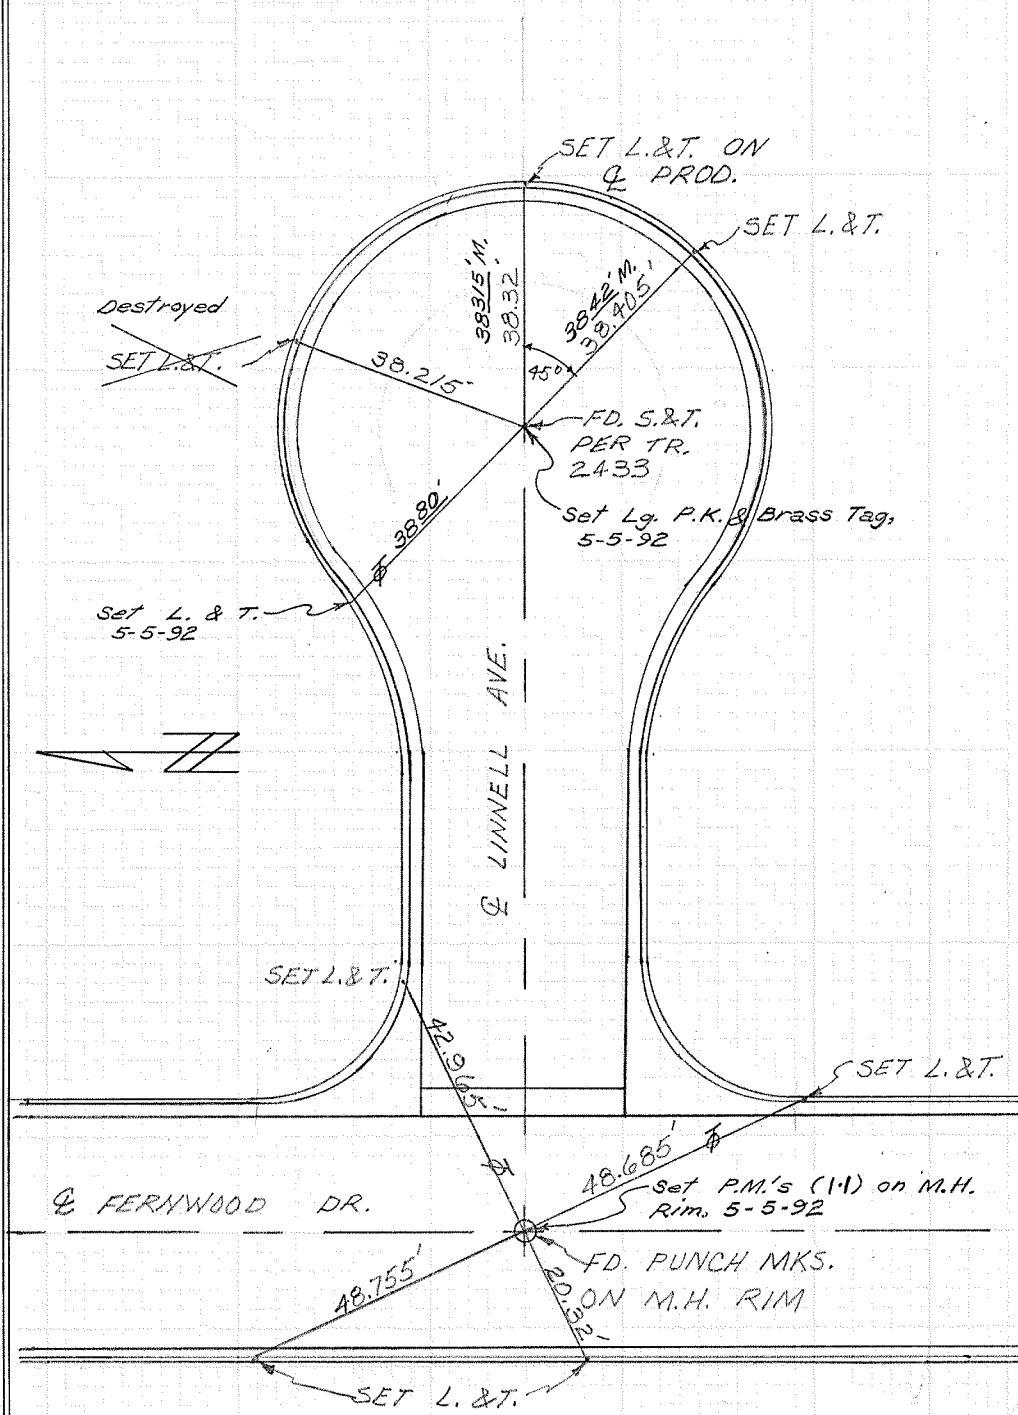

CITY OF GARDEN GROVE, CALIFORNIA

AVE.
SURVEY OF FERNWOOD DR. + LINNELL T B NO. 3 PAGE 139
SURVEY BY PRICKETT + PARTY TRACT NO. 2433
DATE 5-24-79


DO NOT EXTEND NOTES THIS SIDE OF LINE

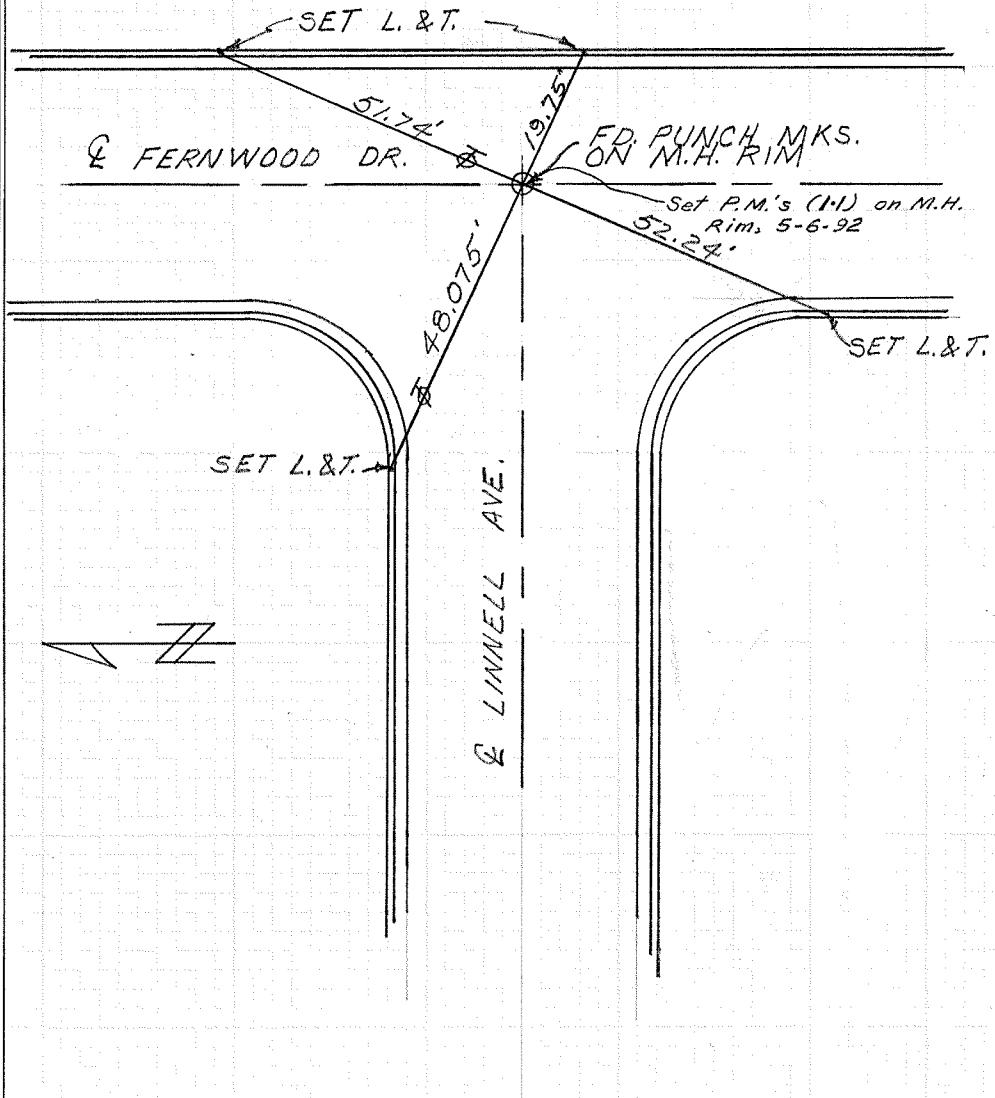

CITY OF GARDEN GROVE, CALIFORNIA

AVE
SURVEY OF FERNWOOD DR. + MANSOR T B NO. 3 PAGE 140
SURVEY BY PRICKETT + PARTY TRACT NO. 2433
DATE 5-24-79

DO NOT EXTEND NOTES THIS SIDE OF LINE

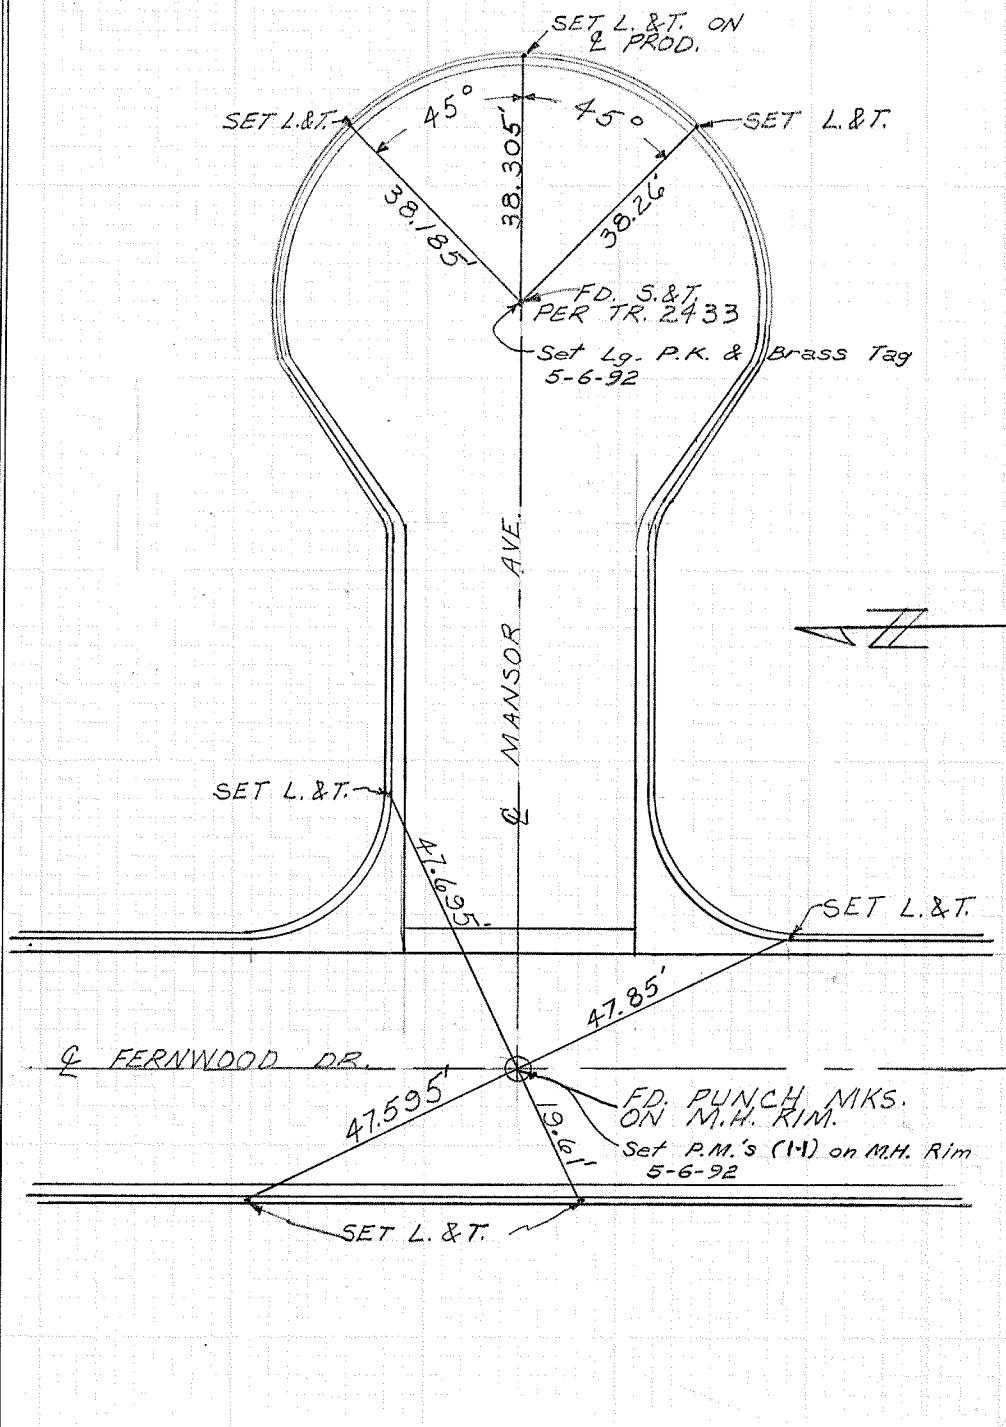


SURVEYORS SERVICE COMPANY OSTA MESA - STOCK NO. 411

CITY OF GARDEN GROVE, CALIFORNIA

SURVEY OF BLAKE ST. + ALLEY T B NO. 3 PAGE 141
SURVEY BY PRICKETT + PARTY TRACT NO. 2433
DATE 5-25-79

DO NOT EXTEND NOTES THIS SIDE OF LINE

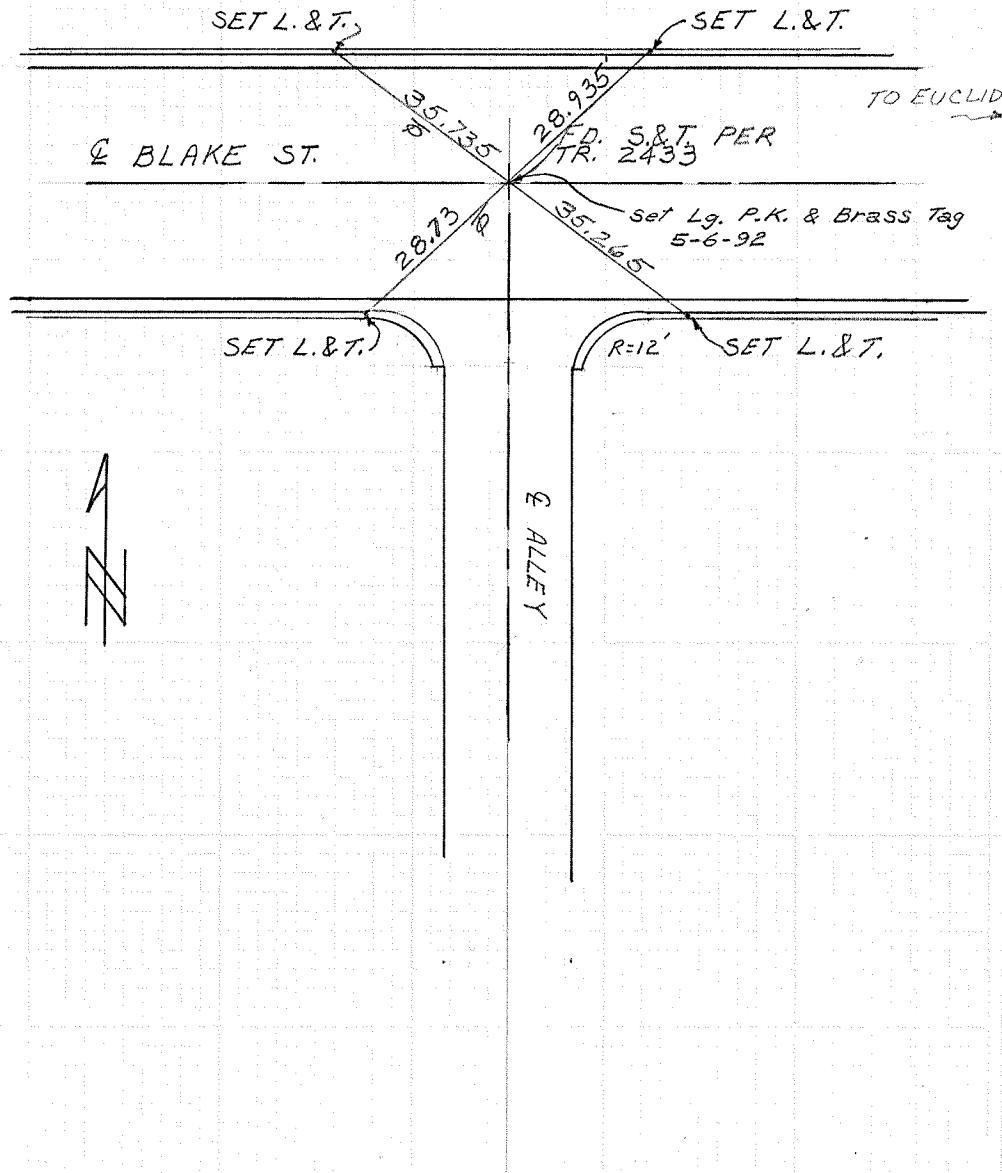


CITY OF GARDEN GROVE, CALIFORNIA

SURVEY OF BLAKE ST + FERNWOOD DR T B NO. 3 PAGE 142
SURVEY BY PRICKETT + PARTY TRACT NO. 2433
DATE 5-25-79

SURVEYORS SERVICE COMPANY OSTA MESA - STOCK NO. 411

DO NOT EXTEND NOTES THIS SIDE OF LINE

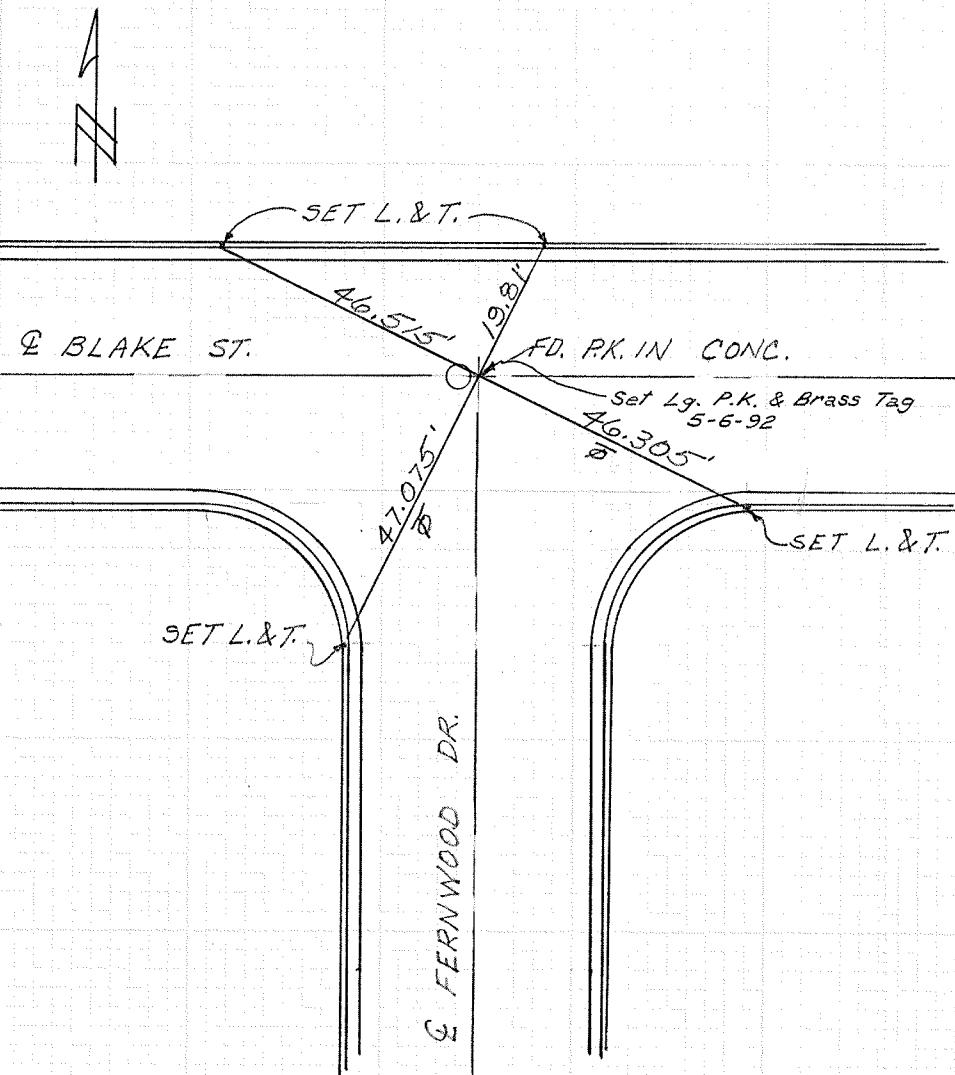


CITY OF GARDEN GROVE, CALIFORNIA

SURVEY OF BLAKE ST. 8 1/2 W. OF FERNWOOD T B NO. 3 PAGE 143
SURVEY BY PRICKETT + PARTY TRACT NO. 2433
DATE 5-25-79

SURVEYORS SERVICE COMPANY COSTA MESA - STOCK NO. 411

DO NOT EXTEND NOTES THIS SIDE OF LINE

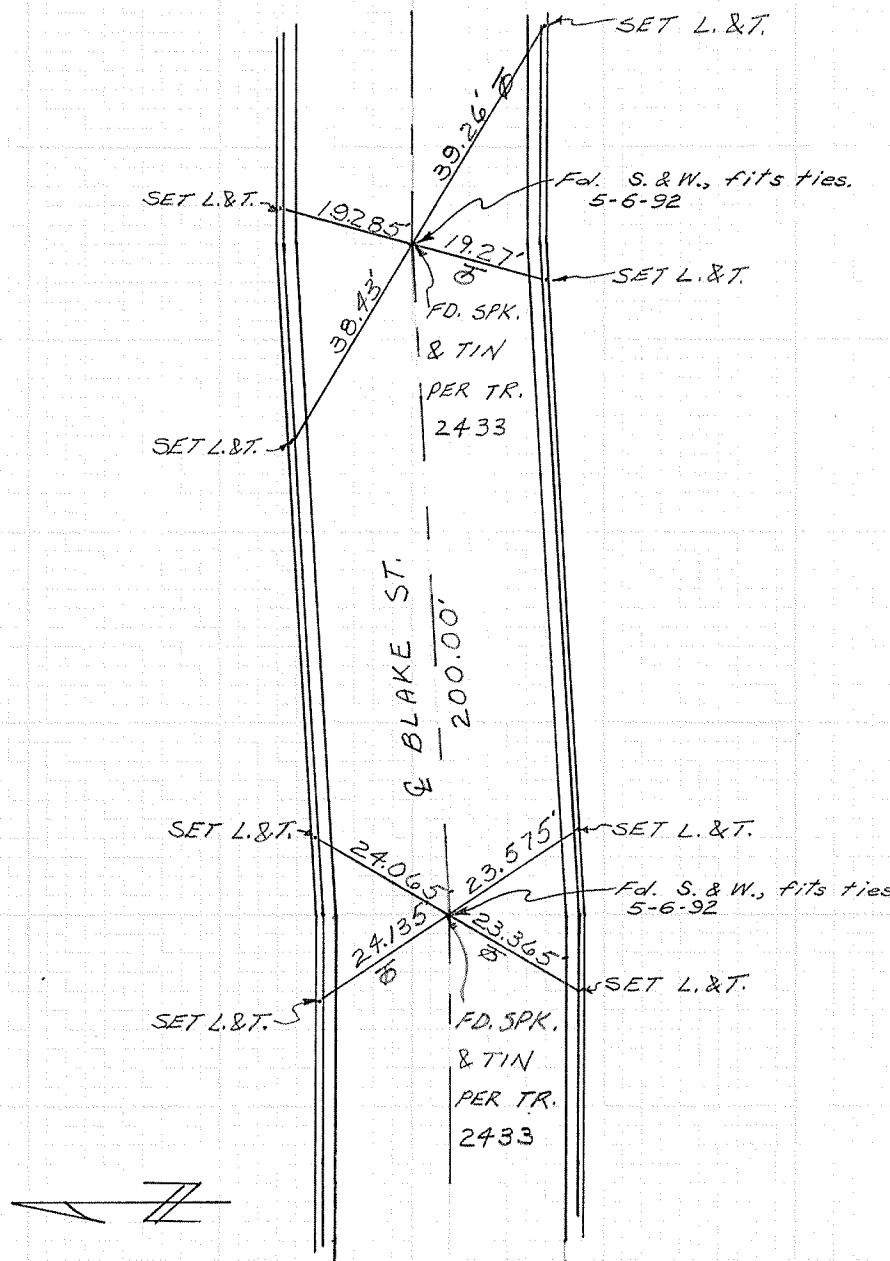


CITY OF GARDEN GROVE, CALIFORNIA

SURVEY OF WOODBURY RD. & MILLS T B NO. 3 PAGE 144
SURVEY BY PRICKETT + PARTY TRACT NO. 1626
DATE 5-29-79

SURVEYORS SERVICE COMPANY OSTA MESA - STOCK NO. 411

DO NOT EXTEND NOTES THIS SIDE OF LINE

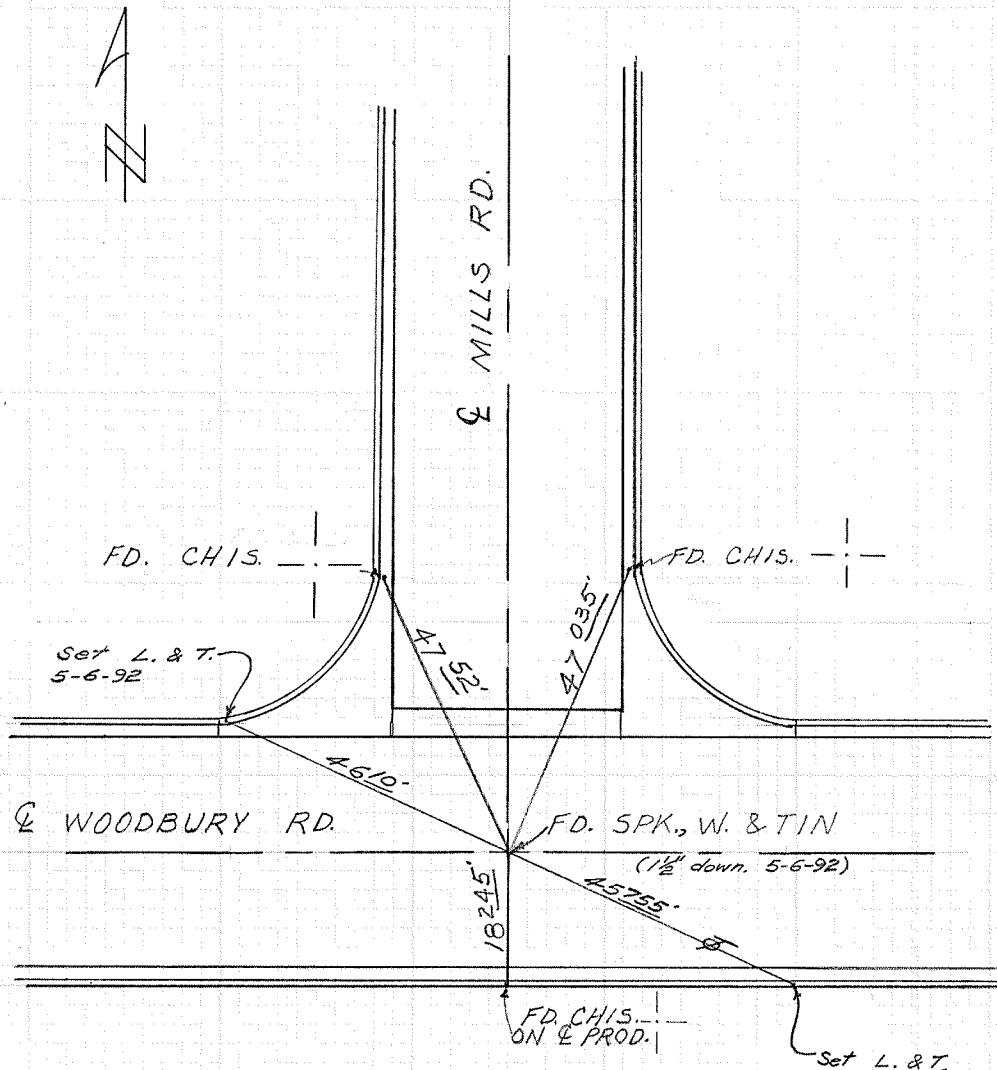


Set L. & T.
5-6-92

CITY OF GARDEN GROVE, CALIFORNIA

SURVEY OF Woodbury & Alley W. of Euclid TB NO. 3 PAGE 145
SURVEY BY Prickett & Party TRACT NO. 1626
DATE May 29, 1979


DO NOT EXTEND NOTES THIS SIDE OF LINE

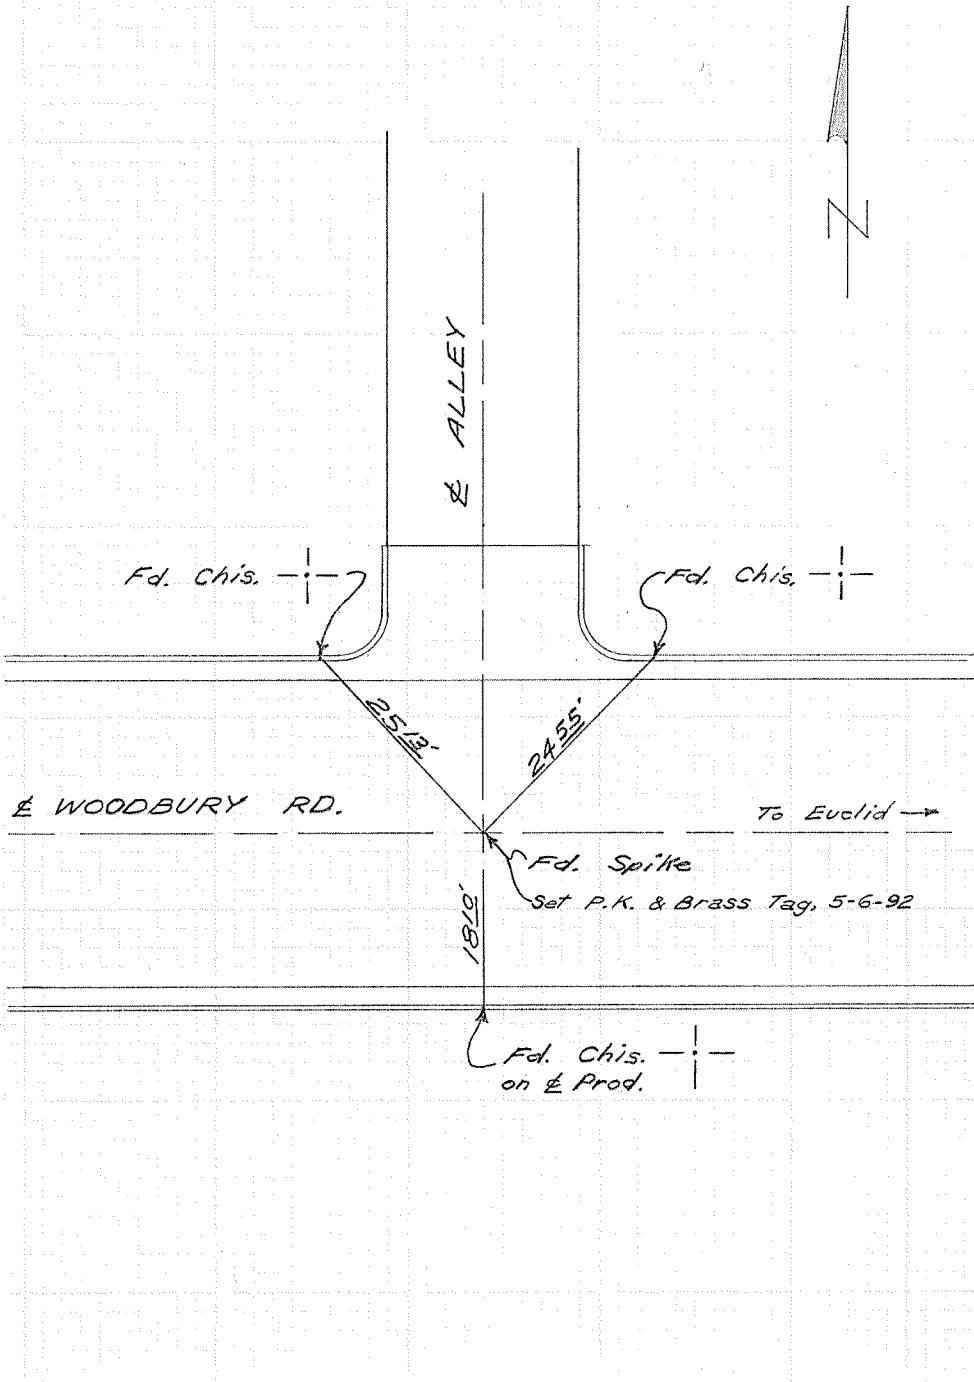

CITY OF GARDEN GROVE, CALIFORNIA

SURVEY OF MILLS RD. AT GAINES CIRCLE + LOMBARDY RD.
B NO. 3 PAGE 146
SURVEY BY PRICKETT + PARTY TRACT NO. 1626
DATE 5-29-79

DO NOT EXTEND NOTES THIS SIDE OF LINE

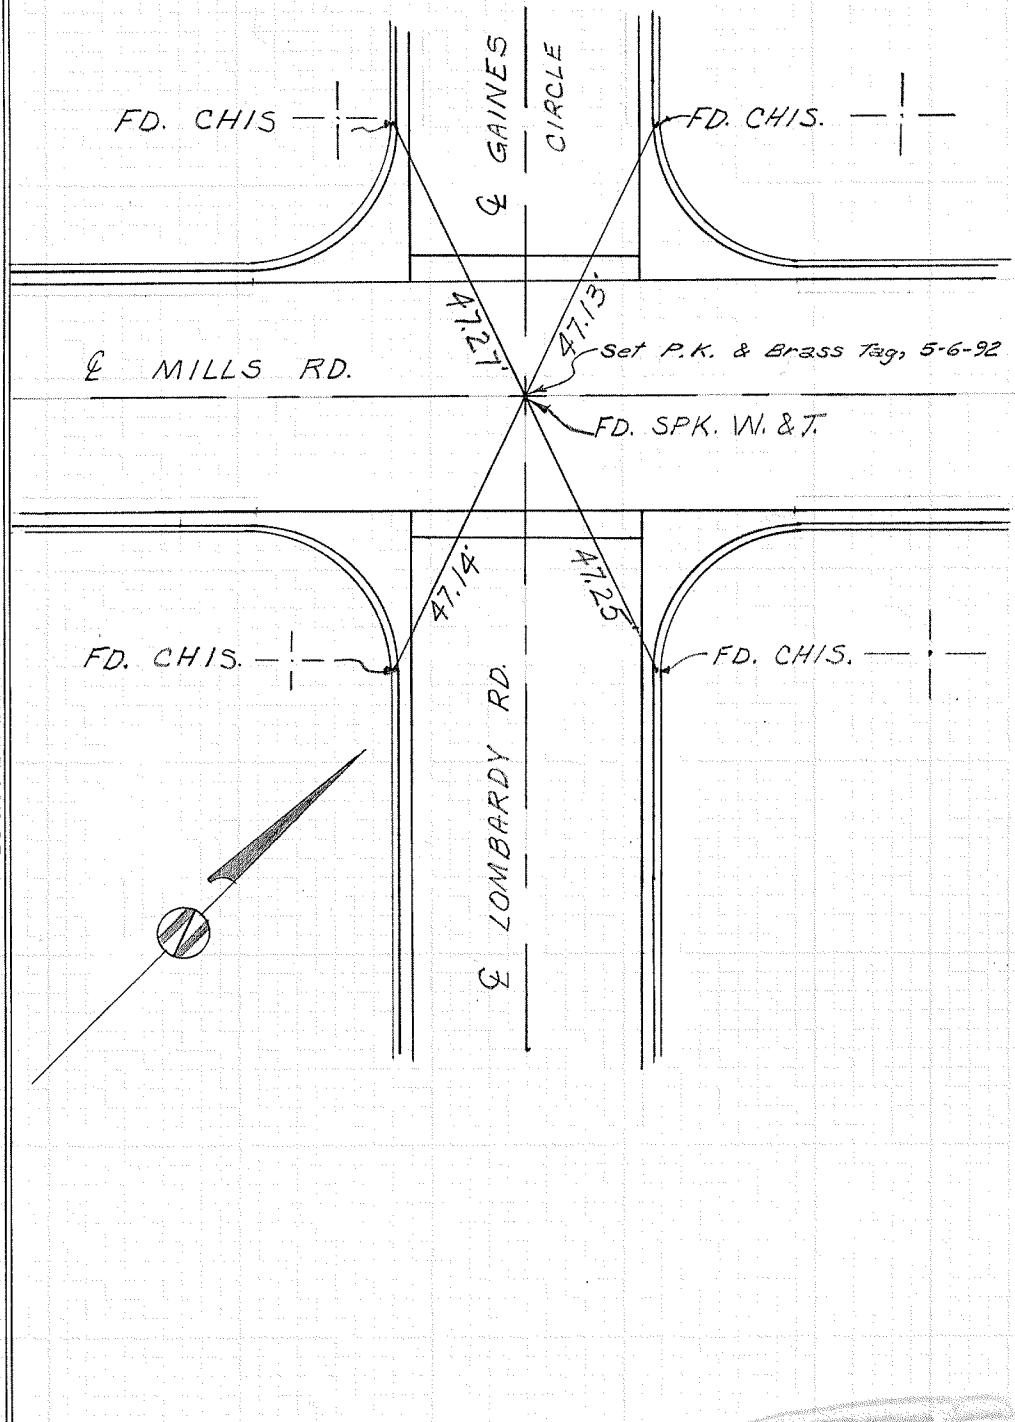


CITY OF GARDEN GROVE, CALIFORNIA

SURVEY OF LOMBARDY RD. (P.I. S.OF MILLS RD.) B NO. 3 PAGE 147
SURVEY BY PRICKETT, KOENINGS, RAY TRACT NO. 1626
DATE 5-29-79

MILLS RD.

DO NOT EXTEND NOTES THIS SIDE OF LINE

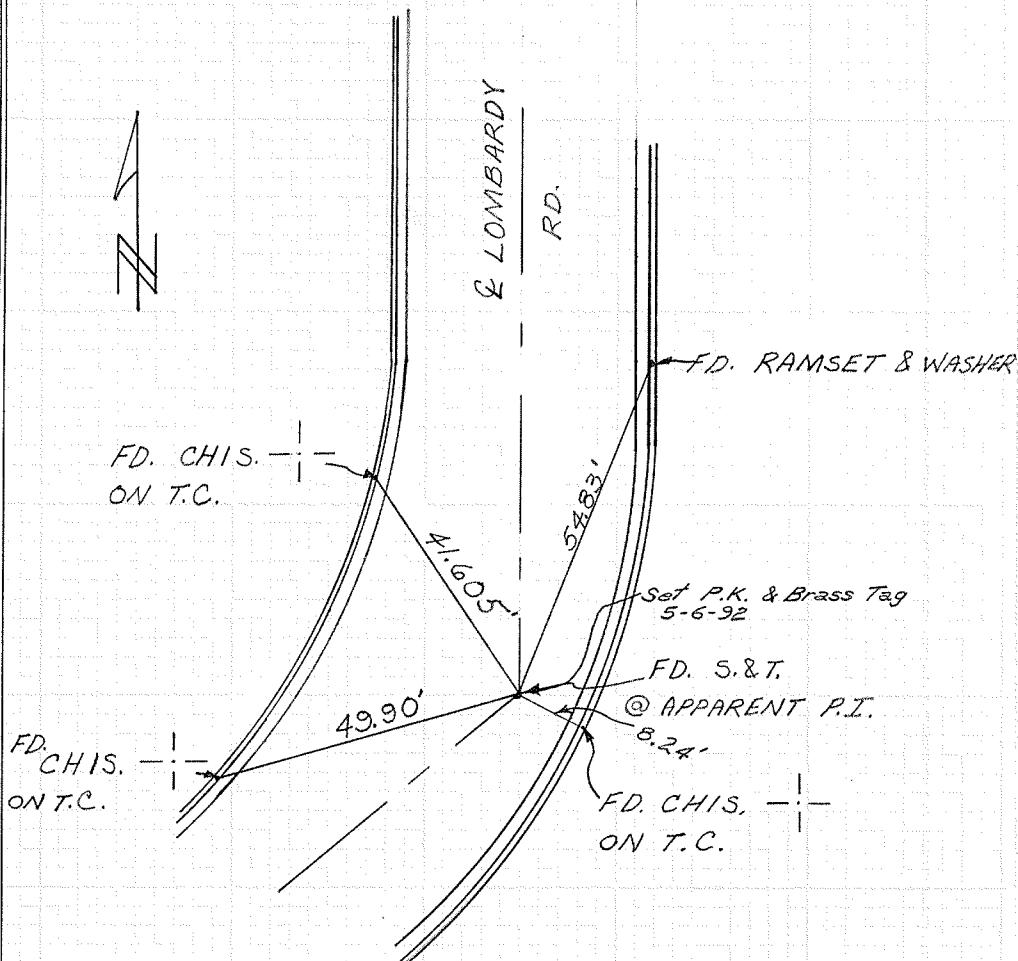


CITY OF GARDEN GROVE, CALIFORNIA

SURVEY OF FERNWOOD DR. S.OF MILLS RD. T B NO. 3 PAGE 148
SURVEY BY PRICKETT + PARTY TRACT NO. 1626
DATE 5-29-79 MILLS RD.

SURVEYORS SERVICE COMPANY - COSTA MESA - STOCK NO. 411


DO NOT EXTEND NOTES THIS SIDE OF LINE

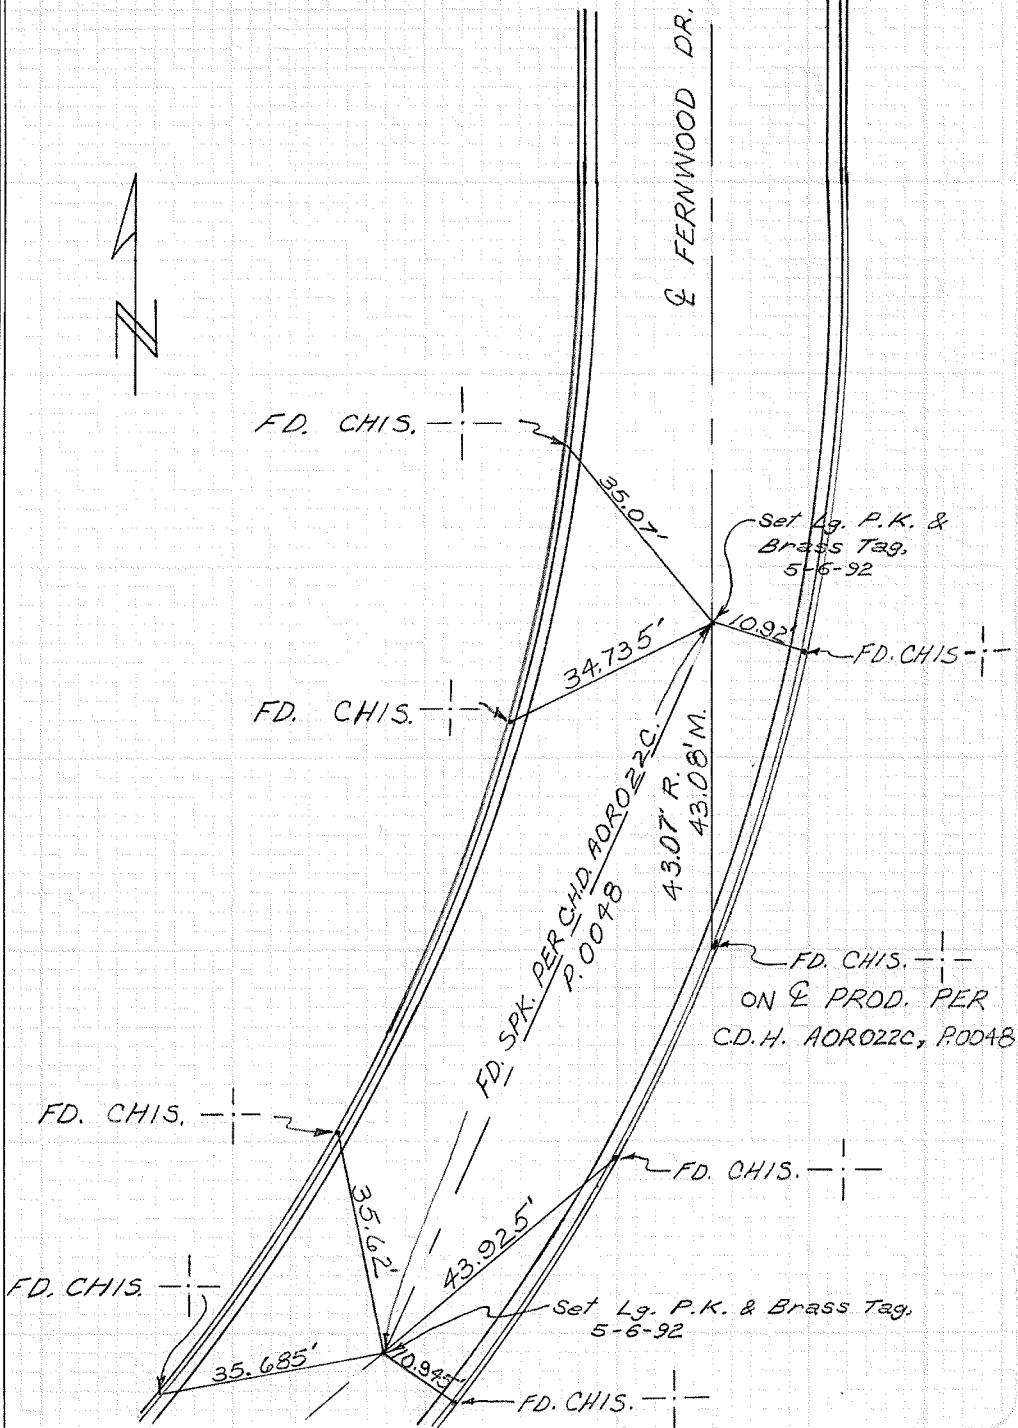

CITY OF GARDEN GROVE, CALIFORNIA

SURVEY OF ALDGATE + SONGISH T B NO 3 PAGE 149
SURVEY BY PRICKETT + PARTY TRACT NO. 2046
DATE 5-30-79


DO NOT EXTEND NOTES THIS SIDE OF LINE

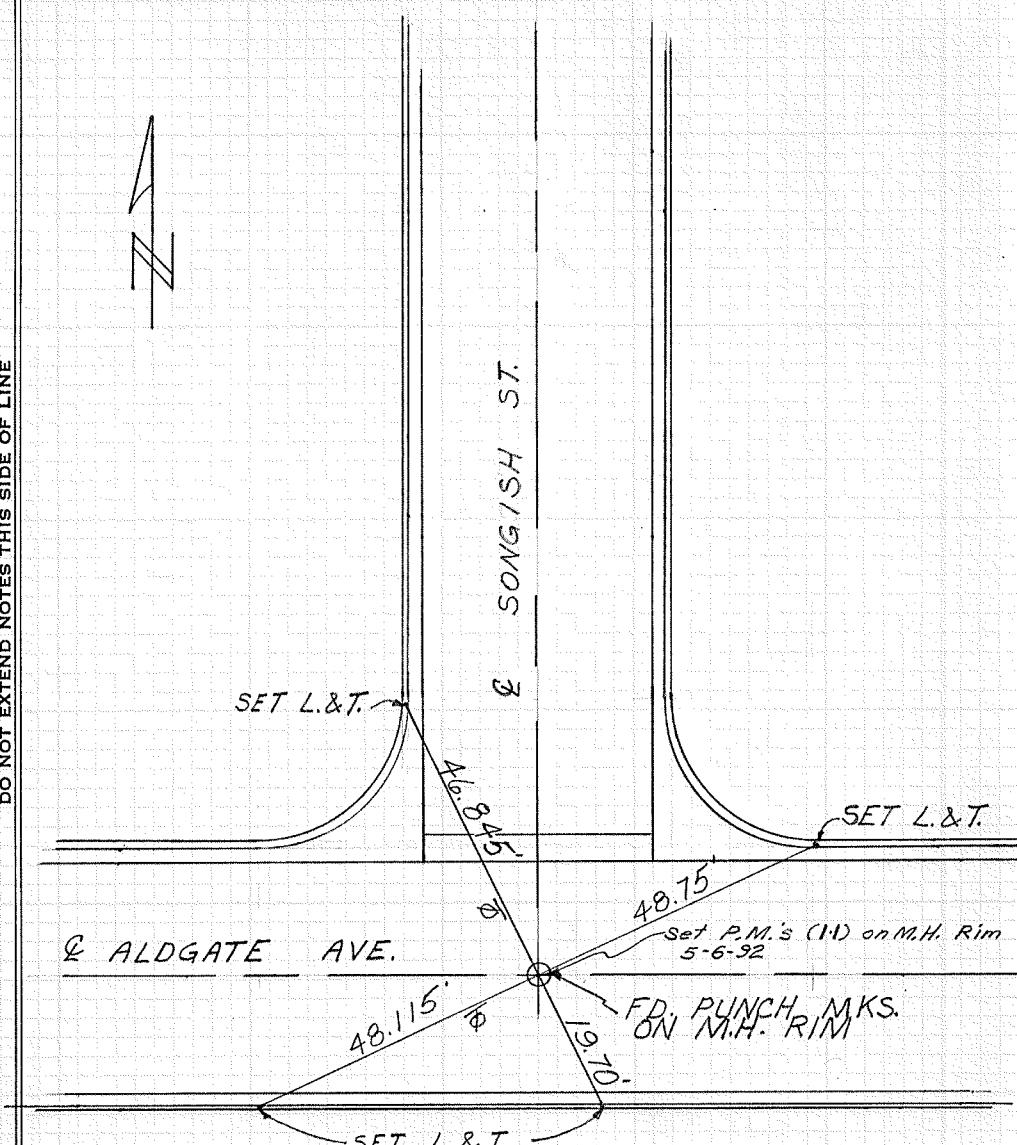

CITY OF GARDEN GROVE, CALIFORNIA

SURVEY OF Anaconda & Western TB NO. 3 PAGE 150
SURVEY BY Prickett & Party TRACT NO.
DATE August 20, 1979


DO NOT EXTEND NOTES THIS SIDE OF LINE

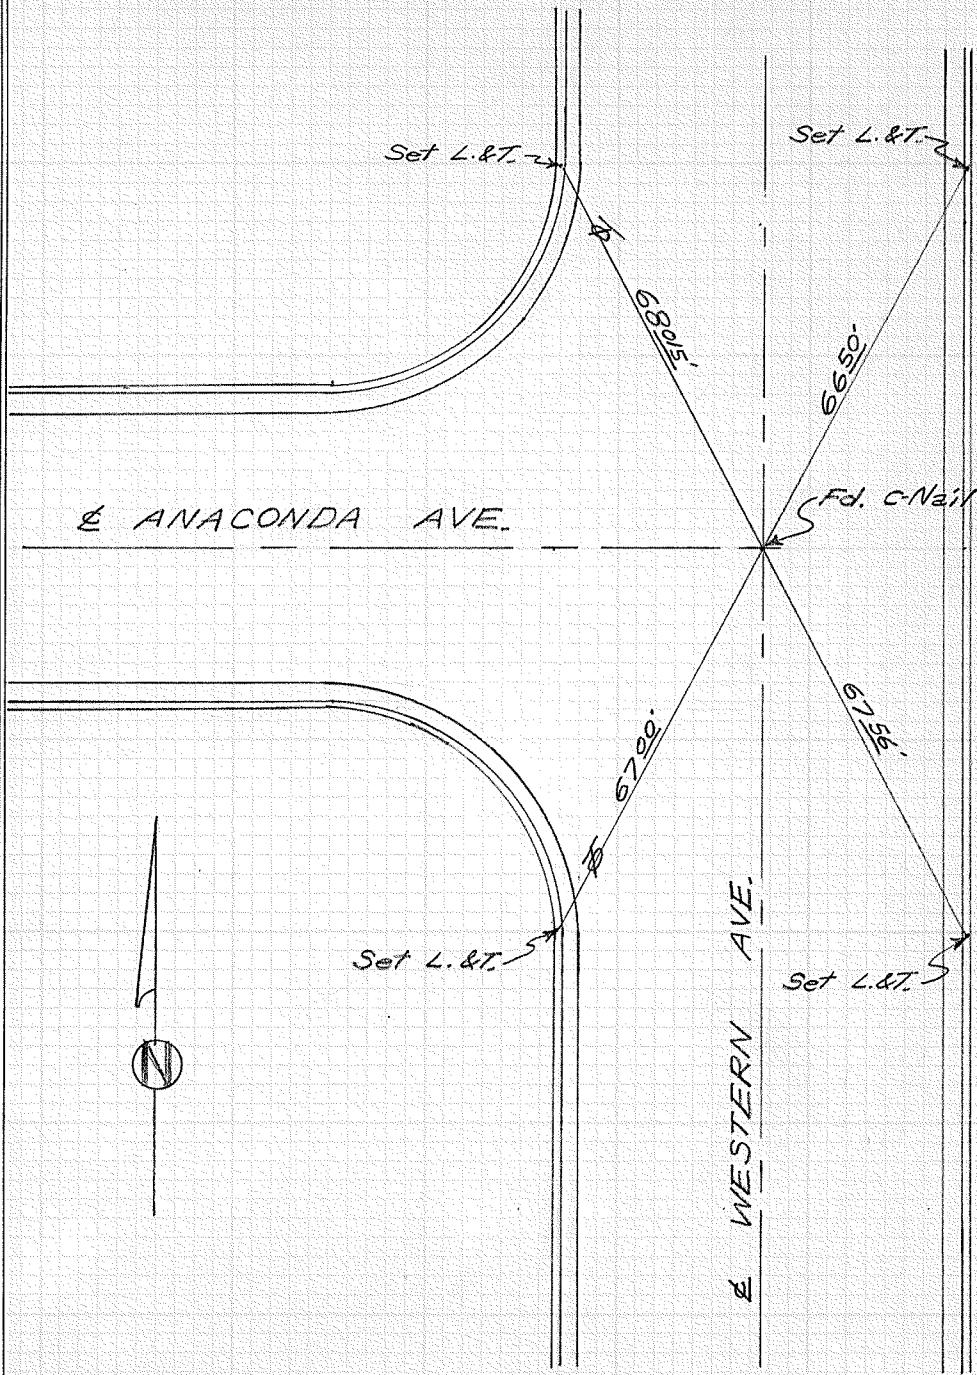

CITY OF GARDEN GROVE, CALIFORNIA

SURVEY OF ACACIA & CIVIC CENTER DR. T B NO. 3 PAGE 23
SURVEY BY PRICKETT & PARTY TRACT NO.
DATE FEB 23 1972


DO NOT EXTEND NOTES THIS SIDE OF LINE

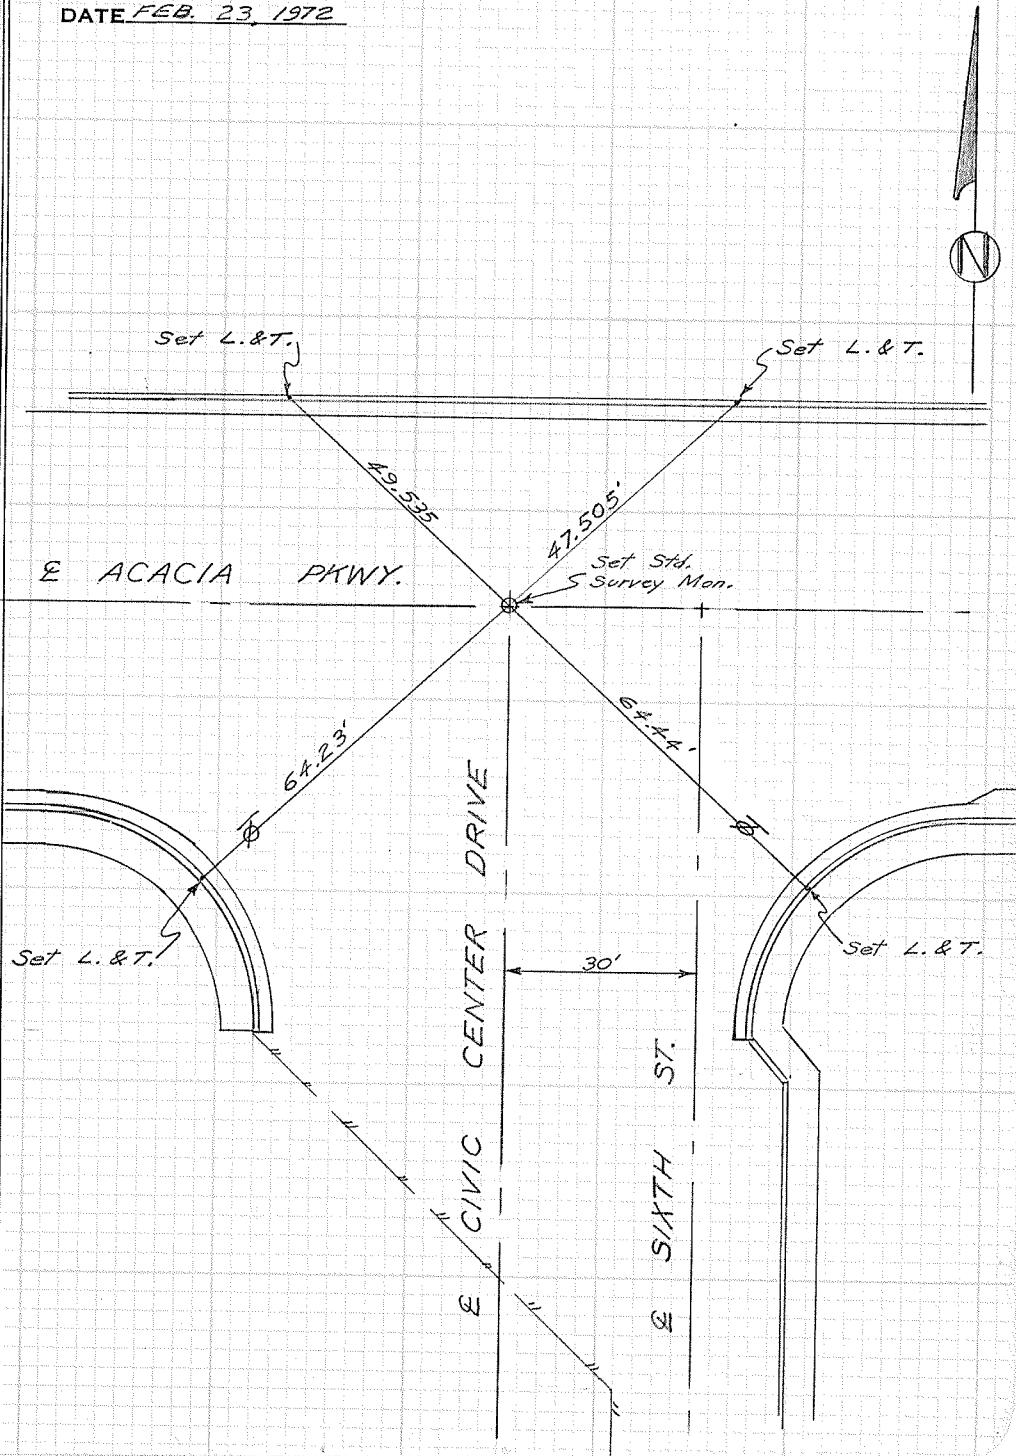

CITY OF GARDEN GROVE, CALIFORNIA

SURVEY OF ACACIA & EIGHTH ST. T B NO. 3 PAGE 24
 SURVEY BY PRICKETT & PARTY TRACT NO.
 DATE JUNE 24, 1971

DO NOT EXTEND NOTES THIS SIDE OF LINE

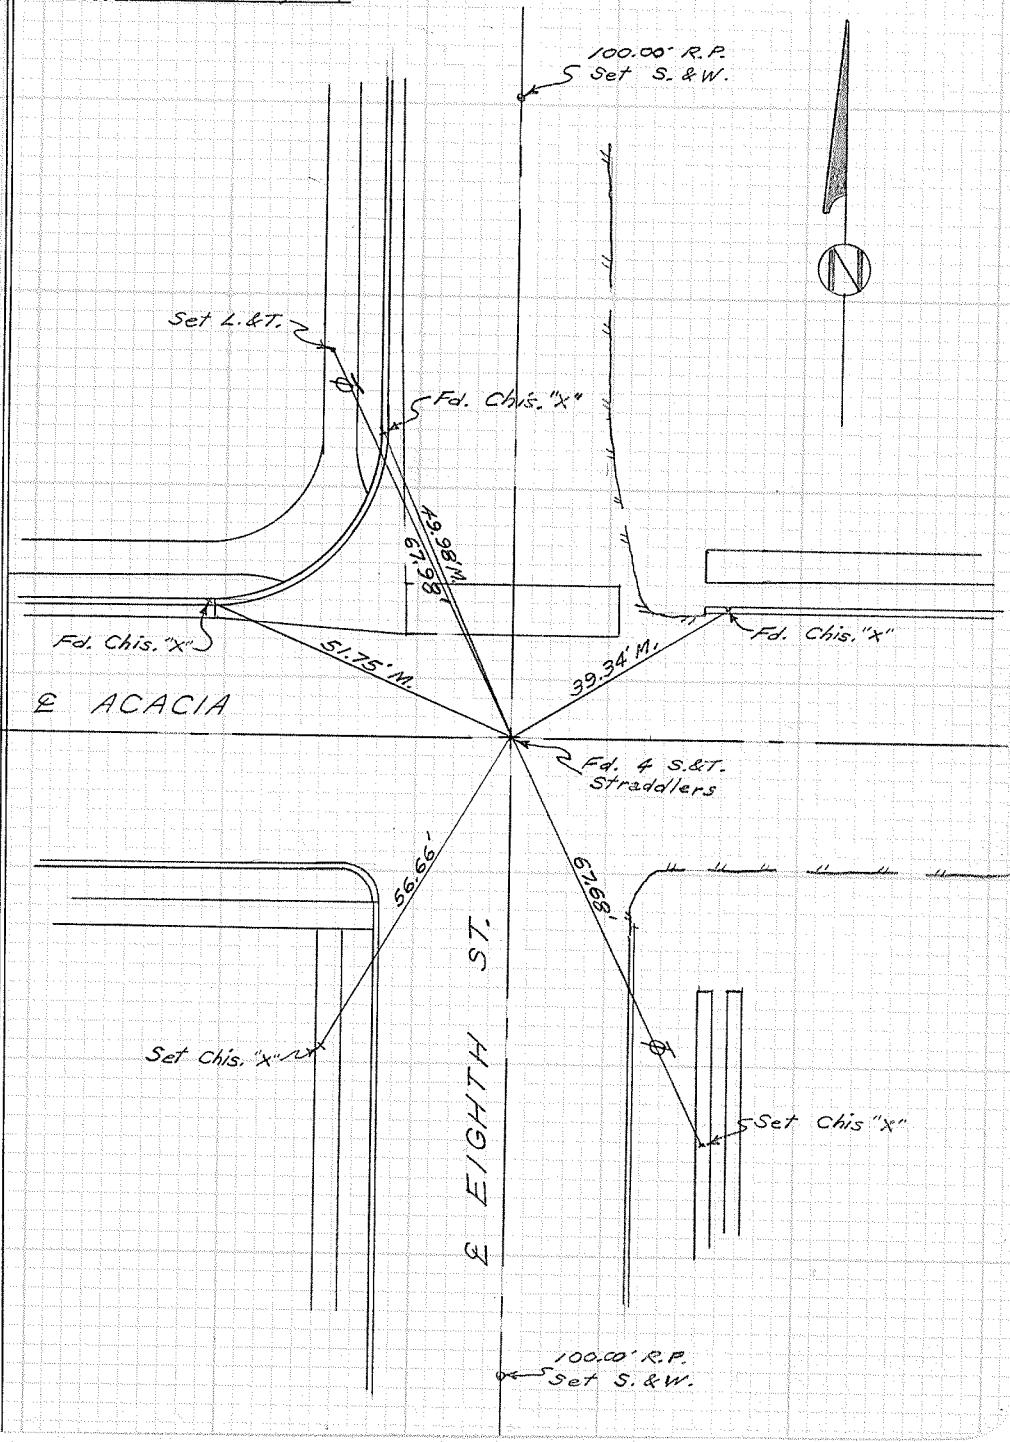


CITY OF GARDEN GROVE, CALIFORNIA

NEW E BROOKHURST ST.
SURVEY OF NORTH OF WESTMINSTER T. B. NO. 3 PAGE 1
SURVEY BY PRICKETT & CREW TRACT NO.
DATE 8/21/68

DO NOT EXTEND NOTES THIS SIDE OF LINE


SURVEYORS SERVICE COMPANY STA MESA - STOCK NO. 411

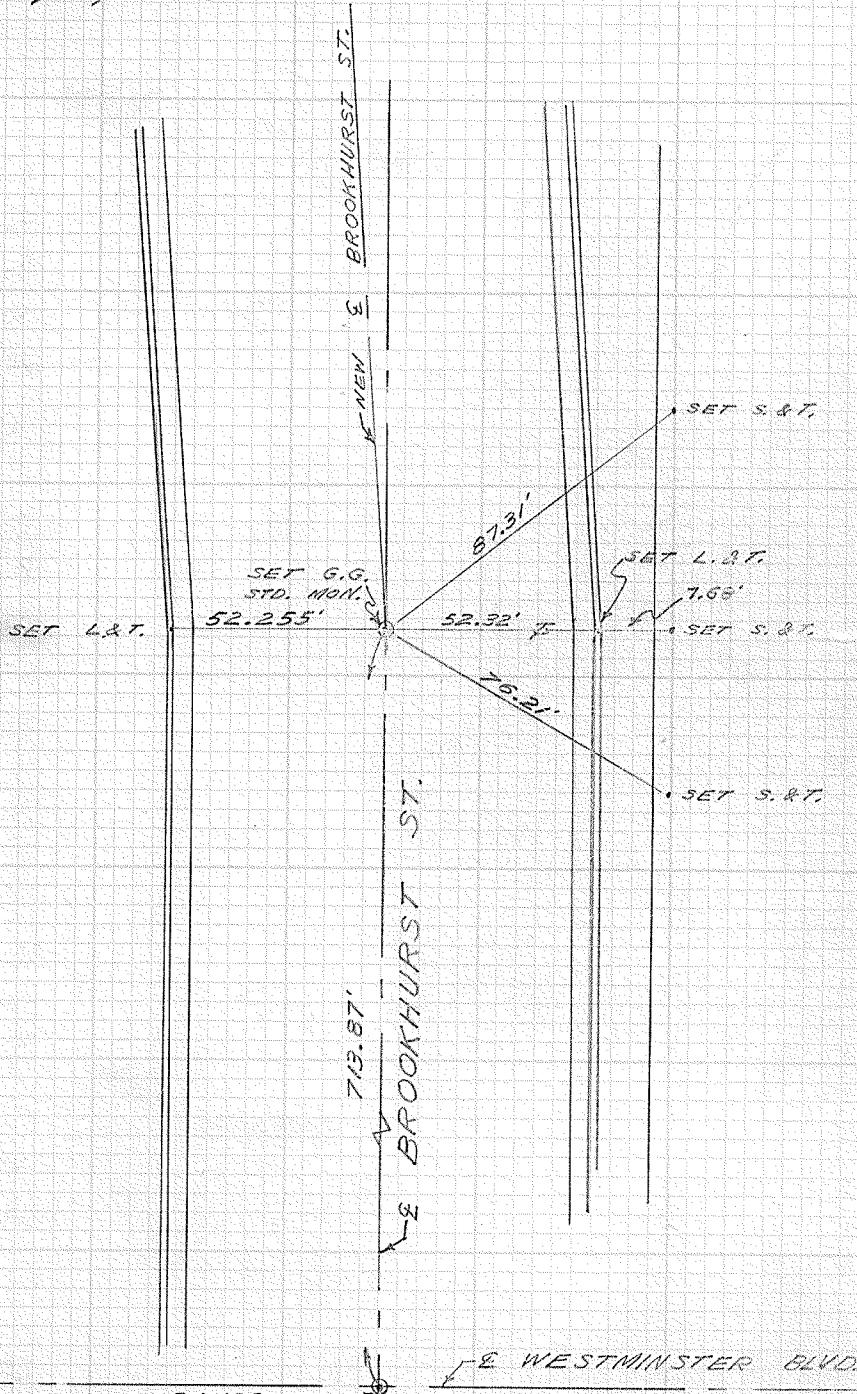

CITY OF GARDEN GROVE, CALIFORNIA

NEW E BROOKHURST ST.
SURVEY OF NORTH OF WESTMINSTER T. B. NO. 3 PAGE 2
SURVEY BY PRICKETT & CREW TRACT NO.
DATE 8/21/68

DO NOT EXTEND NOTES THIS SIDE OF LINE

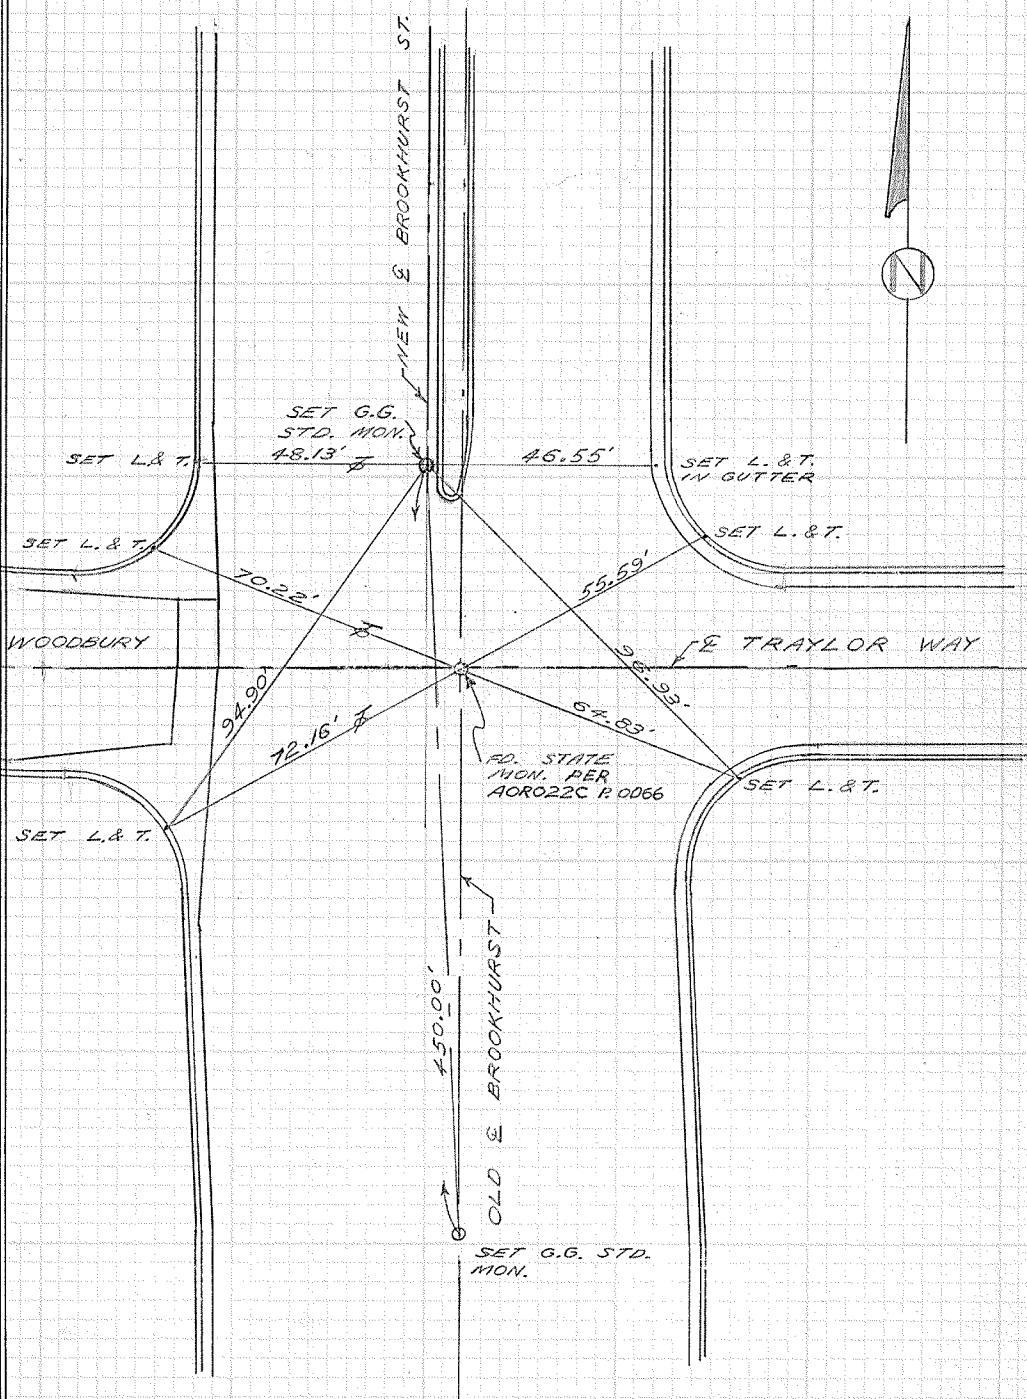

CITY OF GARDEN GROVE, CALIFORNIA


SURVEY OF Brookhurst & Dakota TB NO. 3 PAGE 3

SURVEY BY Simons & Party TRACT NO.

DATE March 28, 1969

Note: See Back side
for points found down
to 2' below Surface

DO NOT EXTEND NOTES THIS SIDE OF LINE

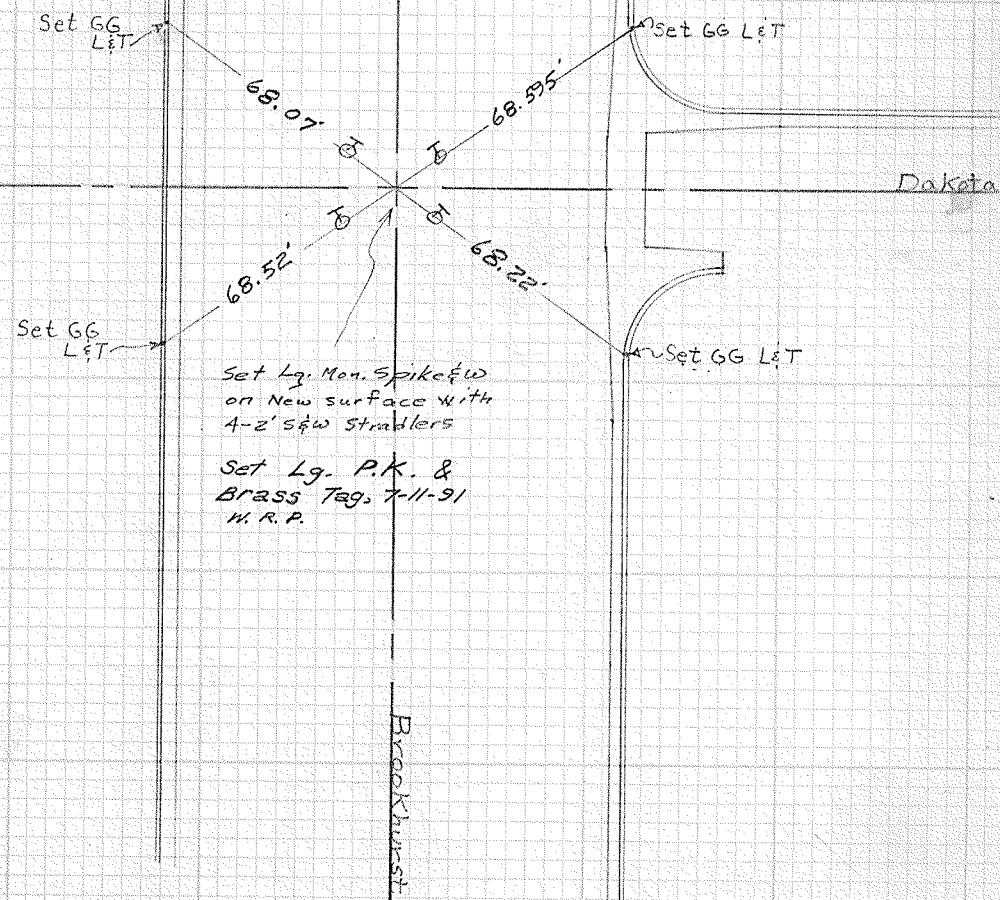

CITY OF GARDEN GROVE, CALIFORNIA

T B NO. 3 PAGE 3

SURVEYORS SERVICE COMPANY, COSTA MESA - STOCK NO. 411

DO NOT EXTEND NOTES THIS SIDE OF LINE

Fd Bolt on surface
as per. OC TB 131-31
& R/S 87-1

Fd nothing else down
to Z

Dakota

Tied Center of Bolt.


← 0.02'

CITY OF GARDEN GROVE, CALIFORNIA

SURVEY OF BROOKHURST & RUSSELL TB NO. 3 PAGE 4
 SURVEY BY SIMONS & Party TRACT NO.
 DATE March 28, 1969

Note: See
 Back Side for
 Points found.

DO NOT EXTEND NOTES THIS SIDE OF LINE

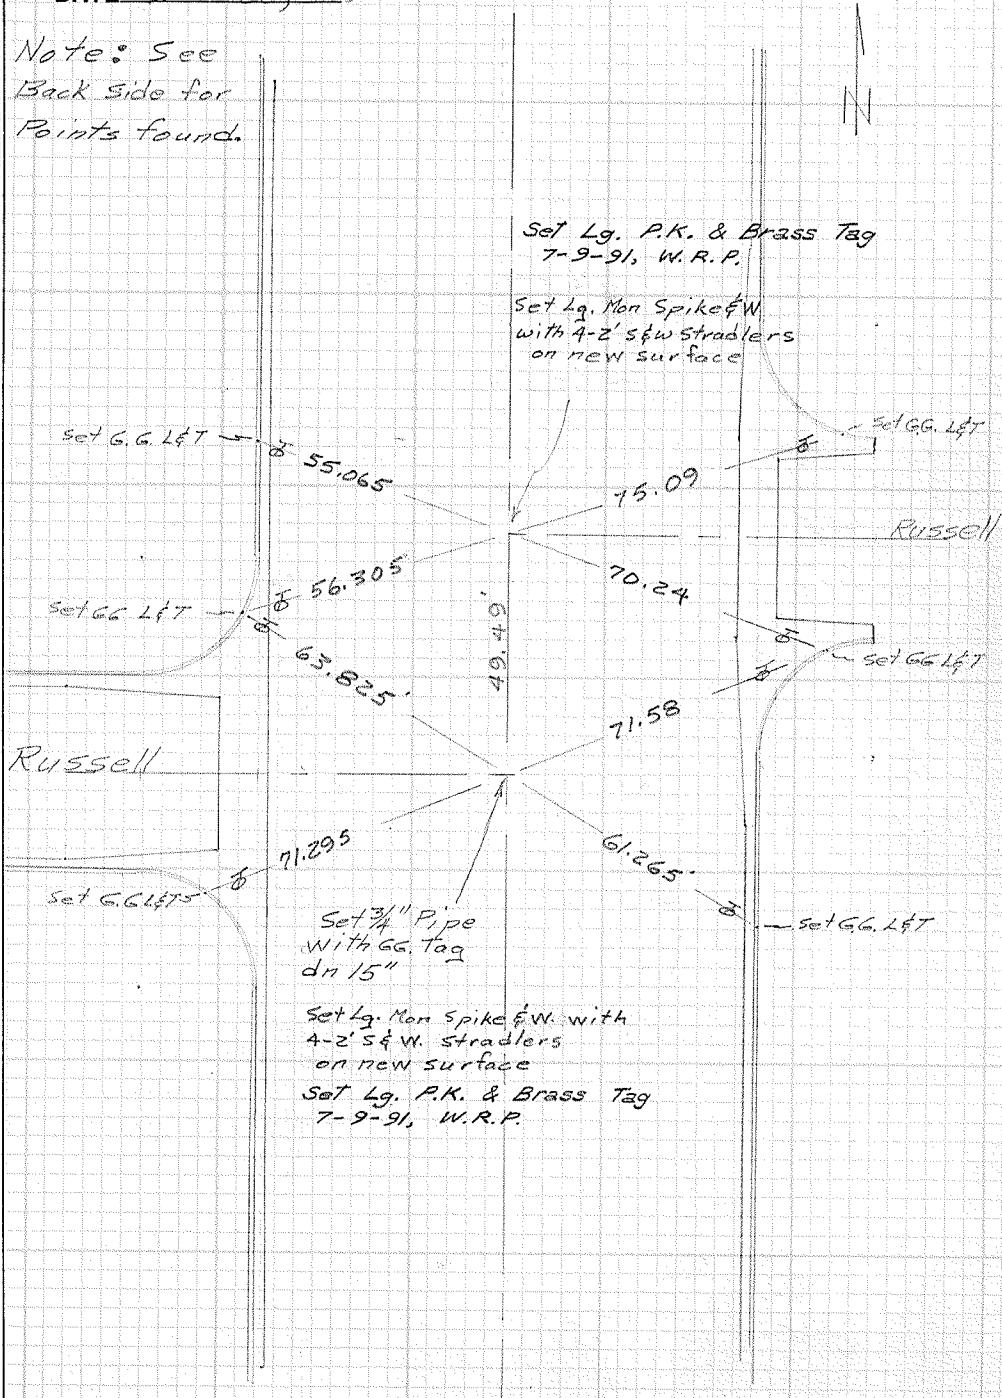

CITY OF GARDEN GROVE, CALIFORNIA

T B NO 3 PAGE 4

History of Point

OCTB 135-B
OCTB 131-31

BROOKWEST

L N E B E T W E E N M O U N
@ T R A S K # G . S . B l o u

Scale 1" = 0.10'

SURVEYORS SERVICE CO.

Y. COSTA MESA - STOCK NO. 411

DO NOT EXTEND NOTES THIS SIDE OF LINE

RUSSELL
EAST

Fd 3/4" Pipe dn 1'

TIED OUT PIPE

→ 0.055'

Fd Bolt dn 2" below surface
0.09' N & 0.02' E of Pipe

Fd Bolt on surface
0.00' N & 0.09' E
of Pipe

Fd 12" Spike dn 3"
below Surface
0.00' N & 0.02' E of Pipe

Fd Nail on Surface
0.00' N & 0.04' E
of Pipe

Fd Net on Surface
0.15' N & 0.09' W of
12" Spike

BROOKWEST

→ 0.14'

Fd Net dn 2" below
surface
0.02' N & 0.03' W of
12" Spike

RUSSELL
WEST

L N E B E T W E E N M O U N
@ T R A S K # G . S . B l o u

Fd 12" Spike dn 3" below
surface No Rec.
Fd Nothing else dn to 2'
TIED OUT CENTER OF
SPIKE

CITY OF GARDEN GROVE, CALIFORNIA


SURVEY OF Breakhurst & Imperial TB NO. 3 PAGE 5

SURVEY BY Simons & Party TRACT NO.

DATE March 28, 1969

Note: See Back side
for points found down
to 1' below Surface

DO NOT EXTEND NOTES THIS SIDE OF LINE

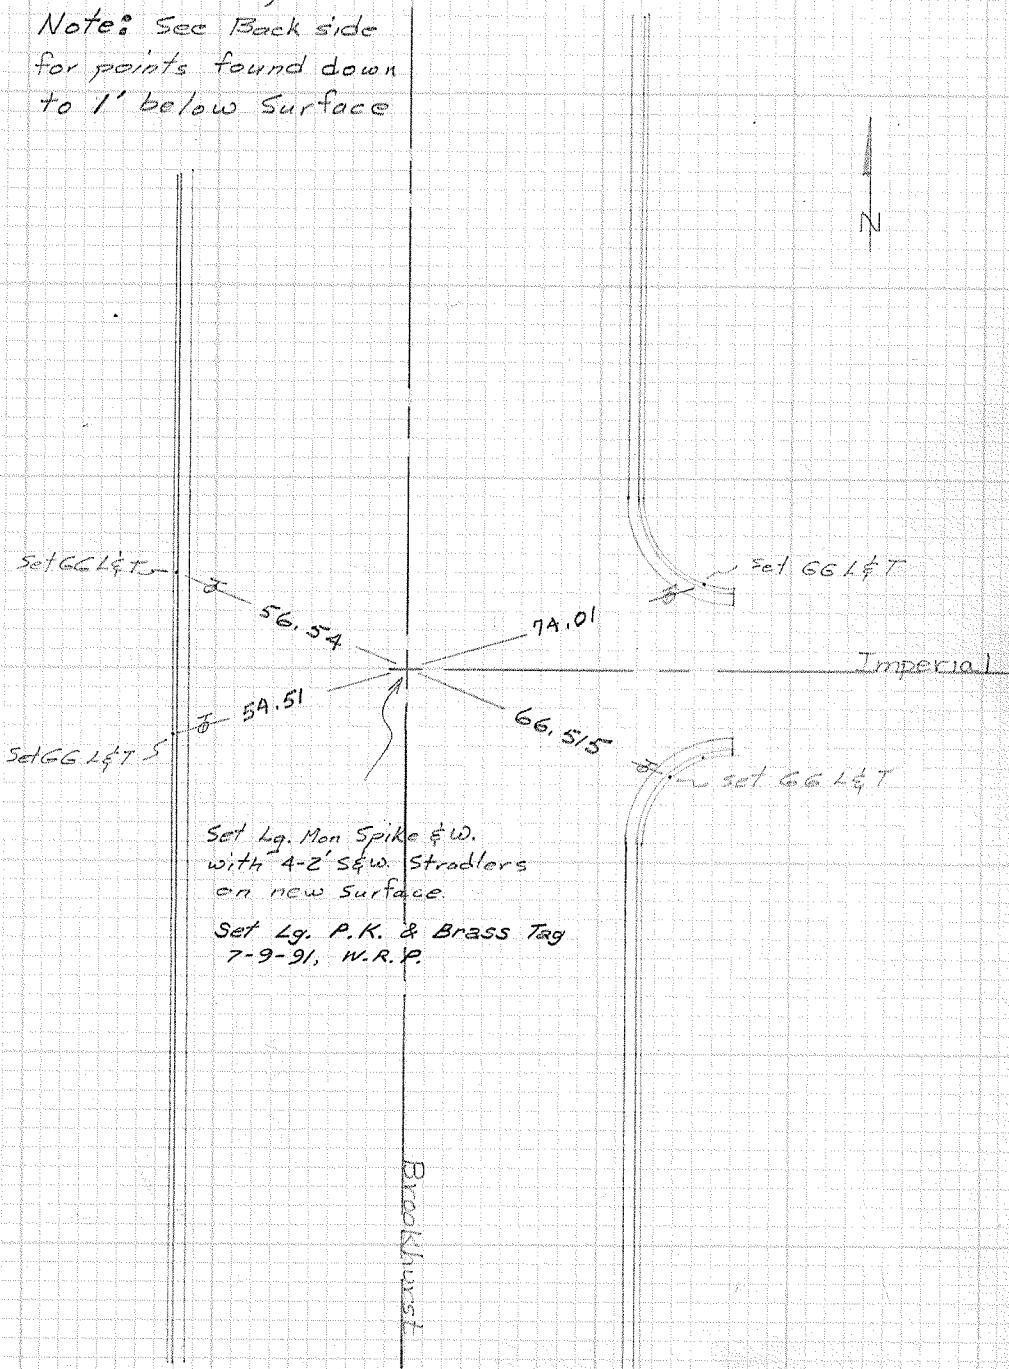

CITY OF GARDEN GROVE, CALIFORNIA

T B NO. 3 PAGE 5

History of pt

OCTB 135-9
OCTB 131-31

Fd Pipe as per OCTB 135-9

Fd $\frac{3}{4}$ " Pipe down -
1' below surface

Fd 12" Spike down 3"
below surface same
location as pipe

Tied out Pipe

EDD 135-9

EDD

Scale 1" = 0 10'

SURVEYORS SERVICE COMPANY, COSTA MESA - STOCK NO. 411

DO NOT EXTEND NOTES THIS SIDE OF LINE

Fd Bolt no punch
2" below surface
007N & 0075E of Pipe

Imperial

Fd Bolt on Surface
no punch mark
0.055S & 0.095E
of Pipe

POLARIS PHYSICAL
SOUTH NEMESIS UNIT

0.10'

CITY OF GARDEN GROVE, CALIFORNIA

SURVEY OF Brookhurst & Central TB NO. 3 PAGE 6


SURVEY BY Simons & Party TRACT NO.

DATE March 28, 1968

Note: See Back

Side for Points
found

DO NOT EXTEND NOTES THIS SIDE OF LINE

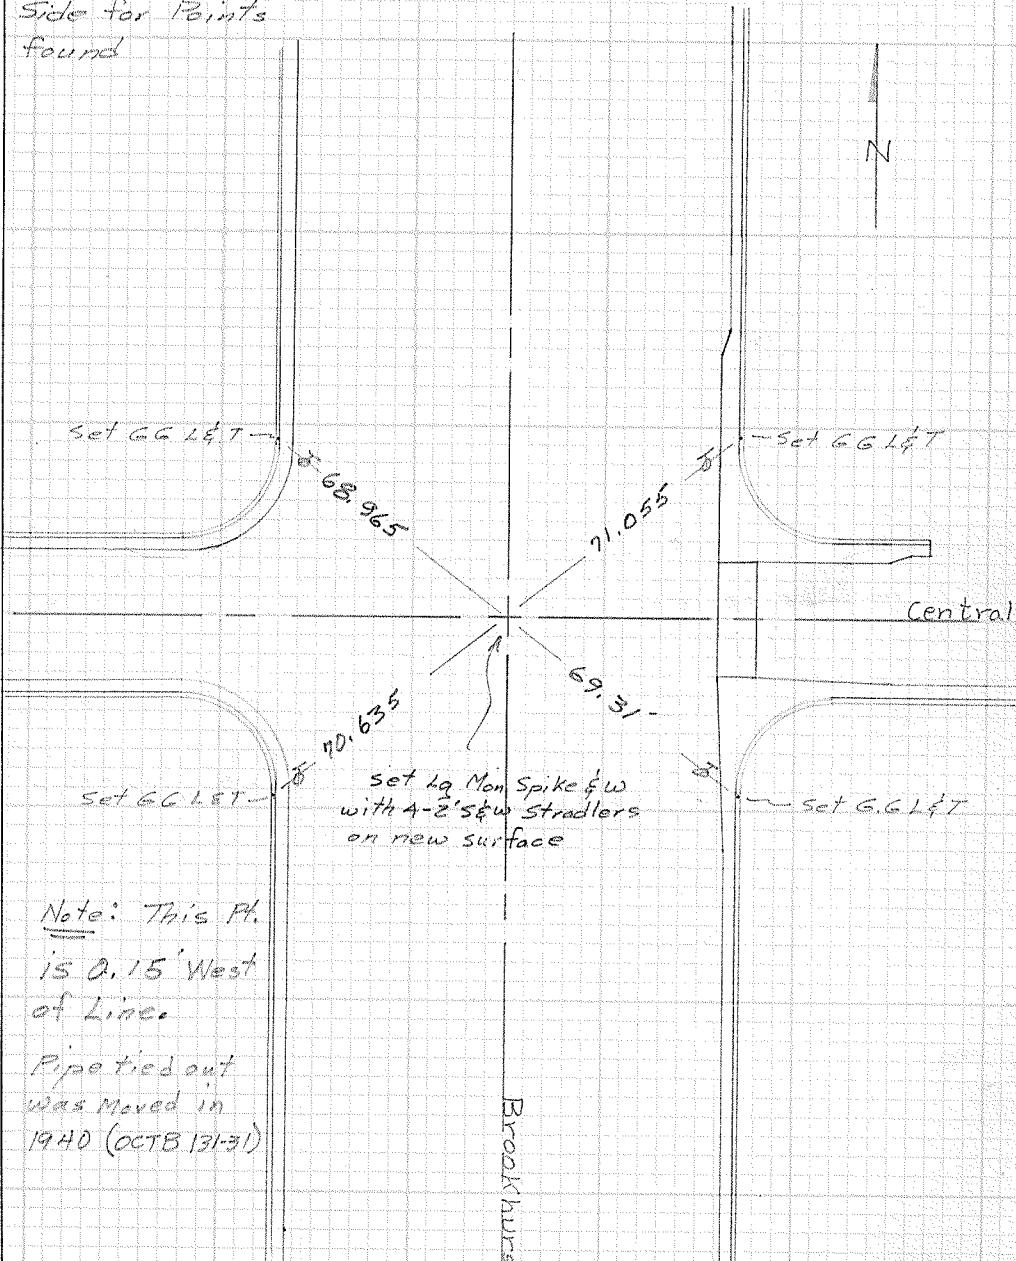

CITY OF GARDEN GROVE, CALIFORNIA

SURVEY OF Brookhurst St. & Central Ave. T B NO. 3 PAGE 6A

SURVEY BY Prickett & Party TRACT NO.

DATE May 23, 1991

TA MESA - STOCK NO. 411

SURVEYORS SERVICE COMPANY,

DO NOT EXTEND NOTES THIS SIDE OF LINE

Fd. L. & T.
per G.G. T.B.
3, P. 6

E CENTRAL AVE.

Fd. L. & T.
per G.G. T.B.
3, P. 6

63°35' R. 63°35' N.

106°35' R. 106°35' N.

E BROOKHURST ST.

Fd. Mon. Spk & W. with four
2' S. & W. Straddlers per
G.G. T.B. 3, P. 6

Set Lg. P.K. & Brass Tag,
7-10-91

63°35' R. 63°35' N.

Fd. L. & T.
per G.G. T.B.
3, P. 6

Set L. & T.

71°08'

CITY OF GARDEN GROVE, CALIFORNIA

TB NO. 3 PAGE 6

HISTORY OF PT.

R/5 7
R/5 - 3
OCTB 135-79
OCTB 135-10
OCTB 131-31 (Pt. was Moved Oct 9 'W)
OCTB 106-37
OCTB 97-25

LSDM/HDR

Scale 1" = 0.10'

Line Between Mts
@ Tract # 6 S. Blvd

SURVEYORS SERVICE COMPANY, COSTA MESA - STOCK NO. 411

DO NOT EXTEND NOTES THIS SIDE OF LINE

Fd 1/2" Spike dn 2" below
surface 0.02' N & 0.005 E of Pipe
as per OCTB 131-31

CENTRAL

① Fd punched Bolton
surface
0.06' S & 0.10' E of Pipe
as per tract 4668

Fd 3/4" Pipe dn 1'
below surface
as per OCTB 131-31

TIED OUT PIPE

Note: Pt. was Moved
0.19' West in 1940 (OCTB 131-31)

Fd Bolt 1" below
surface - Disturbed
while removing
surface Bolt.

No REC.

← 0.15' →

CITY OF GARDEN GROVE, CALIFORNIA

SURVEY OF Brookhurst & Crosby TB NO. 3 PAGE 7


SURVEY BY Simons & Party TRACT NO.

DATE March 28, 1969

Note:

See Back Side
for Points
Found

DO NOT EXTEND NOTES THIS SIDE OF LINE

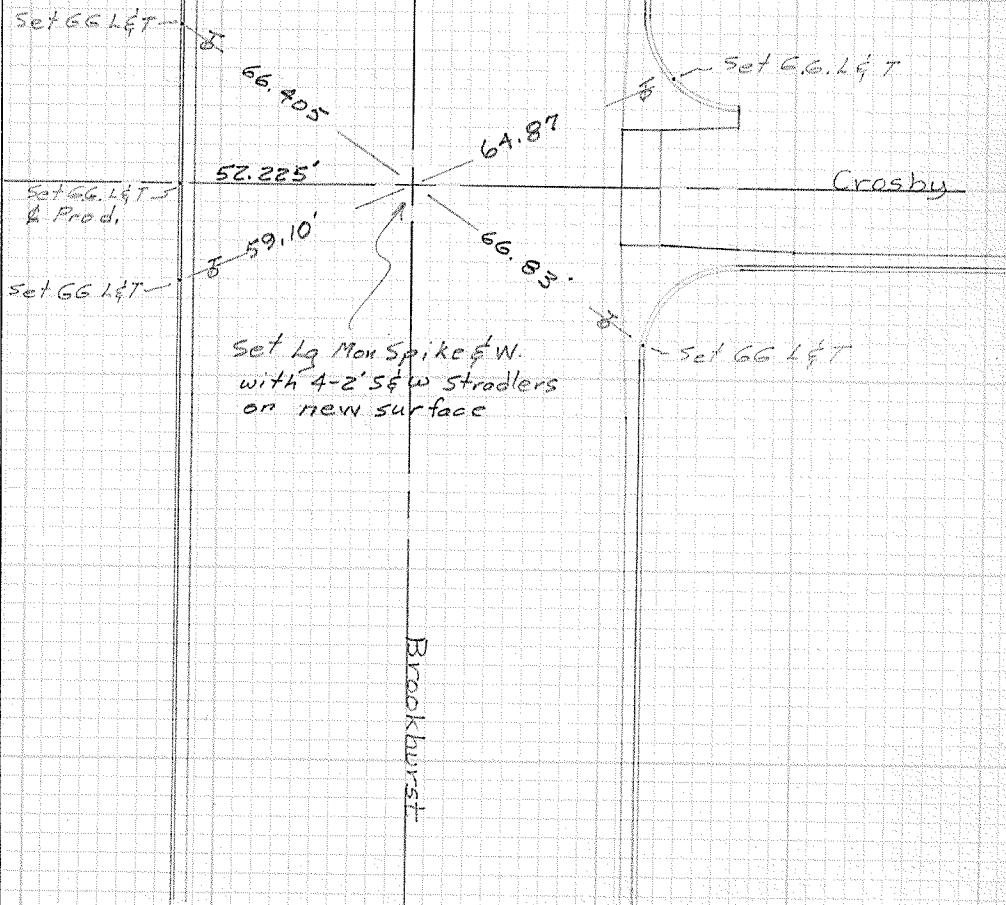

CITY OF GARDEN GROVE, CALIFORNIA

SURVEY OF Brookhurst St & Crosby Ave. T.B. NO. 3 PAGE 7A


SURVEY BY Prickett & Party TRACT NO.

DATE May 23, 1991

TA MESA - STOCK NO. 411

SURVEYORS SERVICE COMPANY,

DO NOT EXTEND NOTES THIS SIDE OF LINE

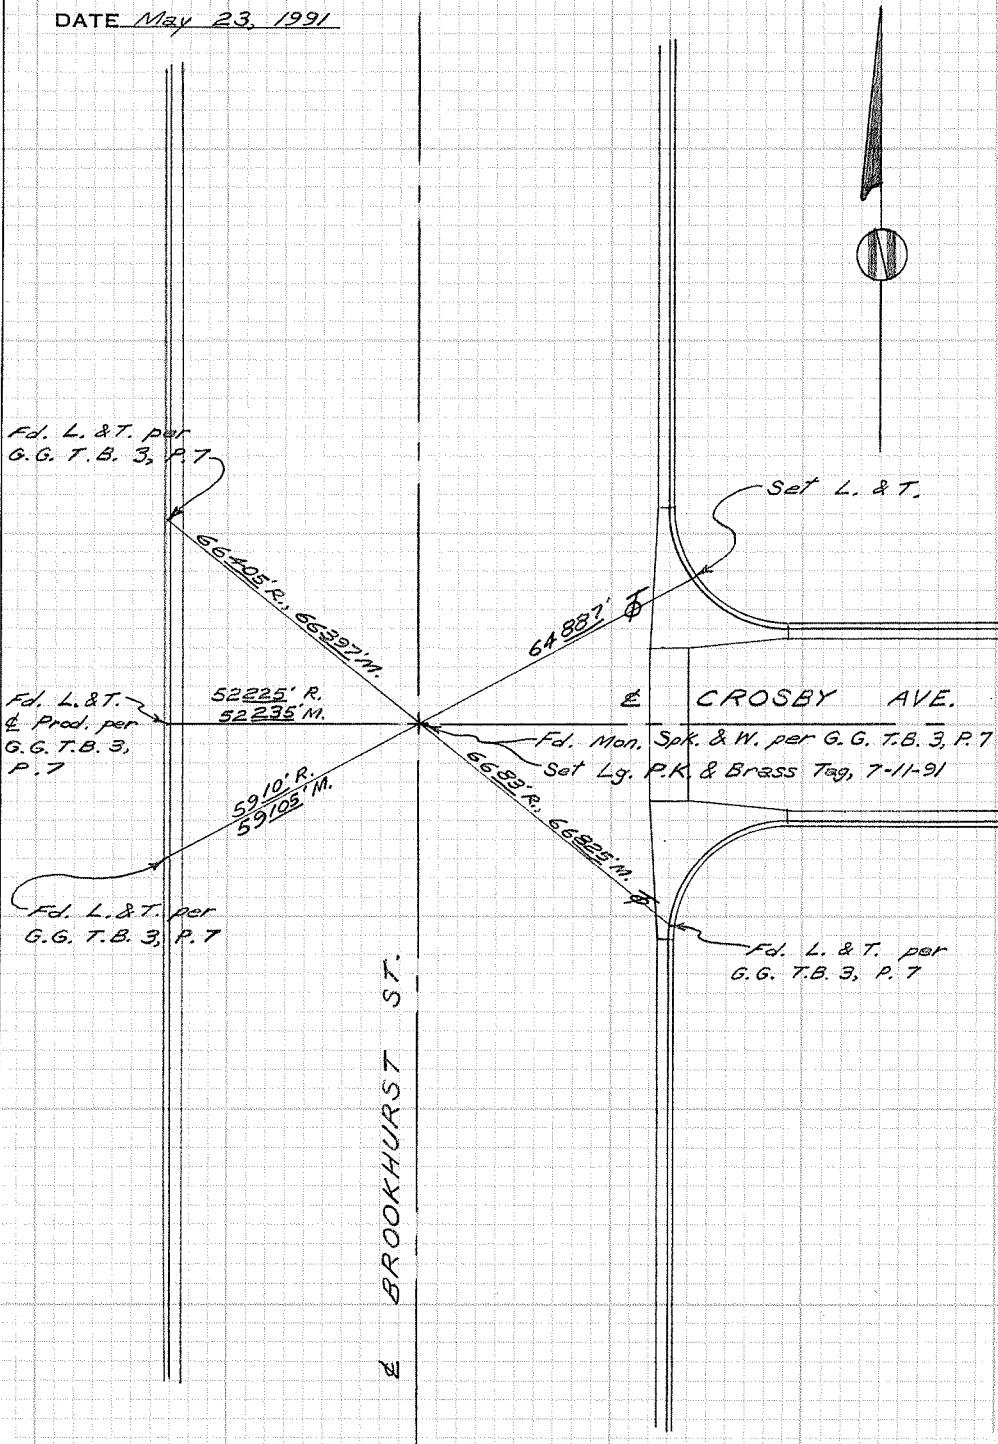

CITY OF GARDEN GROVE, CALIFORNIA

T B NO 3 PAGE 7

History of Point

SOC OCTB 135-11 § 131-31

SURVEYORS SERVICE COMPANY, COSTA MESA - STOCK NO. 411

DO NOT EXTEND NOTES THIS SIDE OF LINE

STREET SURVEY

- Point No 3
Punch Spike
Pinned
Nailed
Tied Out Spike
- — Fd nail dn $\frac{1}{8}$ " below surface
0.07' N & 0.00 E of Spike
 - Fd Punched Spike on Surface

Fd nothing else
dn to 2'
Sewer Lateral runs
under Points

CITY OF GARDEN GROVE, CALIFORNIA

SURVEY OF Brookhurst & Larson TB NO. 3 PAGE 8

SURVEY BY Simons & Party TRACT NO.

DATE March 28, 1969

Note:

See Back

Side for
Points Found

DO NOT EXTEND NOTES THIS SIDE OF LINE

Set GG LFT

66.15'

59.66'

64.91'

67.025'

Set GG LFT

Set Lg Mon. Spike & W
with 4-2' S_q w Stradlers
on new surface

+String Line

Set GG LFT

Larson

Set GG LFT

N

CITY OF GARDEN GROVE, CALIFORNIA

T B NO. 3 PAGE 8

History of Point

OCTB 135-12
OCTB 131-31

Bookham's T

Scale 1" = 0.10'

Fd 12" Spike 2" below
surface
0.065'N & 0.00E of pipe

Fd Bolt on Surface
0.085'N & 0.15'E
of Pipe

○ - Fd Bolt 1" below surface
0.045'N & 0.055'E of Pipe

LARSON

Fd 3A" I.P. dn 1"
below surface as per
OCTB 135-12
TIED OUT PIPE

← 0.16' →

© TRASK & C. BLDG
LINE BETWEEN MONS

SURVEYORS SERVICE COMPANY, COSTA MESA - STOCK NO. 411

DO NOT EXTEND NOTES THIS SIDE OF LINE

CITY OF GARDEN GROVE, CALIFORNIA

SURVEY OF ~~Brookhurst & Alley Not Larson~~ TB NO. 3 PAGE 9

SURVEY BY ~~Simons & Party~~ TRACT NO.

DATE March 2

Note:

See Back Side
for Points
Found.

DO NOT EXTEND NOTES THIS SIDE OF LINE

Set GG LFT

57.32

58.065

8

Set GG LFT

Set GG LFT

57.97

57.355

Set GG LFT

Set 1g Mon Spike & W
with 4-2' S & W Stradlers
on new Surface

Dirt Alley

CITY OF GARDEN GROVE, CALIFORNIA

SURVEY OF Brookhurst St. & Alley N. of Larson T.B. NO. 3 PAGE 9A


SURVEY BY Brickett & Party TRACT NO. _____

DATE May 23, 1991

TA MESA - STOCK NO. 411

SURVEYORS SERVICE COMPANY,

DO NOT EXTEND NOTES THIS SIDE OF LINE

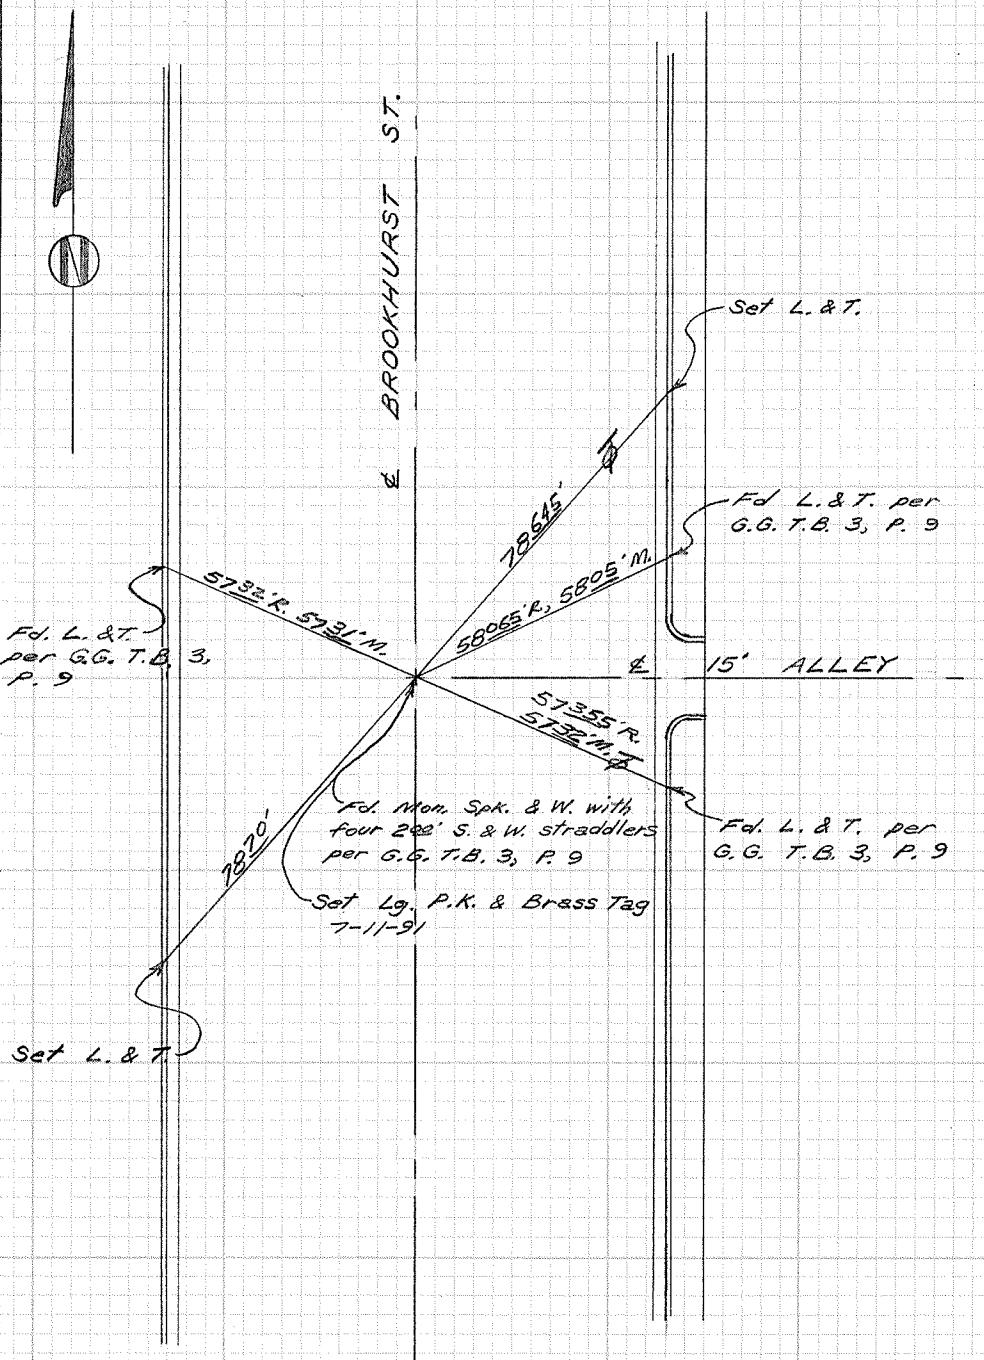

CITY OF GARDEN GROVE, CALIFORNIA

T B NO. 3 PAGE 9

History of Point

See Tract 124

Book First

R LINE BETWEEN MENS
@ TRACT # G.S. Blod

Z

Scale 1" = 0.10'

Fd Nail on Surface
No Record
Nothing else dr. to 2' / o

TIED OUT NAIL

~ 0.015'

ALLEY

Tract line 7.5' South
Fd Nothing on Surface
Fd Nothing dr. to 2'

SURVEYORS SERVICE CO.

N.Y. COSTA MESA - STOCK NO. 411

DO NOT EXTEND NOTES THIS SIDE OF LINE


CITY OF GARDEN GROVE, CALIFORNIA

SURVEY OF Brookhurst & Emerson TB NO. 3 PAGE 10
SURVEY BY Simons & Party TRACT NO.
DATE March 28, 1969

Note:

See Back Side
for Points
Found

DO NOT EXTEND NOTES THIS SIDE OF LINE

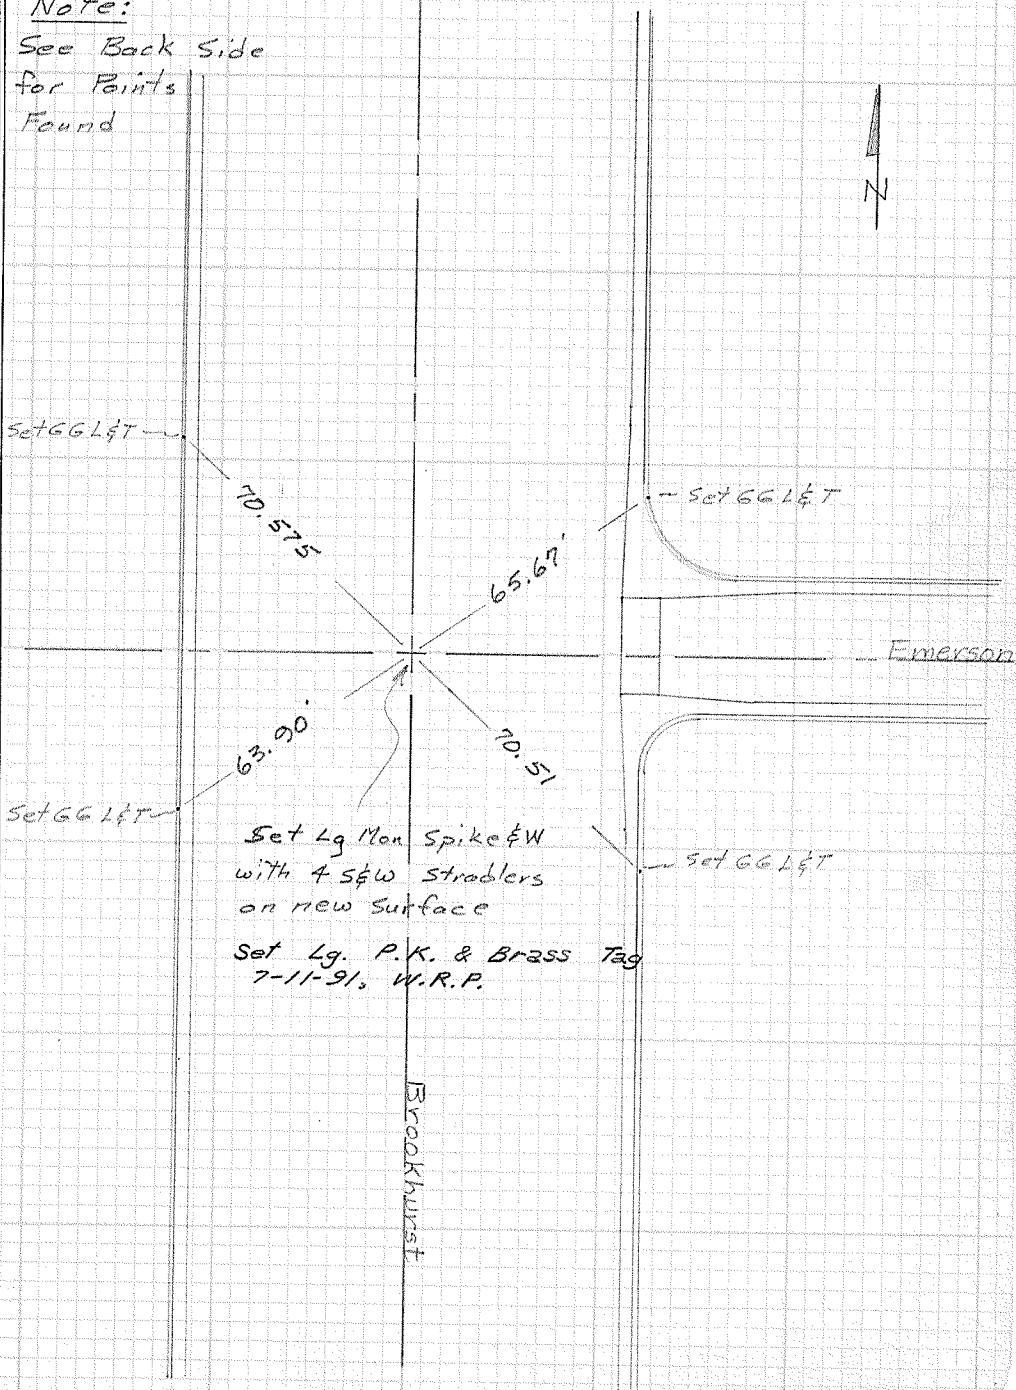

CITY OF GARDEN GROVE, CALIFORNIA

T B NO. 3 PAGE 10

History of Point

See OCTB 135-13 &
131-31

Brookhurst

LINE BETWEEN HORN'S
OF TRANS. & C. S. CO.

Fd Punch Spike on Surface
No Record. EMERSON

Fd nothing else dn to 2'
Sewer lateral runs
under Points
Tied out Spike

← 0.025'


SURVEYORS SERVICE COMPANY, COSTA MESA - STOCK NO. 411

DO NOT EXTEND NOTES THIS SIDE OF LINE

CITY OF GARDEN GROVE, CALIFORNIA

SURVEY OF BROOKHURST C 1ST E.C. N/O G.G. BLYD
 SURVEY BY TUGGLE & PARTY T B NO. 3 PAGE 11
 DATE 10-7-70

DO NOT EXTEND NOTES THIS SIDE OF LINE

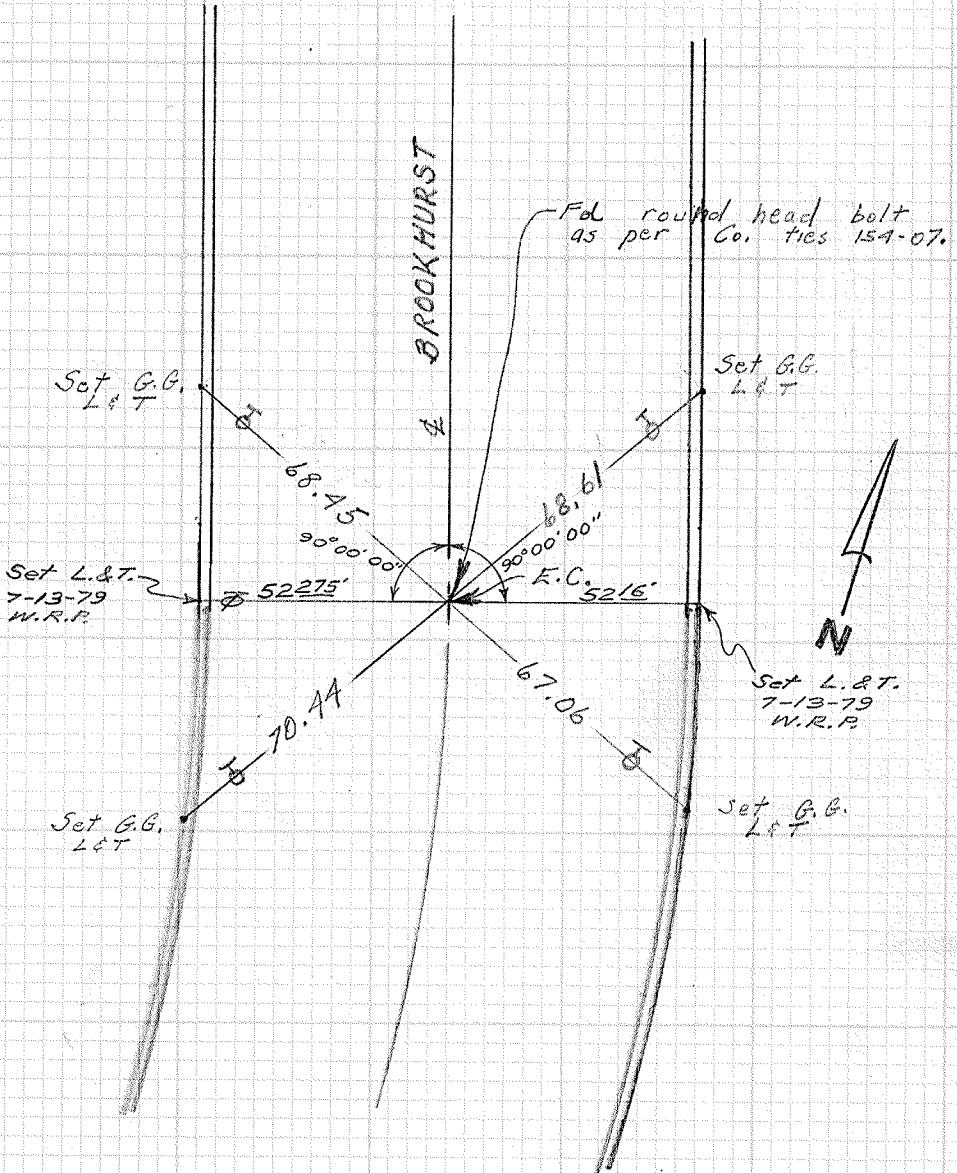

CITY OF GARDEN GROVE, CALIFORNIA

SURVEY OF BROOKHURST & STANFORD T B NO. 3 PAGE 12

SURVEY BY TUGGLE & PARTY **TRACT NO.**

DATE 8-25-70

TEMP. 81°

Set 6.6, L&T

Fd round head bolt as per Co. ties
154-07 no punch. Set punch on
line between P.I. & E.C. South
Set G.G. L.T.
set spk & washer
after const

Set 6.6. Let

Set L & 7
7-23-79
W.R.P.

B.C. 52/2

S Set L. & T
7-23-79
W.R.P.

DO NOT EXTEND NOTES THIS SIDE OF LINE

Set. G.G.
LET

Fd. round head bolt as per Co. ties
154-07 no punch. Line between
P.I. & E.C. South misses bolt .035W.
Reset spk & washer =
after const. =

Reset spk
after const

BROOKHURST ST.

STANFORD

Set 66.1 ET

Wolfe

CITY OF GARDEN GROVE, CALIFORNIA

SURVEY OF Brookhurst St. & Stanford Ave. T B NO. 3 PAGE 12A

SURVEY BY Prickett & Party

TRACT NO.

DATE JULY 7, 1992

TA MESA - STOCK NO. 411

SURVEYORS SERVICE COMPANY.

DO NOT EXTEND NOTES THIS SIDE OF LINE

Fd. L. & T.
per G.G.T.B.
3, P. 12.

Set new L.&T.
to on new curbs
11-18-92

Fd. L. & T.
per
G.G.T.B. 3, P. 12.

6123' R.
6102 (11-18-92)

9512' R.
9513' M.

E BROOKHURST ST.

STANFORD
AVE.

T-2000

Fd. L. & T.
per G.G.T.B.
3, P. 12.

Fd. L. & T. per
G.G.T.B. 3, P. 12

Fd. L. & T. per
G.G.T.B. 3, P. 12

Set new L.&T.
to on new curbs
11-18-92

Fd. S. & W. per G.G.T.B. 3, P. 12
13/16" down.

Set Lg. P.K. & BRASS TAG
on surface

Fd. L. & T.
per G.G.T.B.
3, P. 12.


CITY OF GARDEN GROVE, CALIFORNIA
P.I. North of Stanford

SURVEY OF Brookhurst ST + BOOKHURST T B NO. 3 PAGE 13
WAY TRACT NO.
SURVEY BY Tuggee & Party
DATE 4-22-70

DO NOT EXTEND NOTES THIS SIDE OF LINE

SURVEYORS SERVICE COMPANY.

TA MESA - STOCK NO. 411

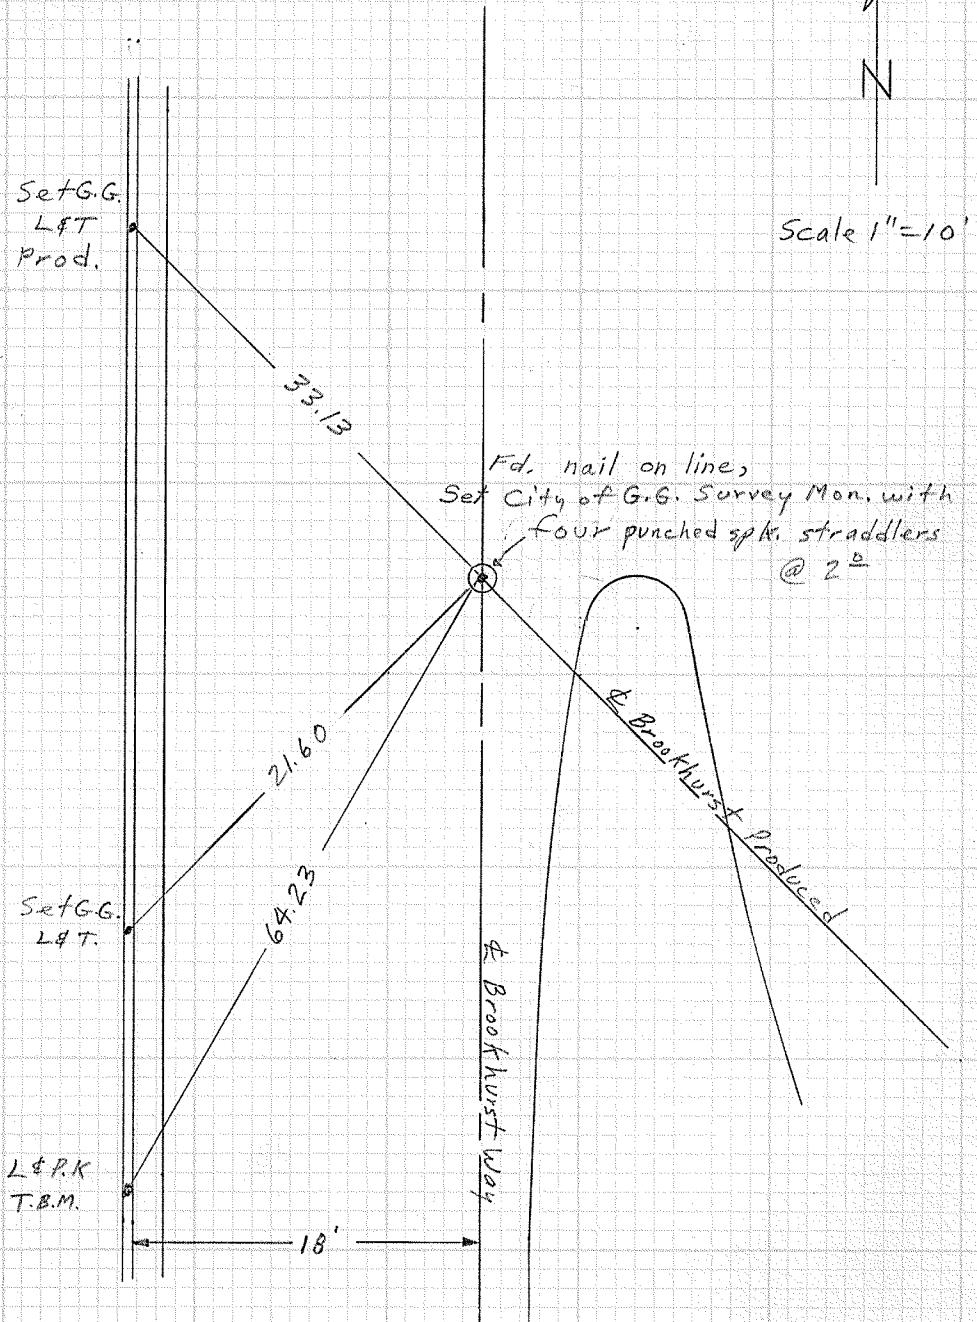


W.P.

CITY OF GARDEN GROVE, CALIFORNIA

SURVEY OF BROOKHURST ST. & LENORET B NO. 3 PAGE 14
 SURVEY BY TUGGLE & PARTY TRACT NO.
 DATE 8-25-70
 TEMP. 78°

DO NOT EXTEND NOTES THIS SIDE OF LINE

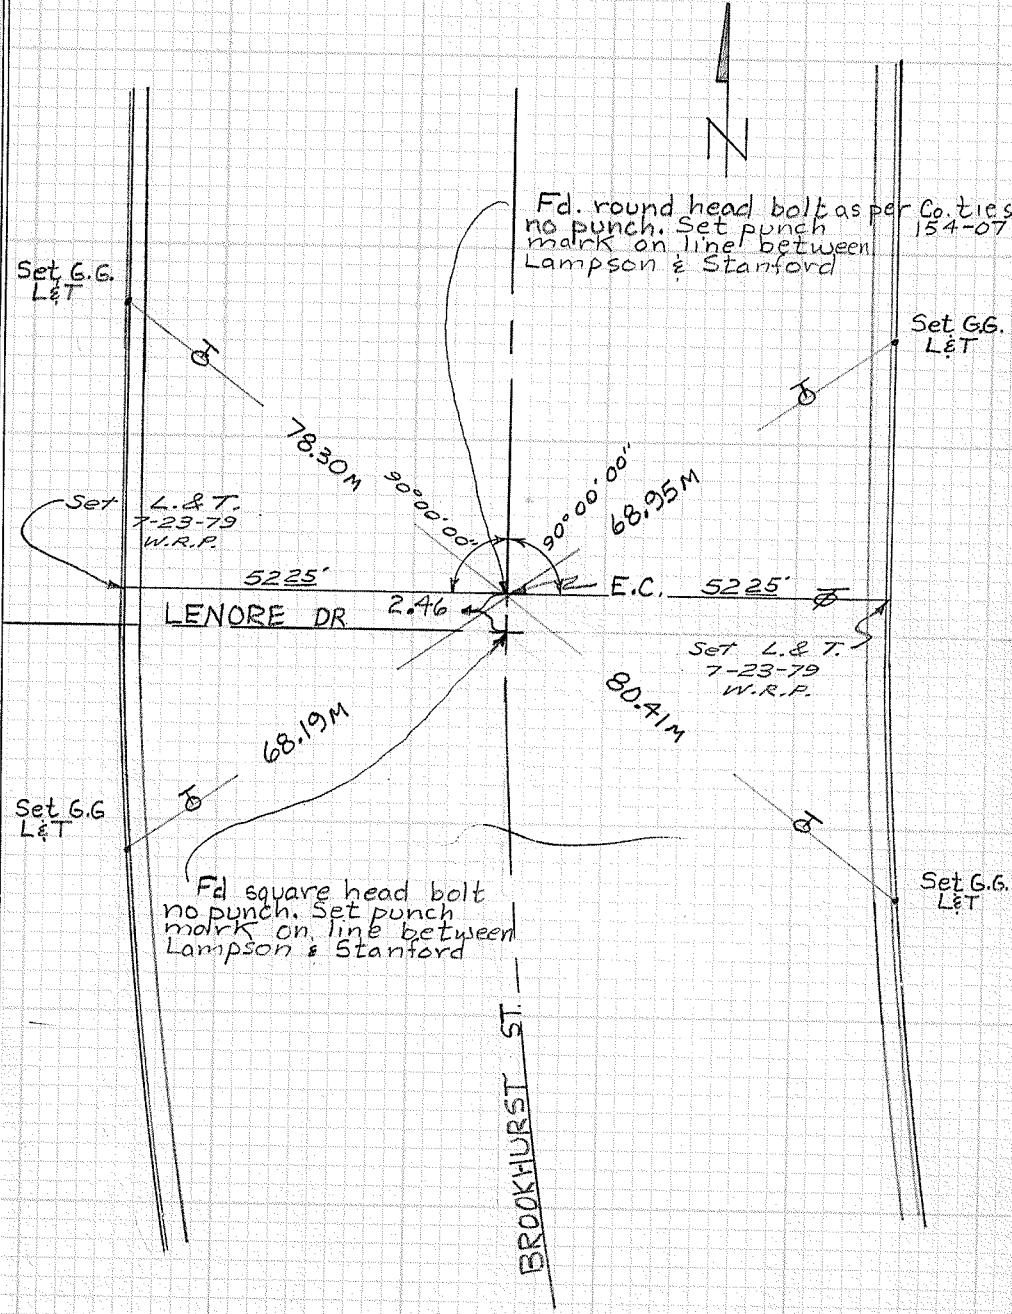

CITY OF GARDEN GROVE, CALIFORNIA

SURVEY OF Brookhurst St & Birney Ave TB NO. 3 PAGE 15

SURVEY BY Tuggele & Party TRACT NO.

DATE 1/20/71

TA MESA - STOCK NO. 411

SURVEYORS SERVICE COMPANY.

DO NOT EXTEND NOTES THIS SIDE OF LINE

Set G.G.
L.A.T. 1' from
B.C.R.

Set G.G. L.A.T.
45° from B.C.R.

1'

1'

69.44

10.71

@ Brookhurst St

Set 2nd head
SPK & washer

55.87

Set G.G. L.A.T.

10.71

67

Set G.G. L.A.T.

Set G.G. L.A.T.

Scale 1" = 30'

CITY OF GARDEN GROVE, CALIFORNIA

SURVEY OF Brookhurst St. & Bixby Ave. T B NO. 3 PAGE 15A

SURVEY BY Prickett & Party TRACT NO.

DATE JULY 7, 1992

SURVEYORS SERVICE COMPANY TA MESA - STOCK NO. 411

DO NOT EXTEND NOTES THIS SIDE OF LINE

Fd. L. & T.
per G.G.T.B.
3, P. 15

Fd. L. & T.
per G.G.T.B.
3, P. 15

69 44' R
69 51' M

101' R. 101' M.

55 87' R
55 885' M
55 845' (11-17-92)

Fd. L. & T.
per G.G.T.B.
3, P. 15

Fd. L. & T. per
G.G.T.B. 3, P. 15


Set new L. & T.
F on new curb,
11-17-92

Fd. Rd. Hd. Spk. &
W. 2 $\frac{1}{4}$ down per
G.G.T.B. 3, P. 15.
Set Lg. P.K. & Brass
tag on surface,

CITY OF GARDEN GROVE, CALIFORNIA


SURVEY OF WEST ST. & COLLEGE TB NO. 3 PAGE 16
 SURVEY BY PRICKETT & PARTY TRACT NO. 1352
 DATE JAN 29, 1971

DO NOT EXTEND NOTES THIS SIDE OF LINE

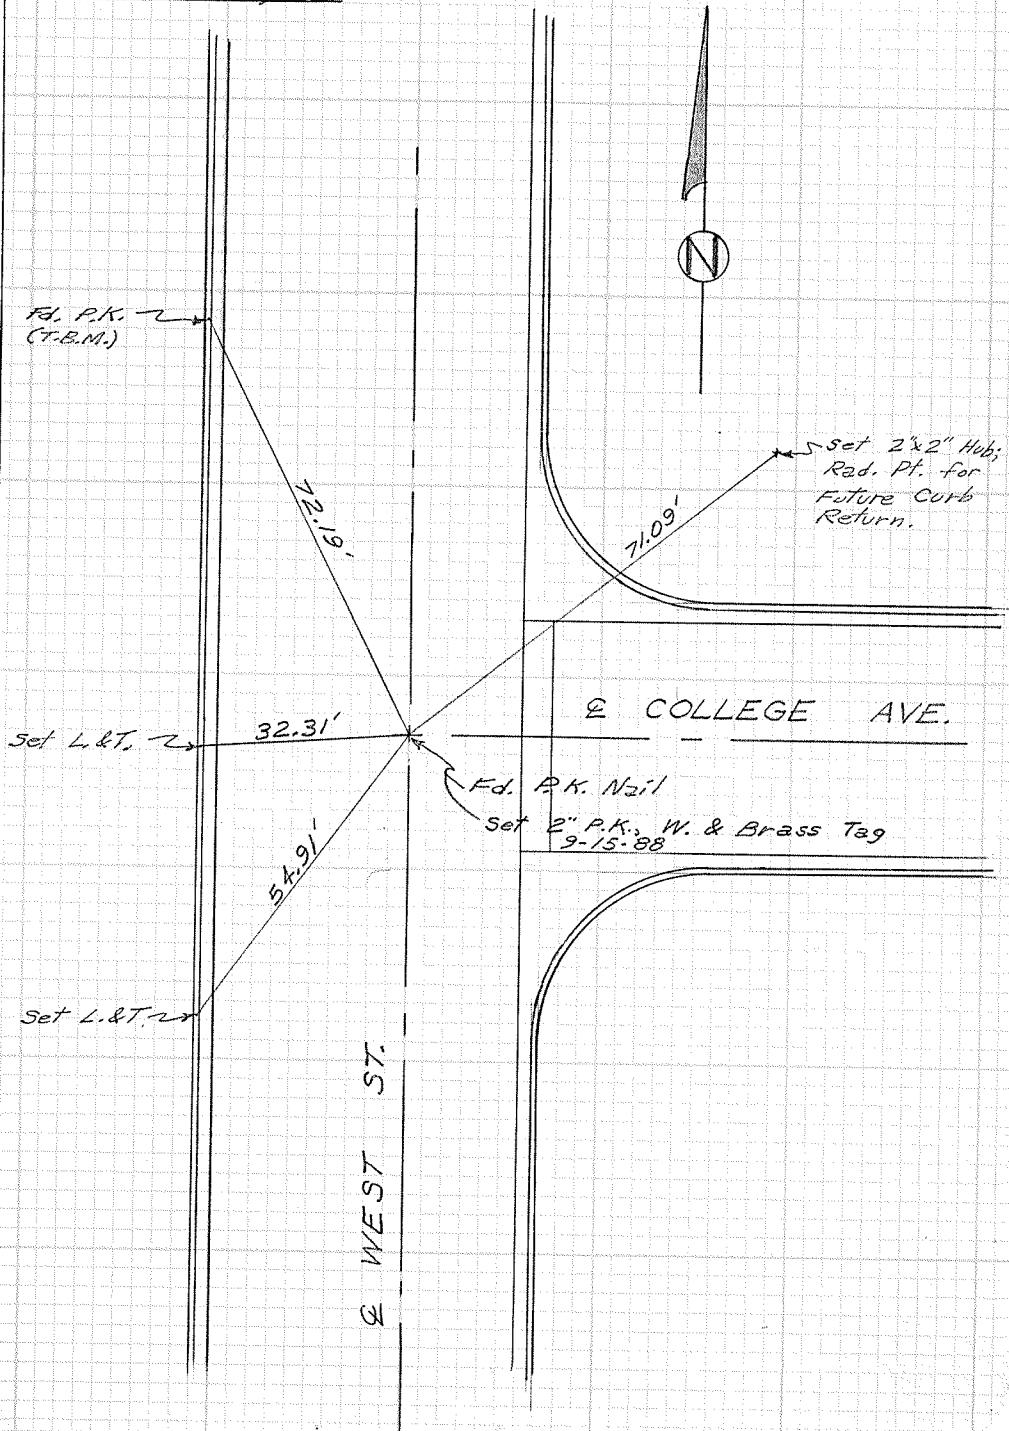

CITY OF GARDEN GROVE, CALIFORNIA


SURVEY OF WEST ST. & MORGAN LN. TB NO. 3 PAGE 17
SURVEY BY PRICKETT & PARTY TRACT NO 3246
DATE JAN. 28, 1971

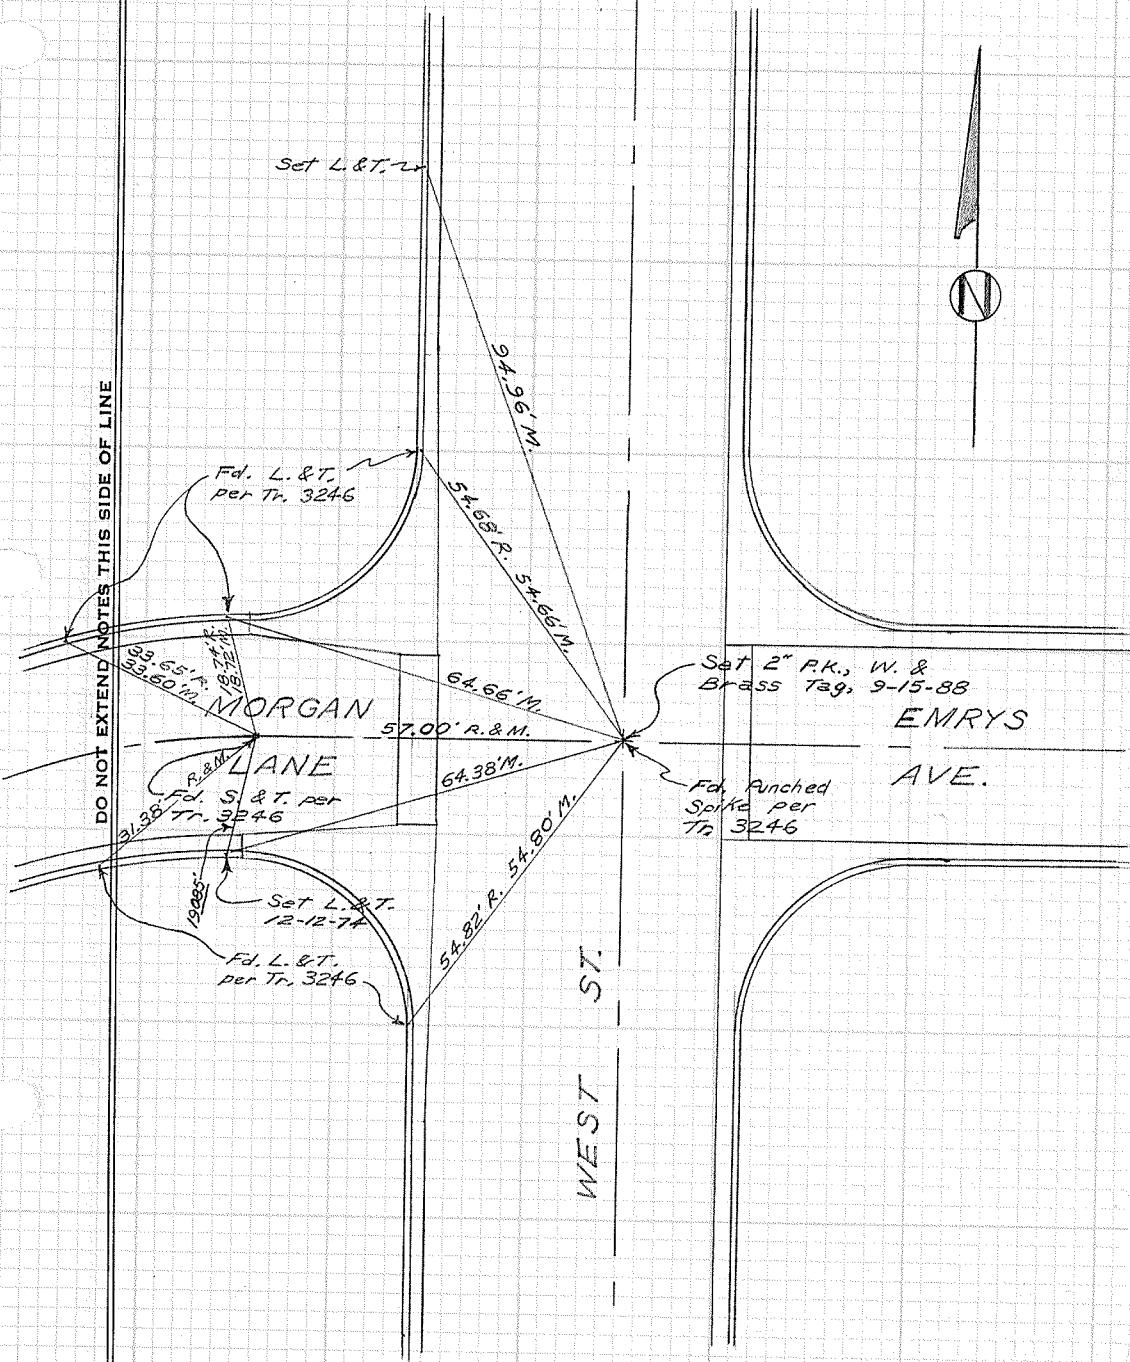

CITY OF GARDEN GROVE, CALIFORNIA


SURVEY OF WEST ST. & COMSTOCK RD. T.B. NO. 3 PAGE 18
SURVEY BY PRICKETT & PARTY TRACT NO. 2408
DATE FEB. 22, 1971

DO NOT EXTEND NOTES THIS SIDE OF LINE

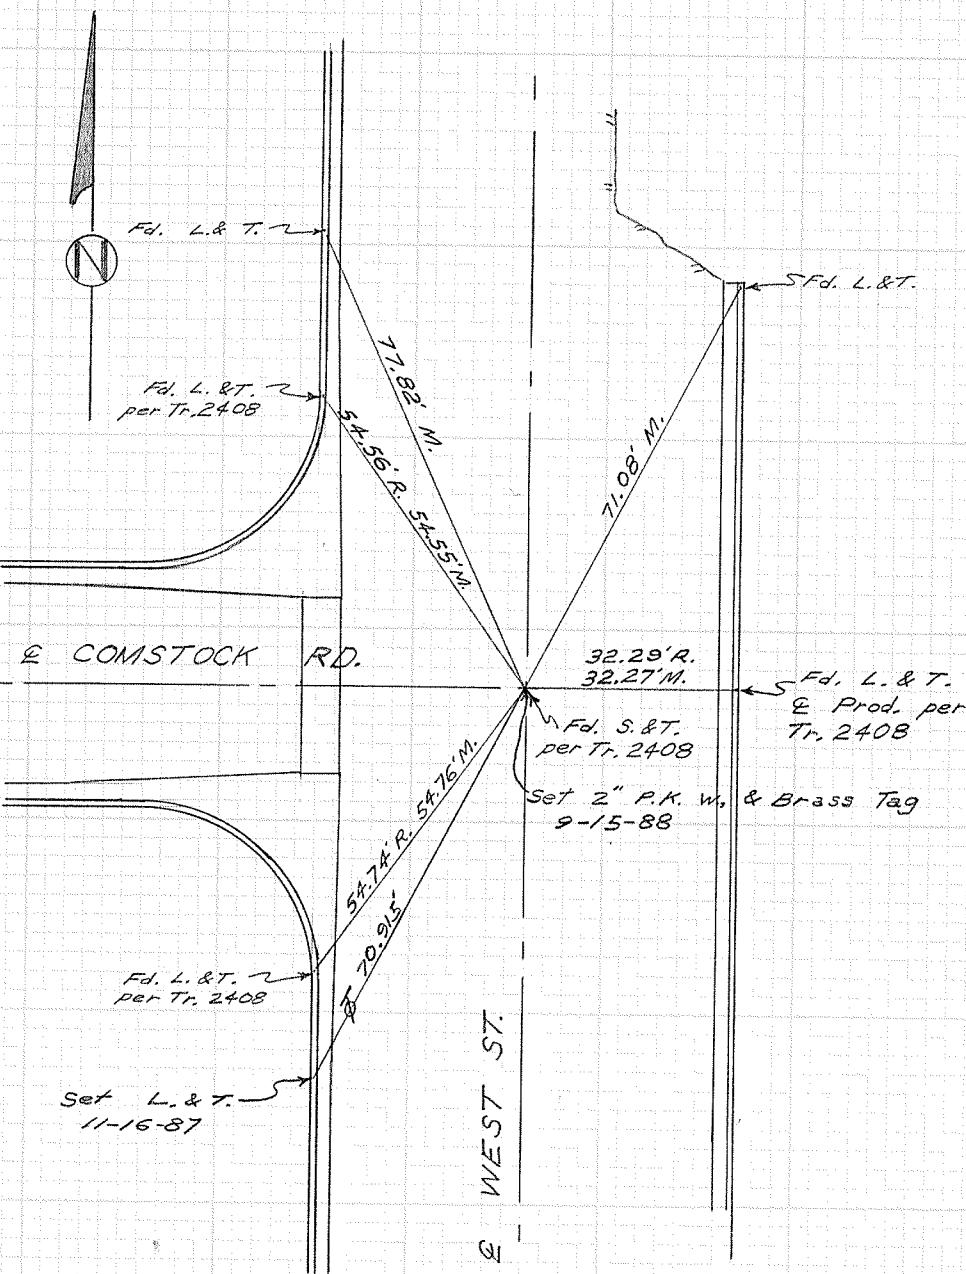

CITY OF GARDEN GROVE, CALIFORNIA

SURVEY OF WEST ST. & SHETLAND RD. TB NO. 3 PAGE 19
SURVEY BY PRICKETT & PARTY TRACT NO. 2408
DATE FEB. 22, 1971

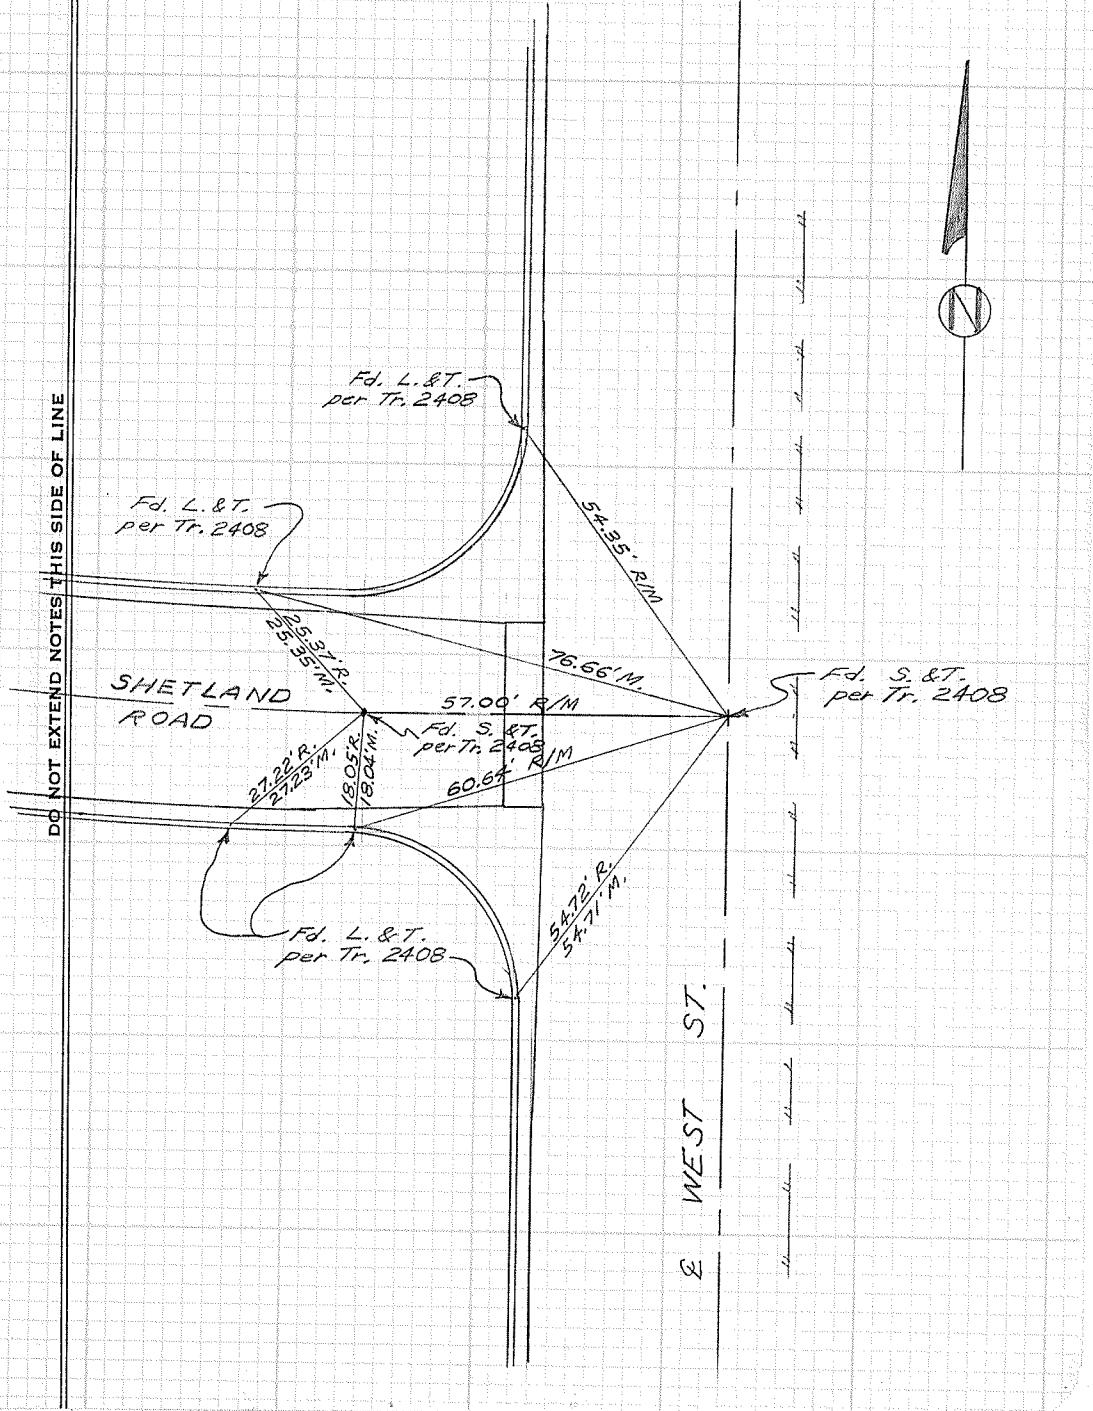

CITY OF GARDEN GROVE, CALIFORNIA


SURVEY OF West St. & Shetland Rd. T.B. NO. 3 PAGE 19A

SURVEY BY Prickett & Party TRACT NO. 2408

DATE Nov. 16, 1987

SURVEYORS SERVICE COMPANY. STA MESA STOCK NO. 411

DO NOT EXTEND NOTES THIS SIDE OF LINE

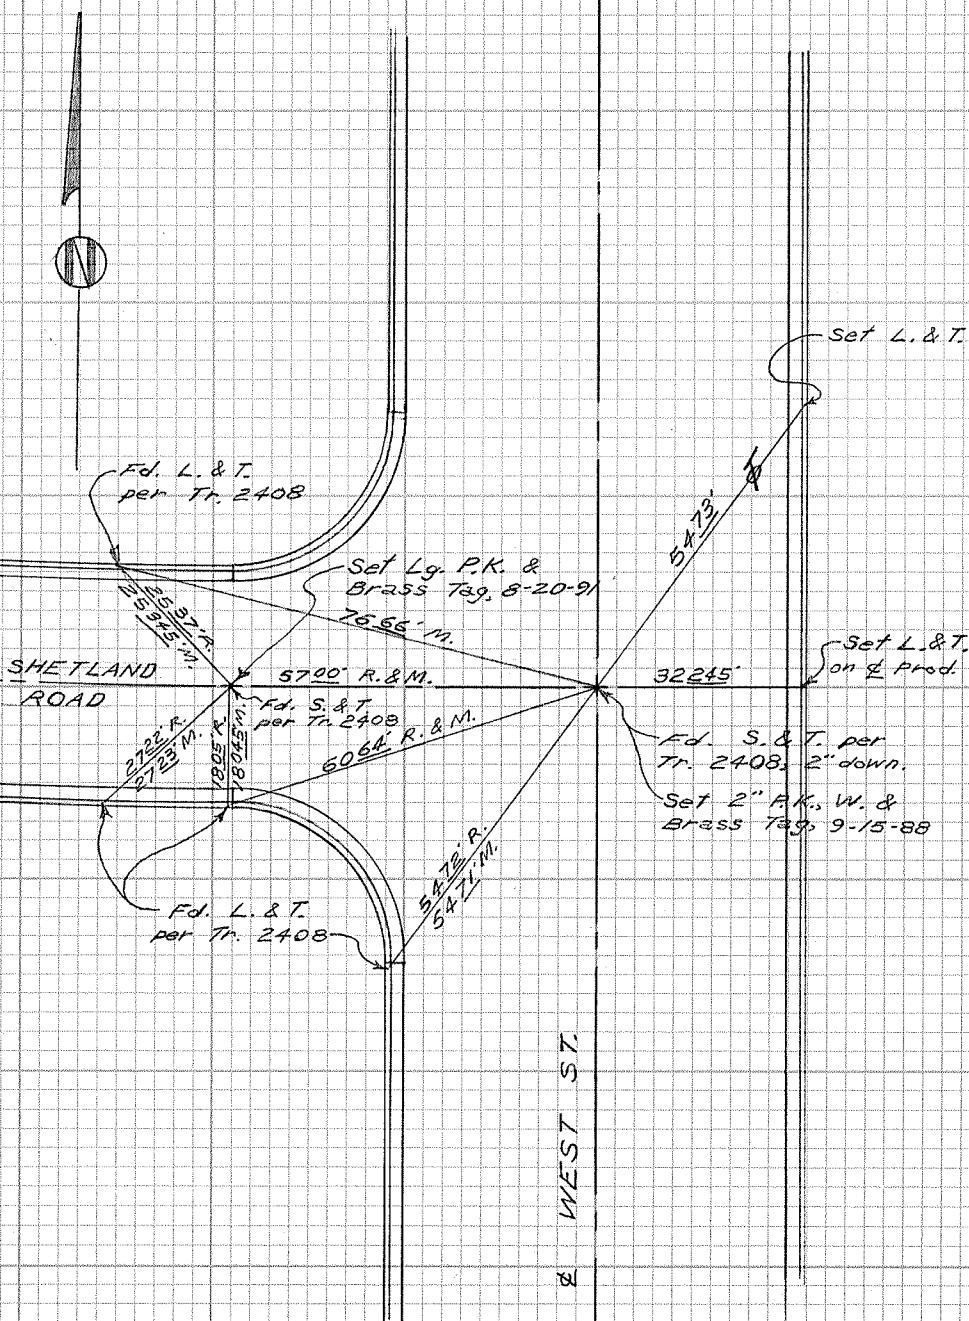


CITY OF GARDEN GROVE, CALIFORNIA

SURVEY OF WEST ST. & JOHN AVE. TB NO. 3 PAGE 20

SURVEY BY PRICKETT & PARTY TRACT NO 2234

DATE FEB. 22, 1971

DO NOT EXTEND NOTES THIS SIDE OF LINE

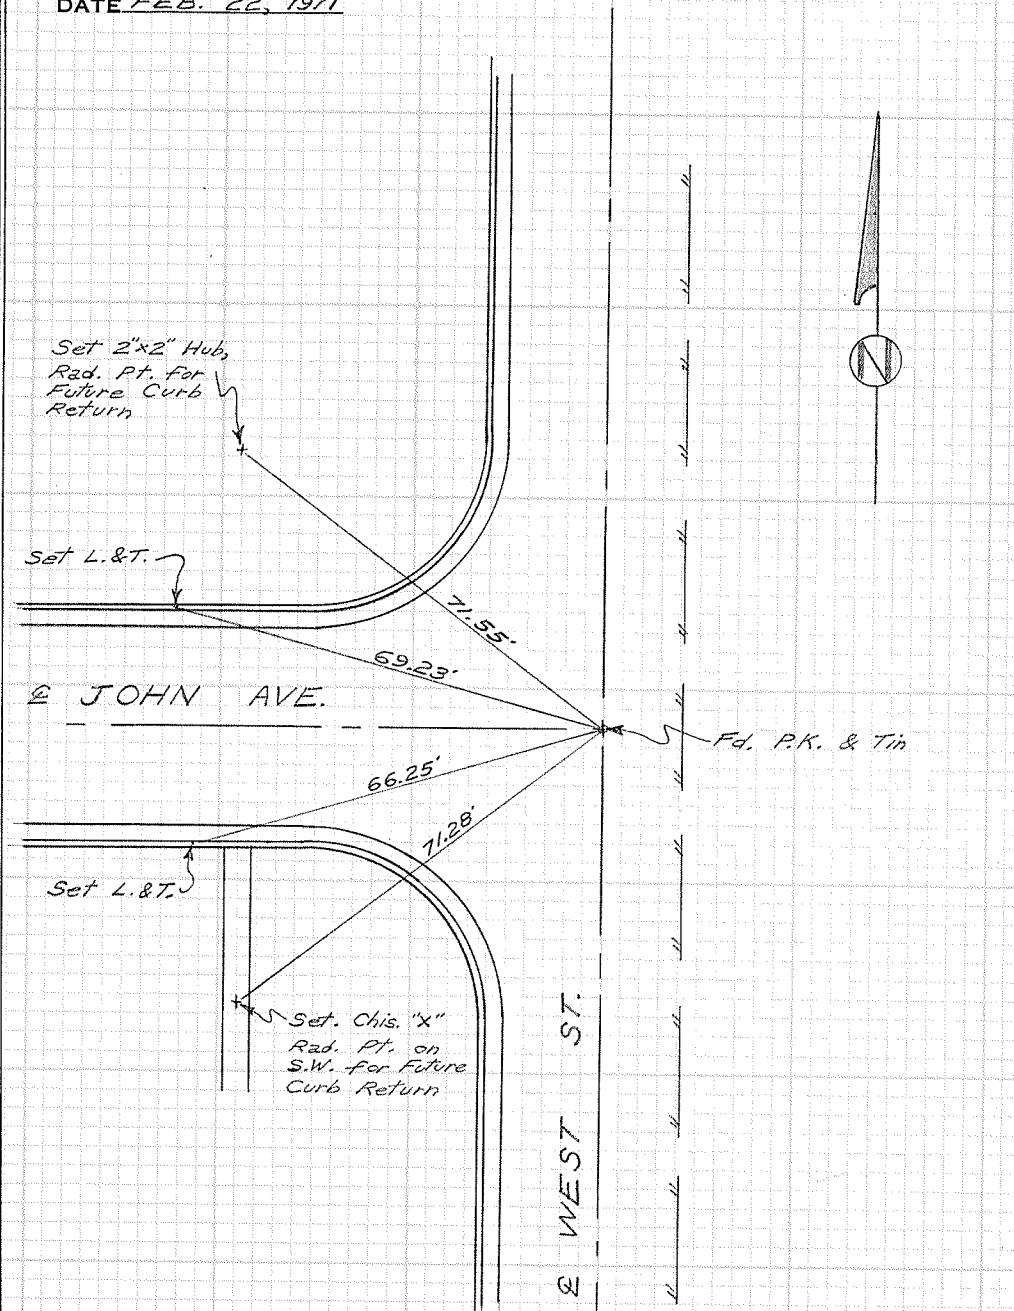

CITY OF GARDEN GROVE, CALIFORNIA

SURVEY OF West St. & John Ave. T.B. NO. 3 PAGE 20A
SURVEY BY Prickett & Party TRACT NO. 2234
DATE Sept. 19, 1988

SURVEYORS SERVICE COMPANY,

STA MESA - STOCK NO 411

DO NOT EXTEND NOTES THIS SIDE OF LINE

Fd. L. & T.
per G.G. T.B. 3,
P. 20

Fd. L. & T.
per G.G. T.B. 3,
P. 20

E JOHN AVE.

5925' R. & M.

6625' R. & M.

E WEST ST

33575' E
33535' E
Set L. & T.
Set 2" P. K. W. &
Brass T29, 9-19-88




CITY OF GARDEN GROVE, CALIFORNIA

SURVEY OF ACACIA & FIFTH ST. TB NO. 3 PAGE 21

SURVEY BY PRICKETT & PARTY TRACT NO.

DATE JUNE 23, 1971

DO NOT EXTEND NOTES THIS SIDE OF LINE

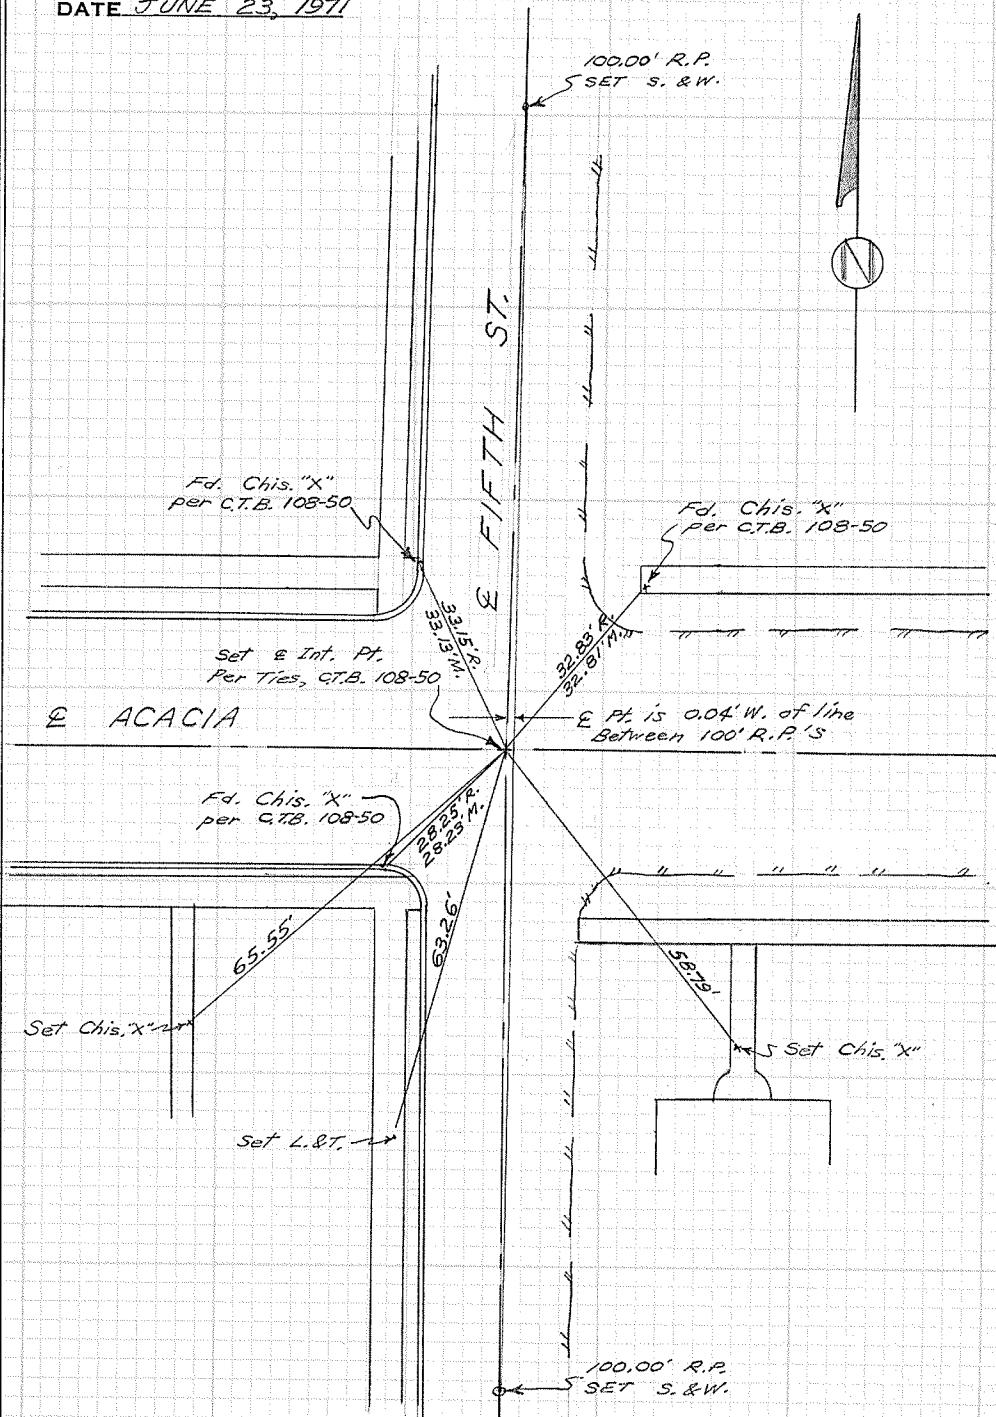

CITY OF GARDEN GROVE, CALIFORNIA


SURVEY OF Acacia PKwy. & Fifth St. T B NO. 3 PAGE 21A

SURVEY BY Prickett & Party TRACT NO.

DATE Oct. 2, 1995

SURVEYORS SERVICE COMPANY - STOCK NO. 411


DO NOT EXTEND NOTES THIS SIDE OF LINE

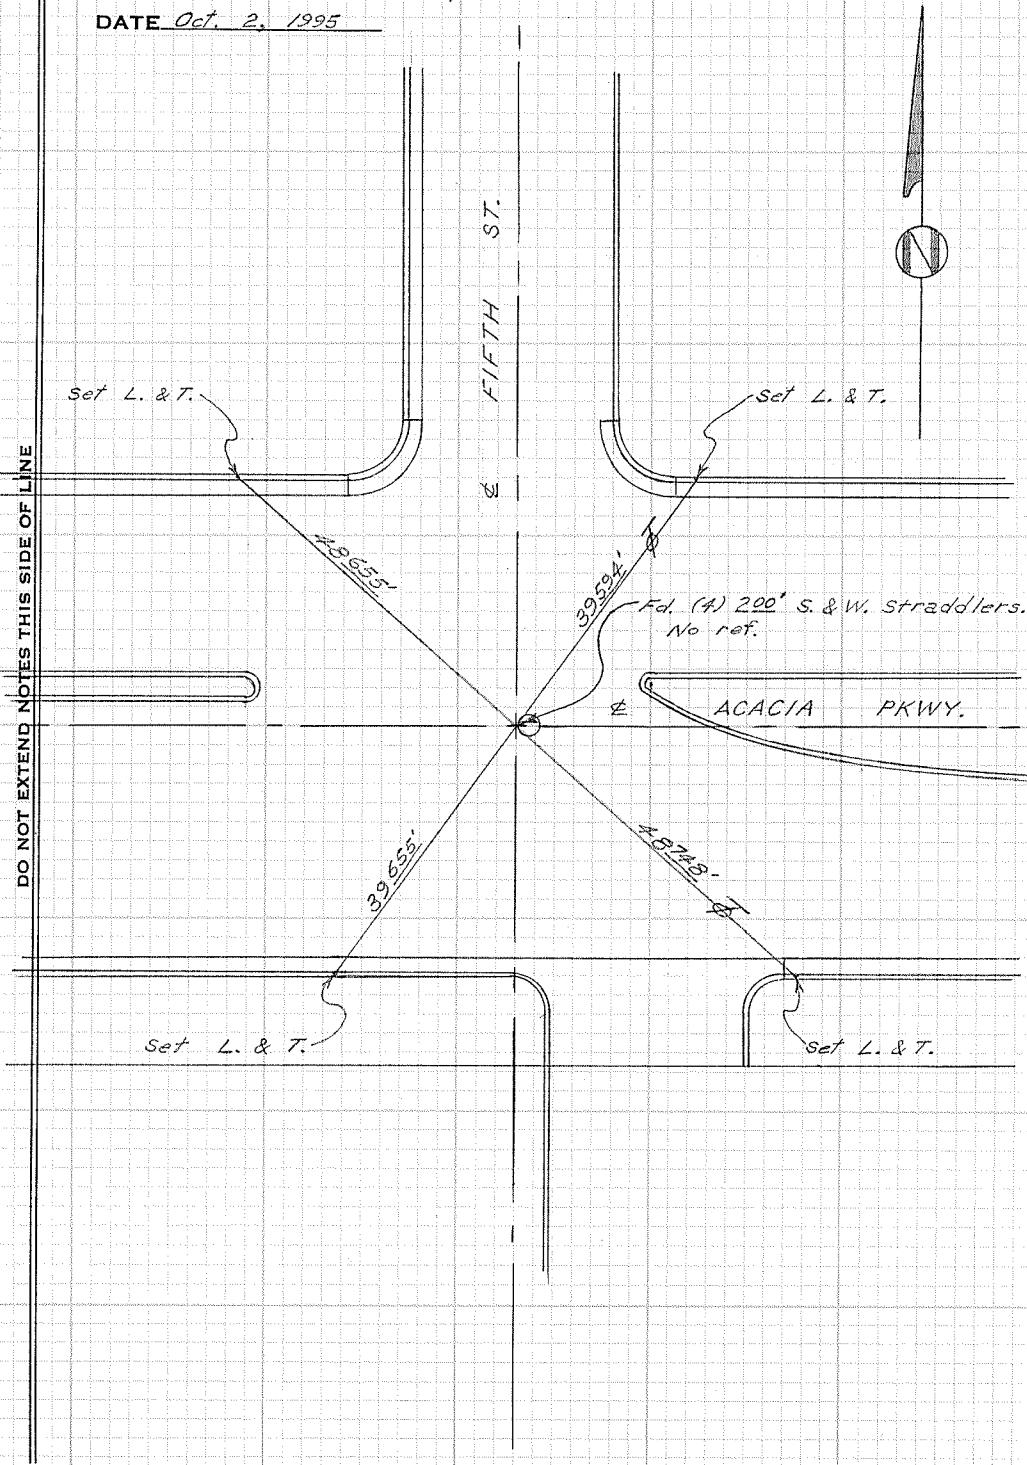

CITY OF GARDEN GROVE, CALIFORNIA

SURVEY OF ACACIA & SIXTH ST. TB NO. 3 PAGE 22
 SURVEY BY PRICKETT & PARTY TRACT NO.
 DATE JUNE 24, 1971

DO NOT EXTEND NOTES THIS SIDE OF LINE

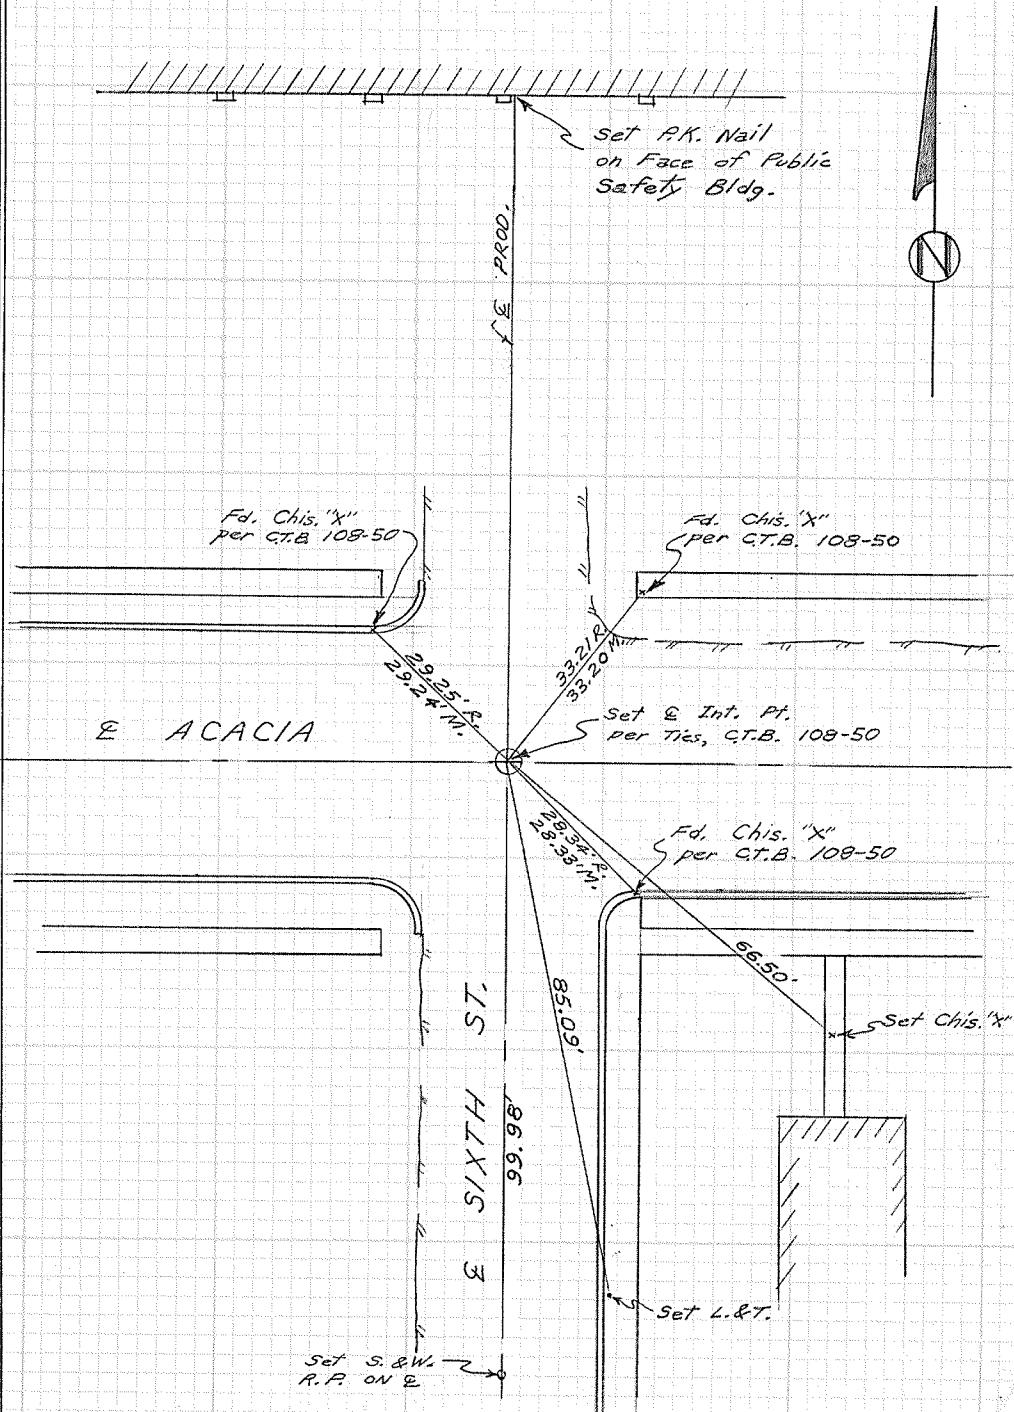


CITY OF GARDEN GROVE, CALIFORNIA

SURVEY OF Acacia Pkwy. & Sixth St. T B NO. 3 PAGE 22A
SURVEY BY Prickett & Party TRACT NO.
DATE Oct 2 1995

SURVEYORS SERVICE COMPANY STA MESA - STOCK NO. 411

DO NOT EXTEND NOTES THIS SIDE OF LINE

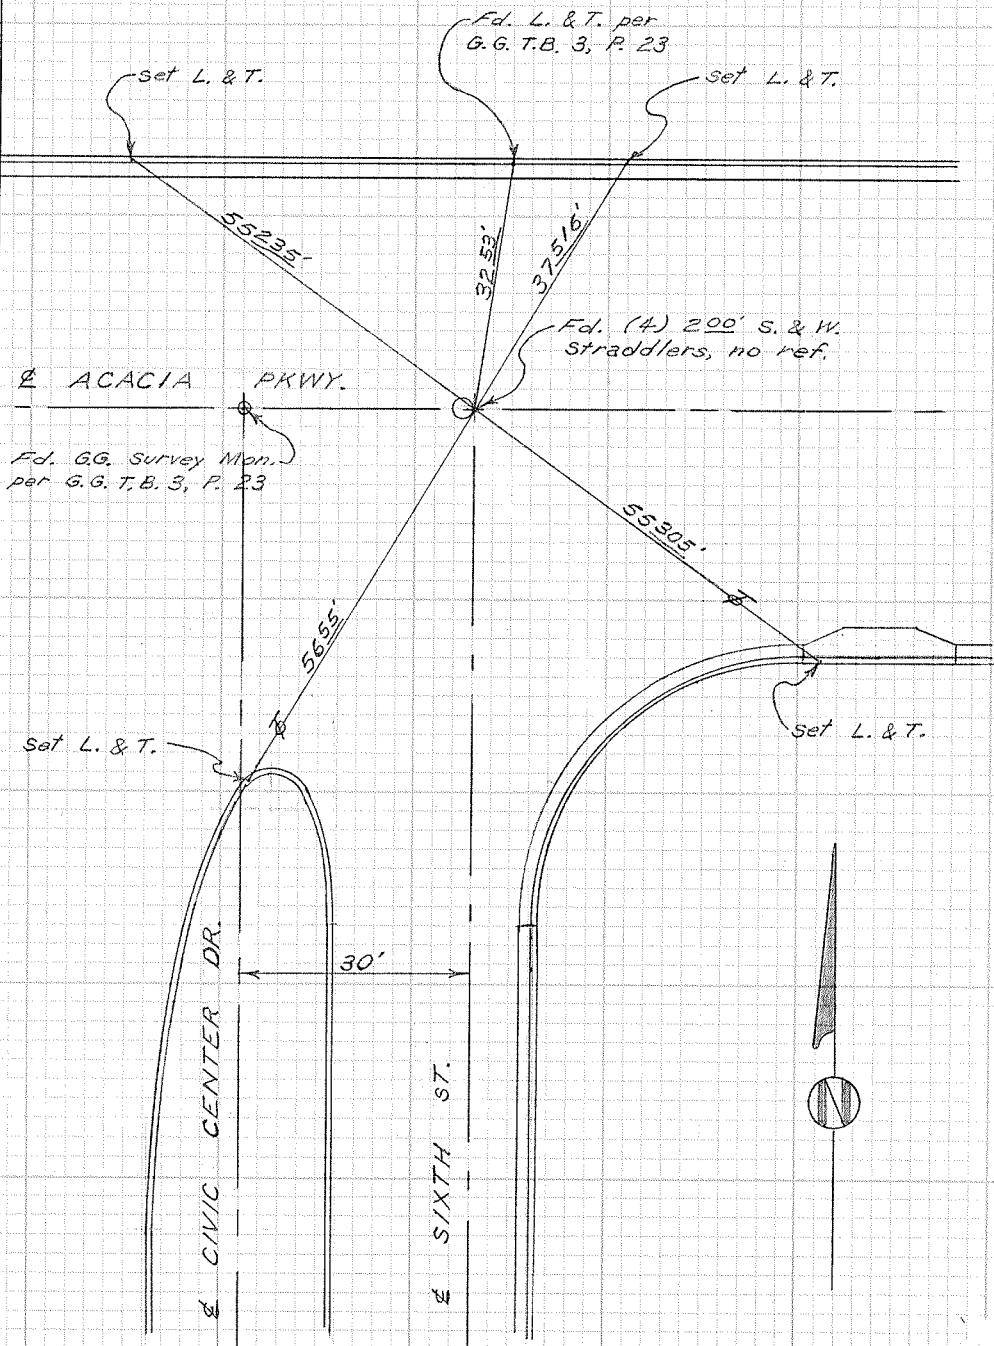

CITY OF GARDEN GROVE, CALIFORNIA

SURVEY OF Acacia Pkwy. & Eighth St. T B NO. 3 PAGE 24A


SURVEY BY Prickett & Party TRACT NO.

DATE Oct. 2, 1995

SURVEYORS SERVICE COMPANY

DOSTA MESA 1 STOCK NO. 411


DO NOT EXTEND NOTES THIS SIDE OF LINE

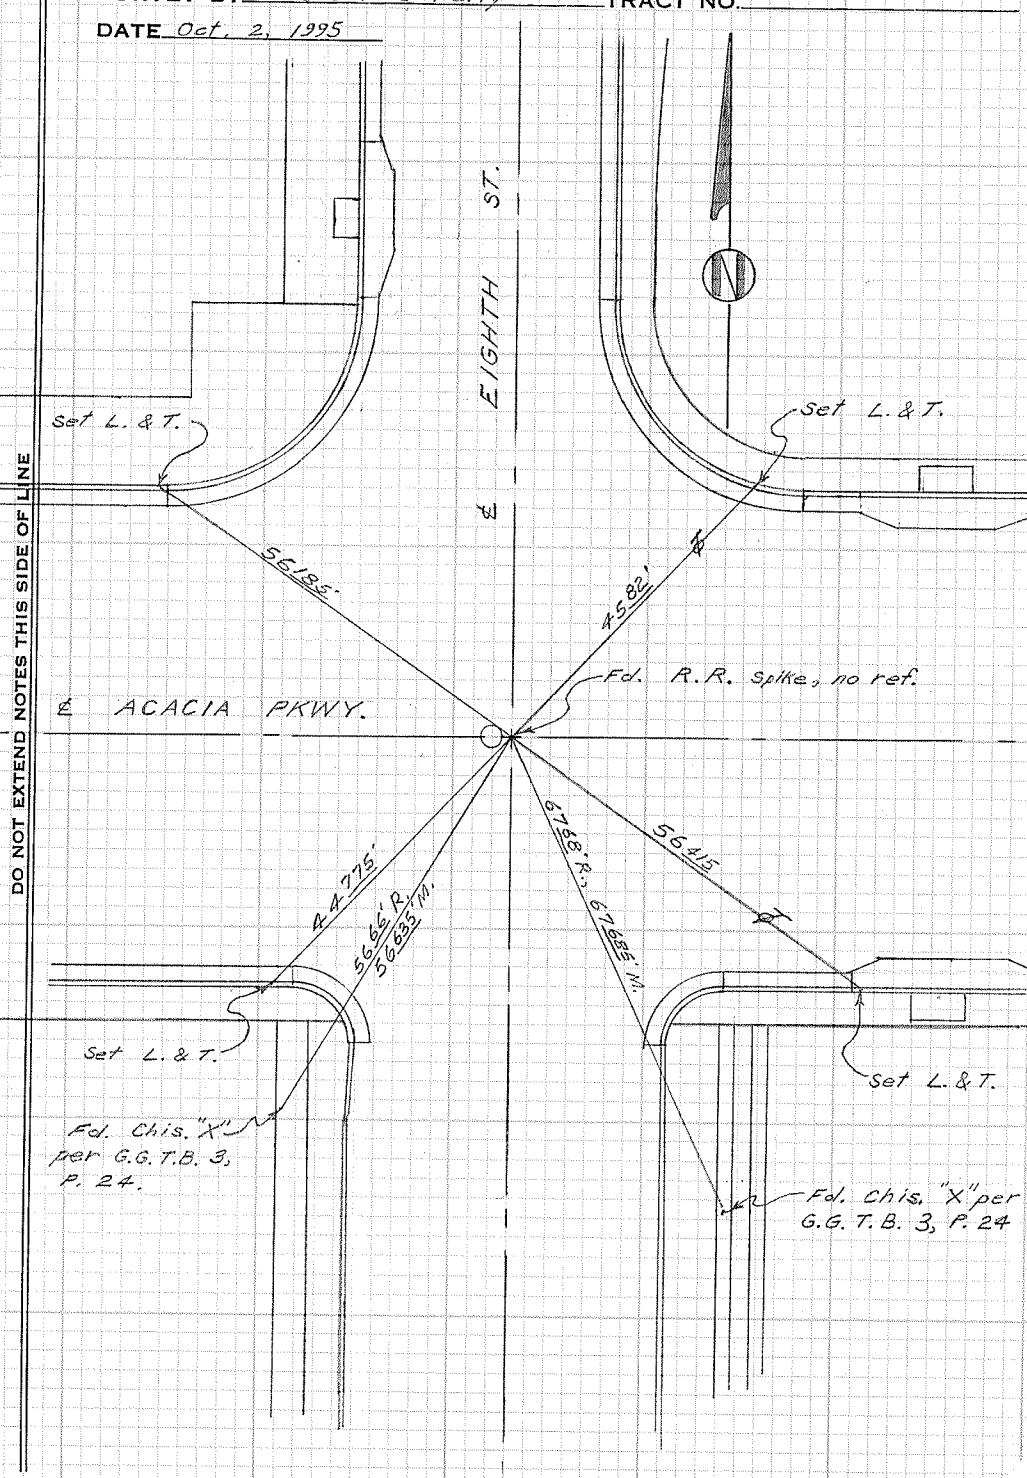

CITY OF GARDEN GROVE, CALIFORNIA

SURVEY OF ACACIA & NINTH ST. T B NO. 3 PAGE 25
SURVEY BY PRICKETT & PARTY TRACT NO.
DATE JUNE 24, 1971

DO NOT EXTEND NOTES THIS SIDE OF LINE

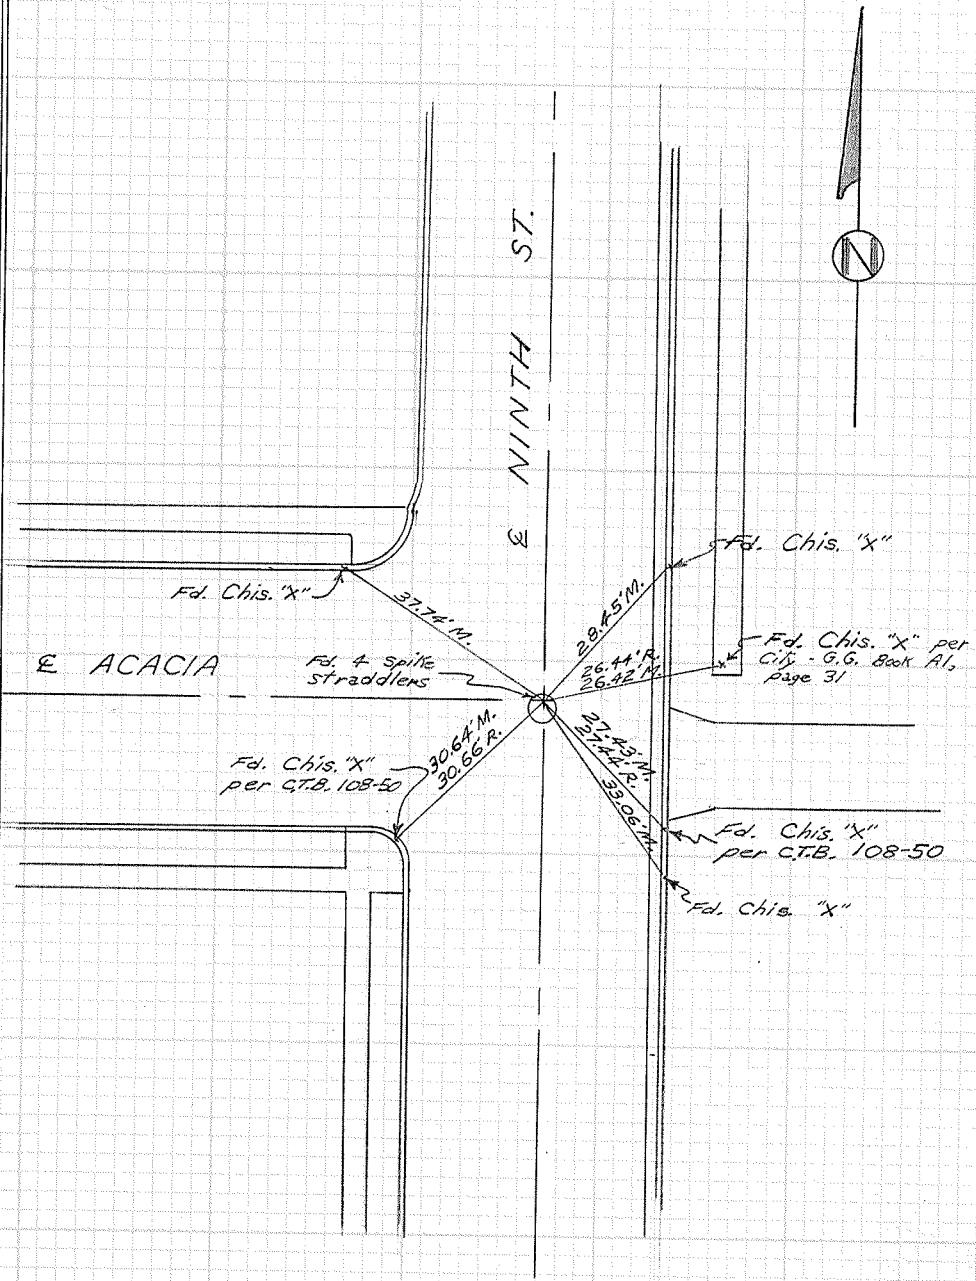


CITY OF GARDEN GROVE, CALIFORNIA

SURVEY OF Acacia & Ninth TB NO. 3 PAGE 25A
SURVEY BY Prickett & Party TRACT NO.
DATE Sept. 11, 1975

DO NOT EXTEND NOTES THIS SIDE OF LINE

STAMESA "STOCK NO: 411
SURVEYORS SERVICE COMPANY,

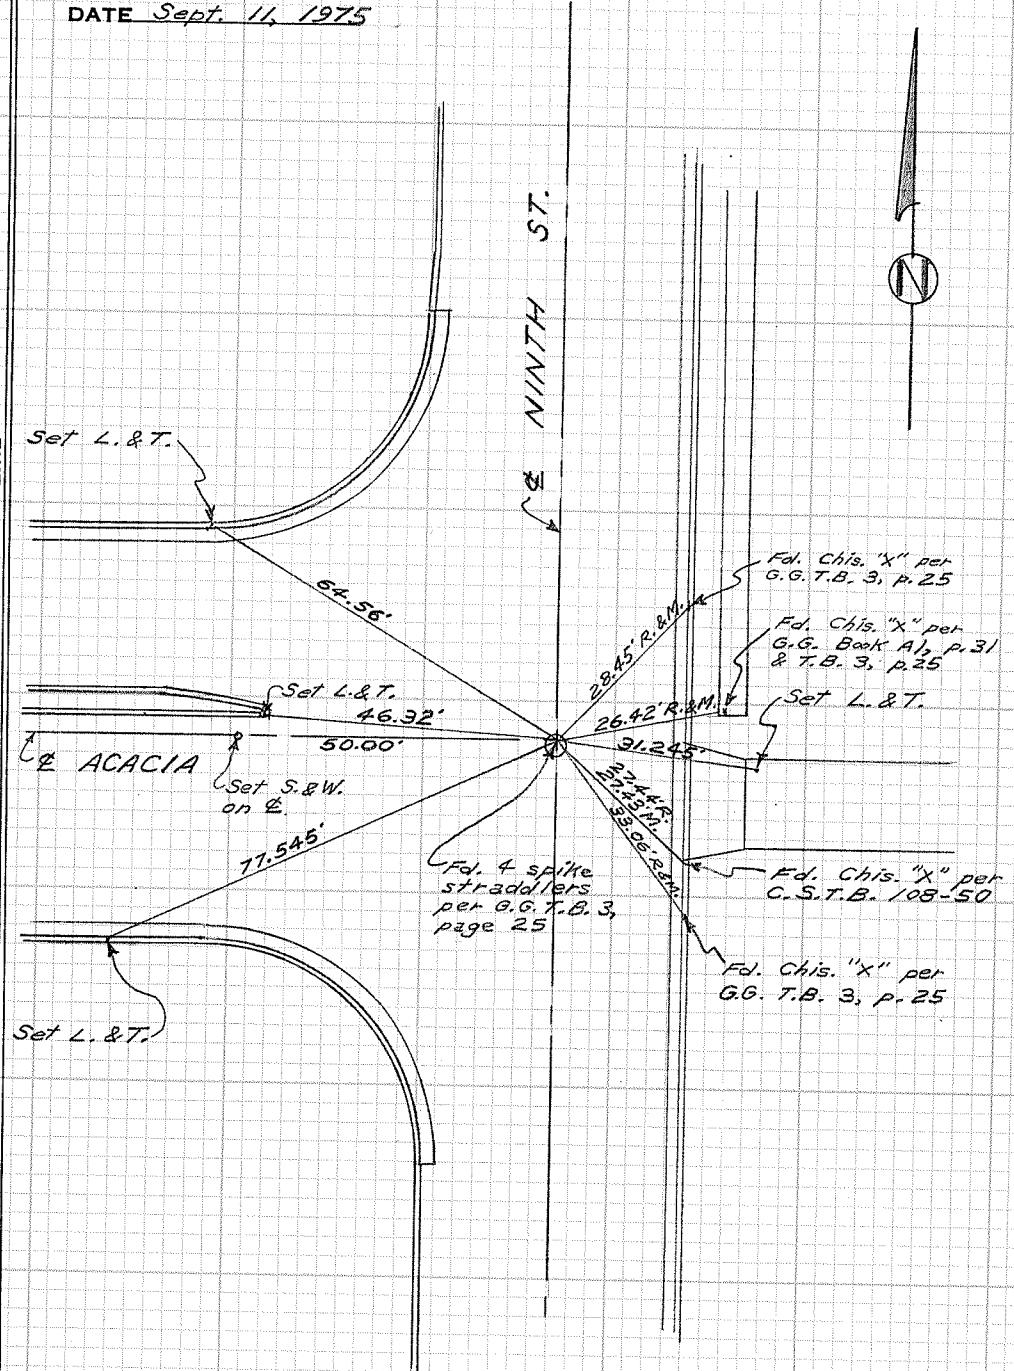

CITY OF GARDEN GROVE, CALIFORNIA

SURVEY OF Ninth St. & Acacia Parkway T B NO. 3 PAGE 25B

SURVEY BY Prickett & Party TRACT NO.

DATE Dec. 18, 1991

TA MESA - STOCK NO. 411

SURVEYORS SERVICE COMPANY:

DO NOT EXTEND NOTES THIS SIDE OF LINE

Fd. L. & T. per
G.G. T.B. 3, P. 25A

ACACIA PKWY.

Fd. S. & W. on E.
per G.G. T.B. 3,
P. 25A.

4632' R., 46303' M

5000' R. & M.

77545' R., 77548' M.

Fd. (1) 300' & (3)
200' S. & W. X-ties.
Set P.M.'s (1-1) on M.H.
R/m, 3-24-93

6435' R., 64544' M.

31245' R.
31247' M.


NINTH STREET

E

2327'

Set L. & T.


Fd. L. & T. per
G.G. T.B. 3, P. 25A.

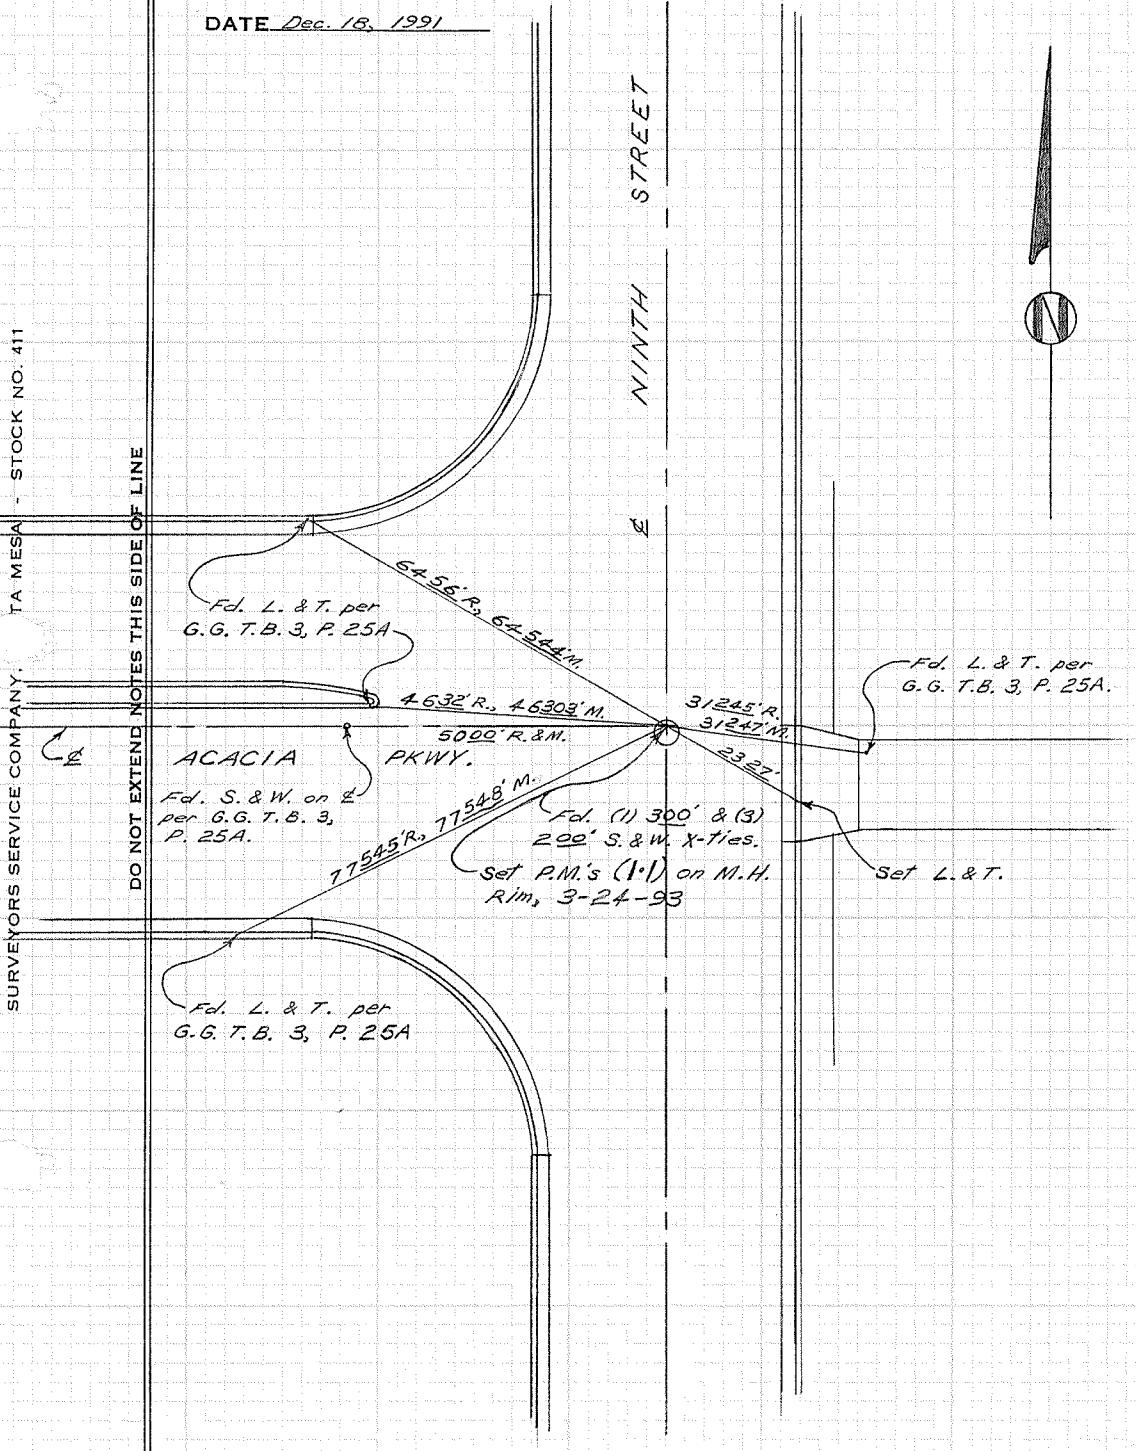

CITY OF GARDEN GROVE, CALIFORNIA

SURVEY OF LAMPSON & MONARCH T. B NO. 3 PAGE 26
 SURVEY BY PRICKETT & PARTY TRACT NO.
 DATE FEB. 29, 1972

DO NOT EXTEND NOTES THIS SIDE OF LINE

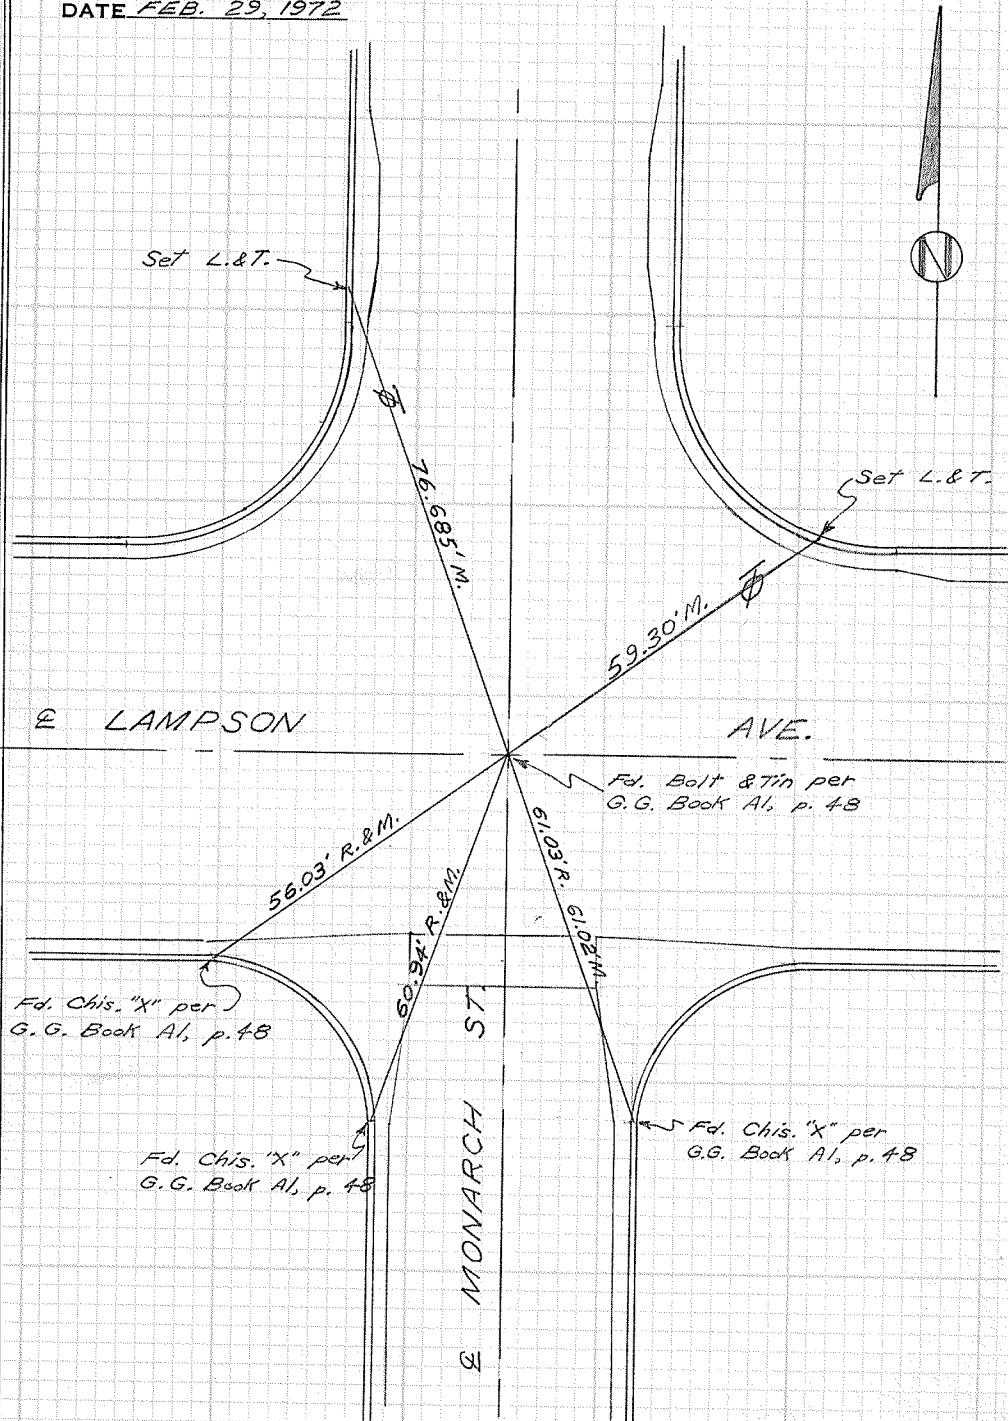


CITY OF GARDEN GROVE, CALIFORNIA

SURVEY OF CHAPMAN & INDUSTRY T B NO. 3 PAGE 27
 SURVEY BY PRICKETT & PARTY TRACT NO.
 DATE FEB. 29, 1972

DO NOT EXTEND NOTES THIS SIDE OF LINE


SURVEYORS SERVICE COMPANY, TA MESA - STOCK NO. 411

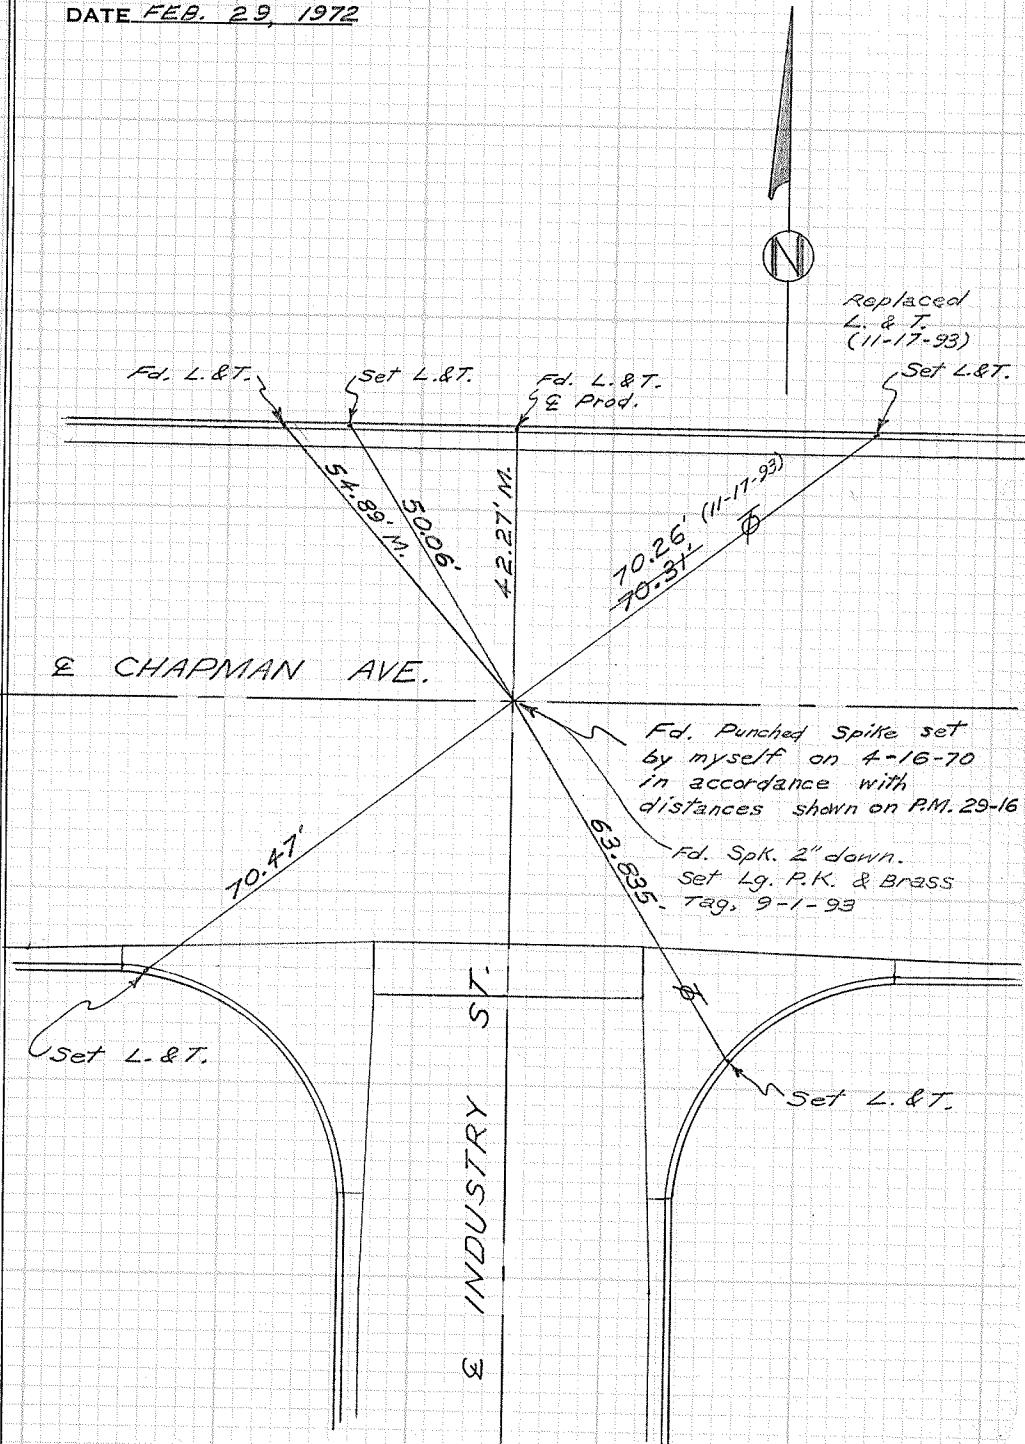

CITY OF GARDEN GROVE, CALIFORNIA

SURVEY OF MONARCH & CHAPMAN T B NO. 3 PAGE 28
SURVEY BY PRICKETT & PARTY TRACT NO.
DATE FEB. 29, 1972


DO NOT EXTEND NOTES THIS SIDE OF LINE

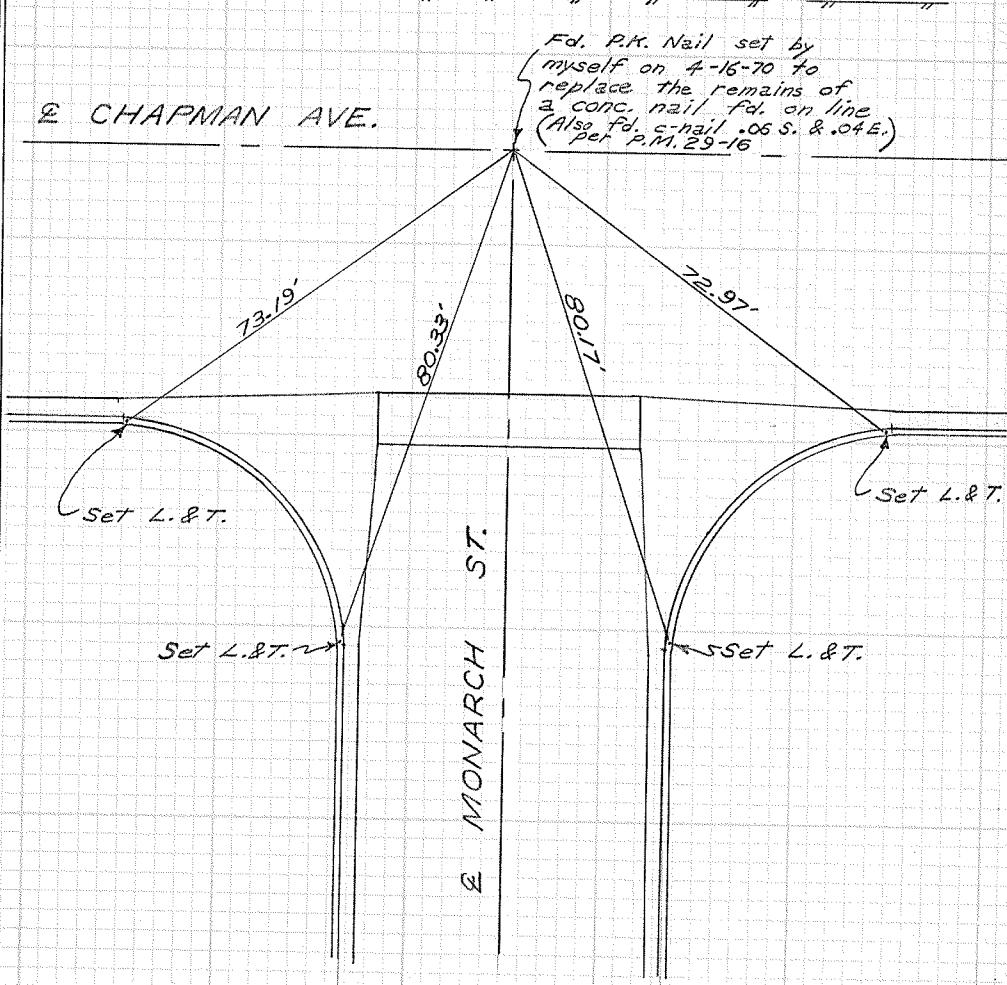

CITY OF GARDEN GROVE, CALIFORNIA

SURVEY OF KNOTT & BELGRAVE TB NO. 3 PAGE 29
 SURVEY BY PRICKETT & PARTY TRACT NO.
 DATE MARCH 1, 1972


DO NOT EXTEND NOTES THIS SIDE OF LINE

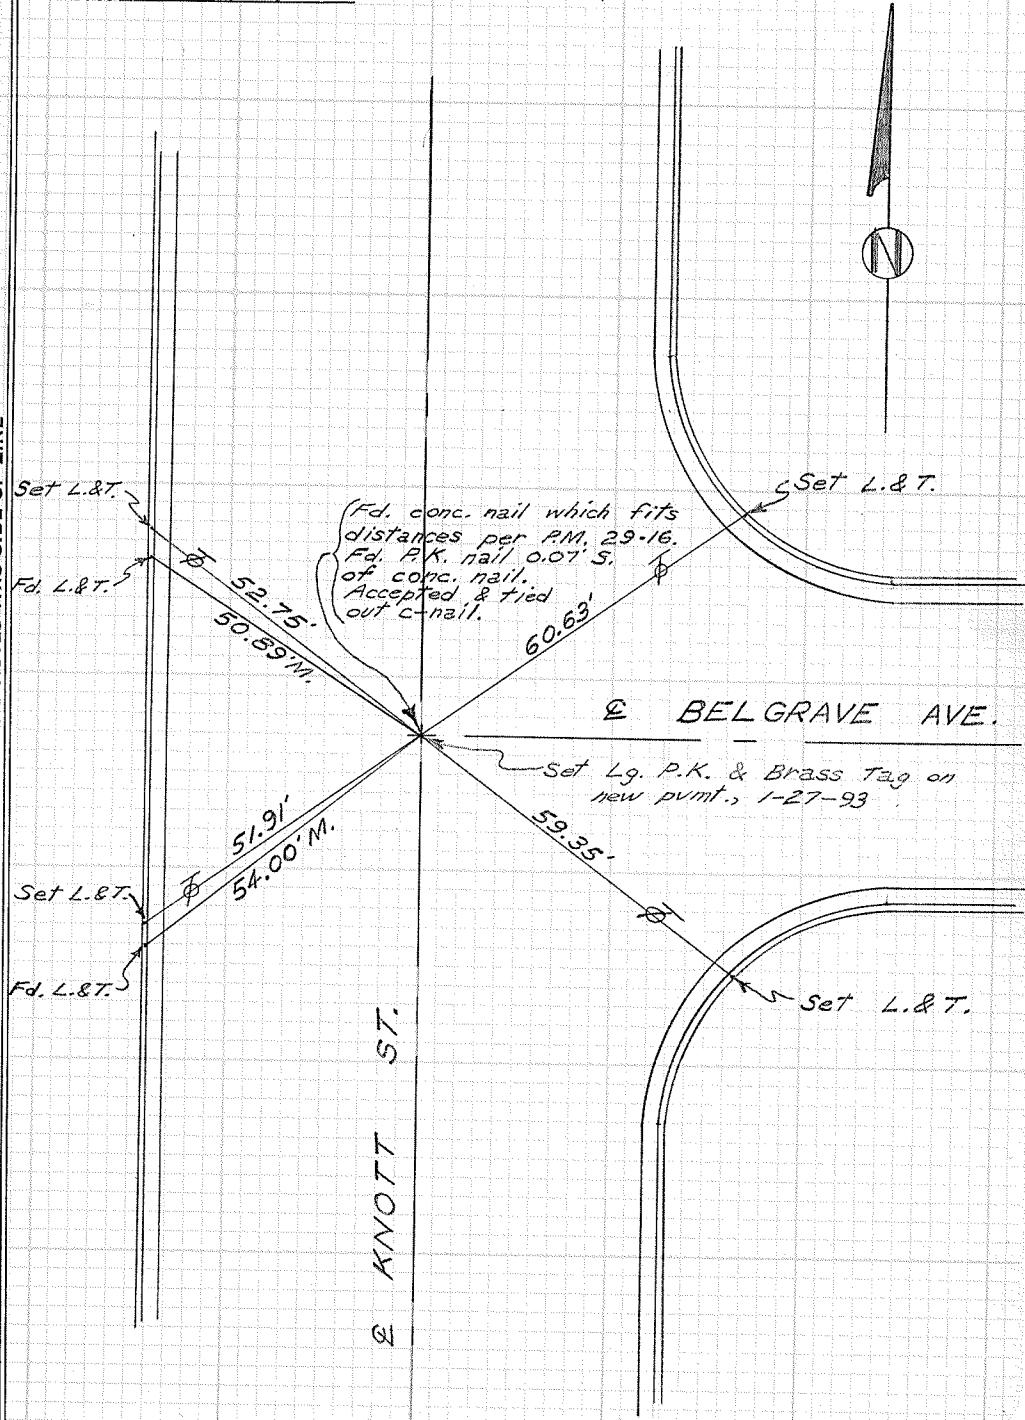

CITY OF GARDEN GROVE, CALIFORNIA

SURVEY OF Taft St. & Dorothy Ave. TB NO. 3 PAGE 30
SURVEY BY Tugole & Party TRACT NO. _____
DATE May 17, 1972

DO NOT EXTEND NOTES THIS SIDE OF LINE

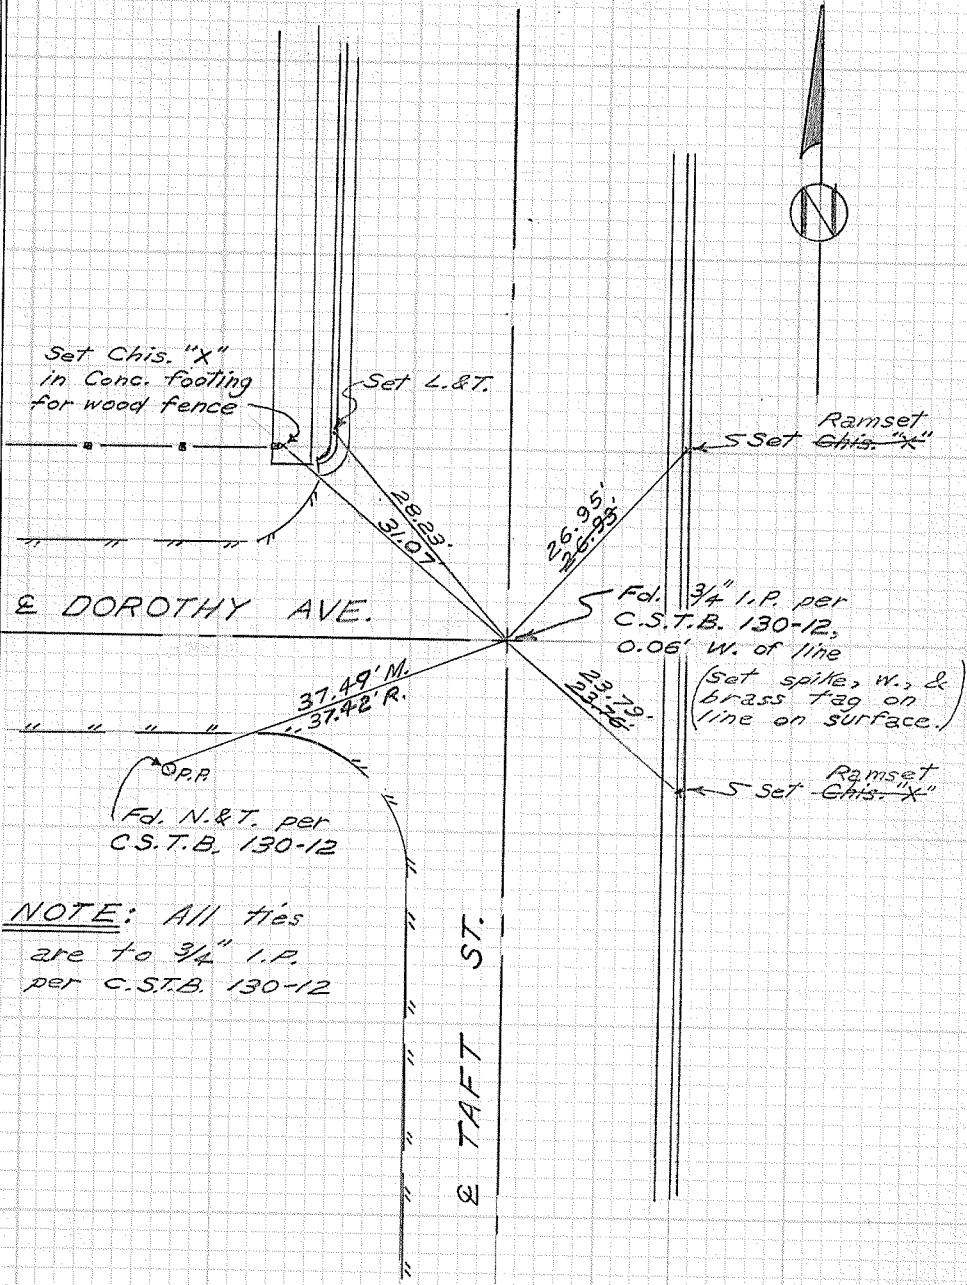

SURVEYORS SERVICE COMPANY - STA MESA - STOCK NO. 411

CITY OF GARDEN GROVE, CALIFORNIA

SURVEY OF Taft St. & Dorothy Ave. T B NO. 3 PAGE 30A
 SURVEY BY Prickett & Party TRACT NO.
 DATE Aug. 22, 1983

SURVEYORS SERVICE COMPANY STA MESA - STOCK NO. 411

SURVEYORS SERVICE COMPANY

DO NOT EXTEND NOTES THIS SIDE OF LINE

E DOROTHY AVE.

50.00'

Set S. & W. on E

Set L. & T.
11-10-83

NOTE: All ties
are to SPK., W. &
Brass Tag set on
line.

36°35'

36°35'

30.00'

36°35'

36°35'

30.00'

Fd. Spk., W. & Brass Tag
per G.G. TAB 3, p. 30,
0.03' E. of line.

Set Brass Tack
in 1"x2" Hub
on E Prod.

Set Spk., W. & Brass Tag
on line on new prmt.
11-10-83, 0.03' E.
of 34" I.P. location
per C.S.T.B. 130-12

Set L. & T.
11-10-83

Set L. & T.
11-10-83


CITY OF GARDEN GROVE, CALIFORNIA

SURVEY OF Taft St. & Frances Ave. T B NO. 3 PAGE 31

SURVEY BY Tugge & Party TRACT NO.

DATE May 17 1972

DO NOT EXTEND NOTES THIS SIDE OF LINE

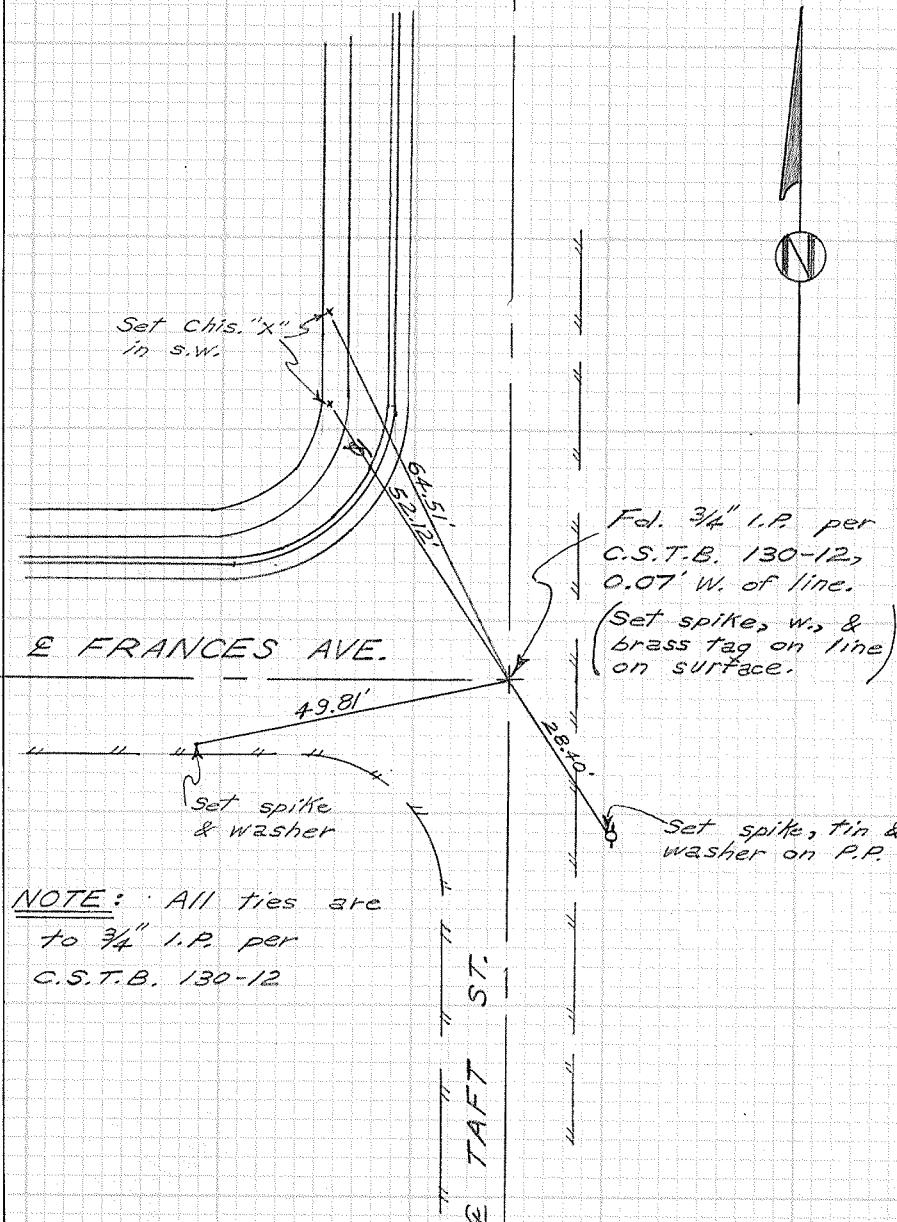


CITY OF GARDEN GROVE, CALIFORNIA

SURVEY OF Taft St. & Frances Ave. T B NO. 3 PAGE 31A
SURVEY BY Prickett & Party TRACT NO.
DATE August 22, 1983

SURVEYORS SERVICE COMPANY

STA MESA - STOCK NO. 411

DO NOT EXTEND NOTES THIS SIDE OF LINE

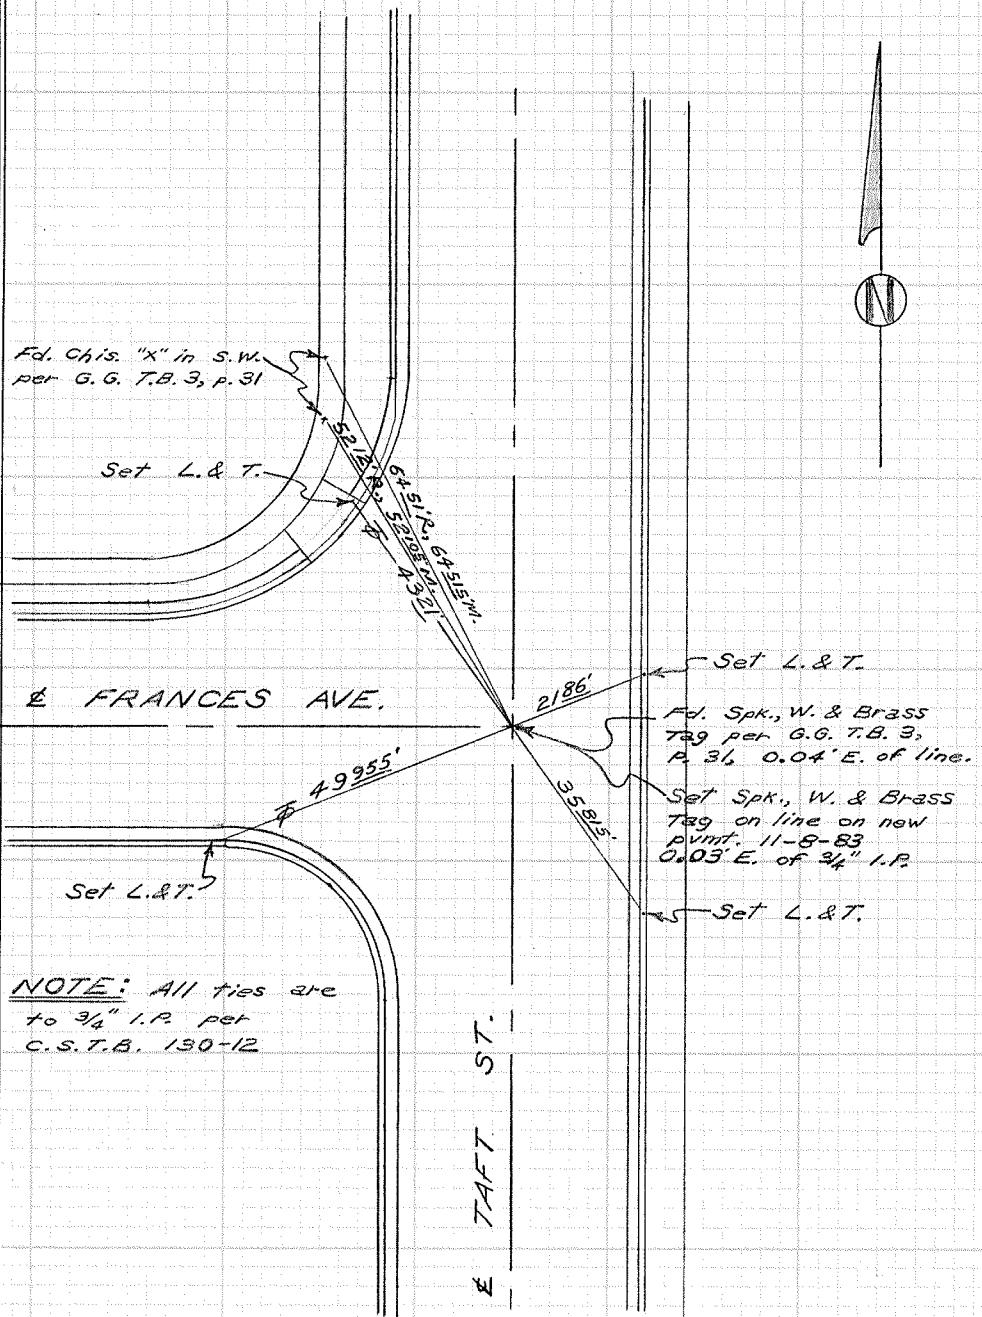

CITY OF GARDEN GROVE, CALIFORNIA

SURVEY OF ~~Taff St. & McKeen~~

TB NO. 3 PAGE 32

SURVEY BY ~~Prickett & Party~~

TRACT NO.

DATE April 22, 1974

DO NOT EXTEND NOTES THIS SIDE OF LINE

Set S. & W.
on A.C.

34.78'

SE MC KEEN

Set Chis. "X"
on S.W.

NOTE: All ties
are to $\frac{3}{4}$ " I.P.
per C.S.T.B. 130-13

47.44'


E TAFF ST. ↗

38.94'

17.81'

Fd. $\frac{3}{4}$ " I.P. 8" deep per
C.S.T.B. 130-13; iron pipe
is 0.04" W. of line.

(Set 6" spike & brass
tag on surface on line.)

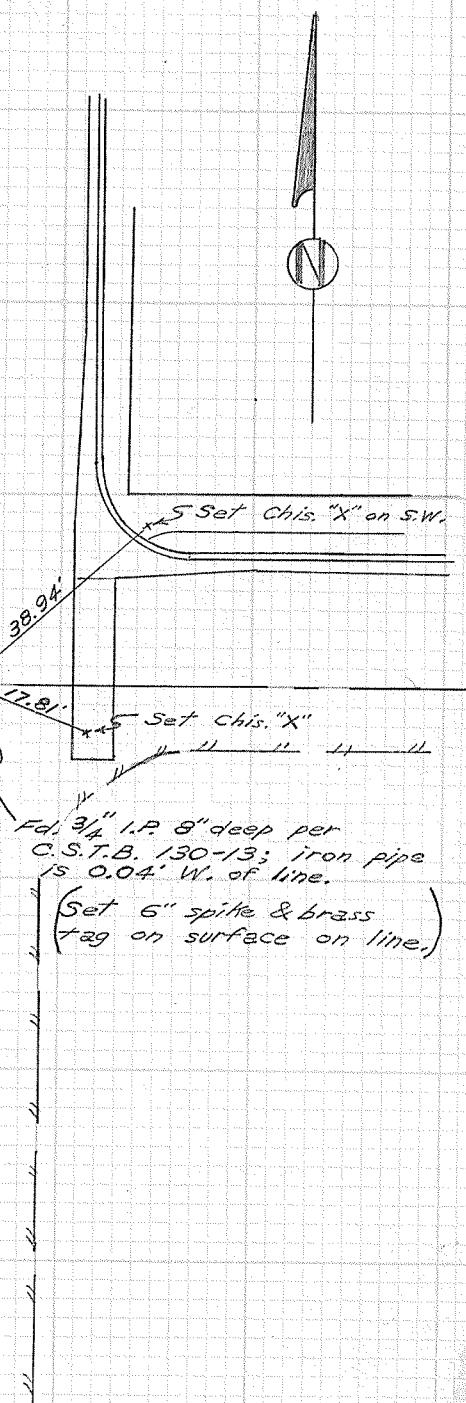

CITY OF GARDEN GROVE, CALIFORNIA

SURVEY OF Taft St. & McKeen T B NO. 3 PAGE 32A
 SURVEY BY Prickett & Party TRACT NO. 645
 DATE Aug. 22, 1983

STA MESA - STOCK NO. 411

SURVEYORS SERVICE COMPANY

DO NOT EXTEND NOTES THIS SIDE OF LINE

E MC KEEN ST.

Fd. Chis. "+" \angle
on S.W. per G.G.
T.B. 3, p. 32
Set L. & T.

NOTE: All ties
are to location
of $3\frac{1}{4}$ " I.P. per
C.S.T.B. 130-13

TAFT ST.

52 515'

X 725' R. 8M
X 892'

Set PK. per ties, G.G.
T.B. 3, p. 32. 6-9-83
Set Spk., W., & Brass Tag
on line on new pmt. 11-8-83
0.03" E. of $9\frac{1}{4}$ " I.P. location.
X 135-

Set L. & T.

Set L. & T.

CITY OF GARDEN GROVE, CALIFORNIA

SURVEY OF Garden Grove Blvd. & Fourth T.B. NO. 3 PAGE 33

SURVEY BY Prickett & Party TRACT NO.

DATE April 11, 1973

DO NOT EXTEND NOTES THIS SIDE OF LINE

EUCLID AVE.

Fd. L. & T. M.
per CITY
T.B. 2, p. 138

E GARDEN

Fd. L. & T.
per CITY
T.B. 2, p. 138

E FOURTH ST.

59.32'

42.28'

53.92'


42.49'

GROVE BLVD.

Fd. S. & W. per ST. HWY.
Notes A3/9.001, p. 57

SET L. & T.
on E Prod.


Set L. & T.
Son E

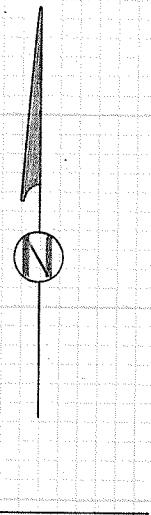

CITY OF GARDEN GROVE, CALIFORNIA

SURVEY OF Garden Grove Blvd. & Fifth TB NO. 3 PAGE 34
 SURVEY BY Prickett & Party TRACT NO.
 DATE April 11, 1973

DO NOT EXTEND NOTES THIS SIDE OF LINE

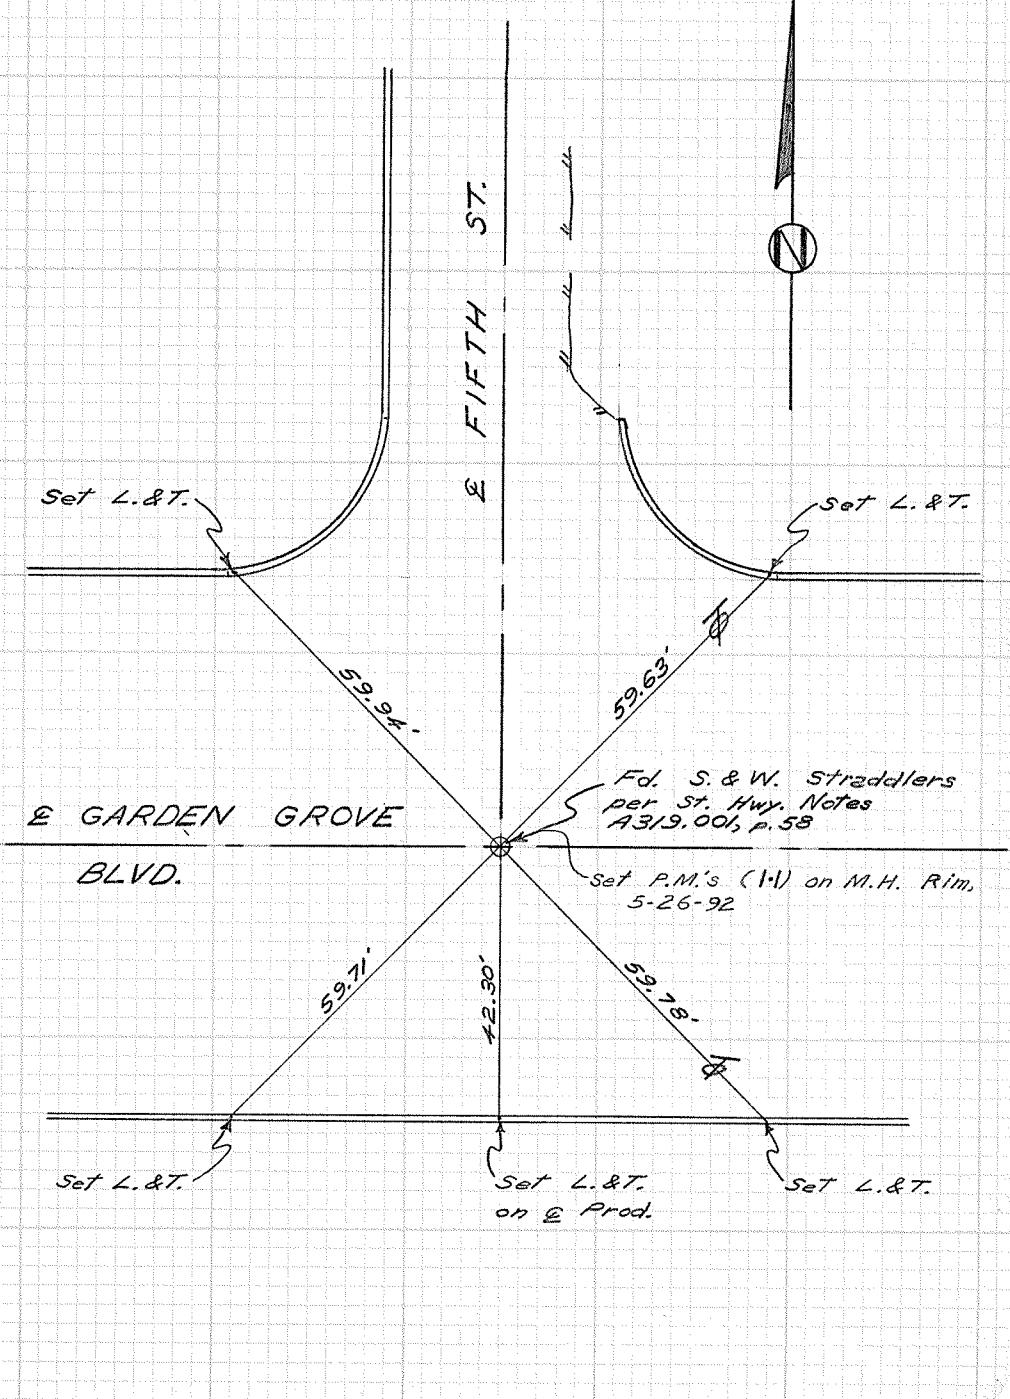

CITY OF GARDEN GROVE, CALIFORNIA


Garden Grove Blvd &
SURVEY OF Civic Center Dr.

TB NO. 3 PAGE 35

SURVEY BY Prickett & Party TRACT NO.

DATE April 11, 1973


DO NOT EXTEND NOTES THIS SIDE OF LINE

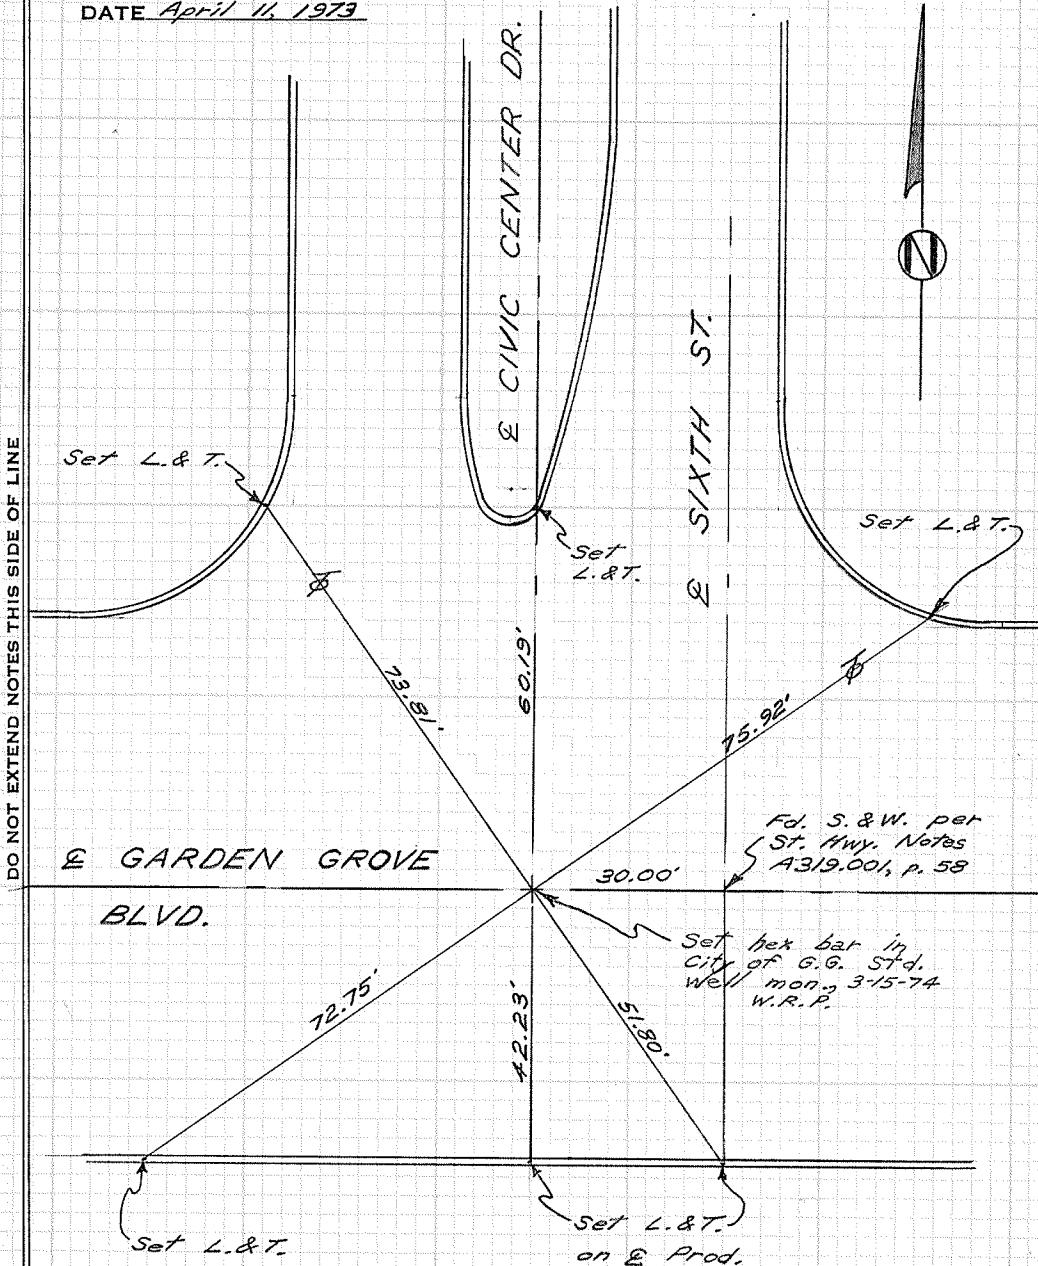

CITY OF GARDEN GROVE, CALIFORNIA

SURVEY OF Garden Grove Blvd. & Seventh TB NO. 3 PAGE 36
SURVEY BY Prickett & Party TRACT NO.
DATE April 11, 1973


DO NOT EXTEND NOTES THIS SIDE OF LINE

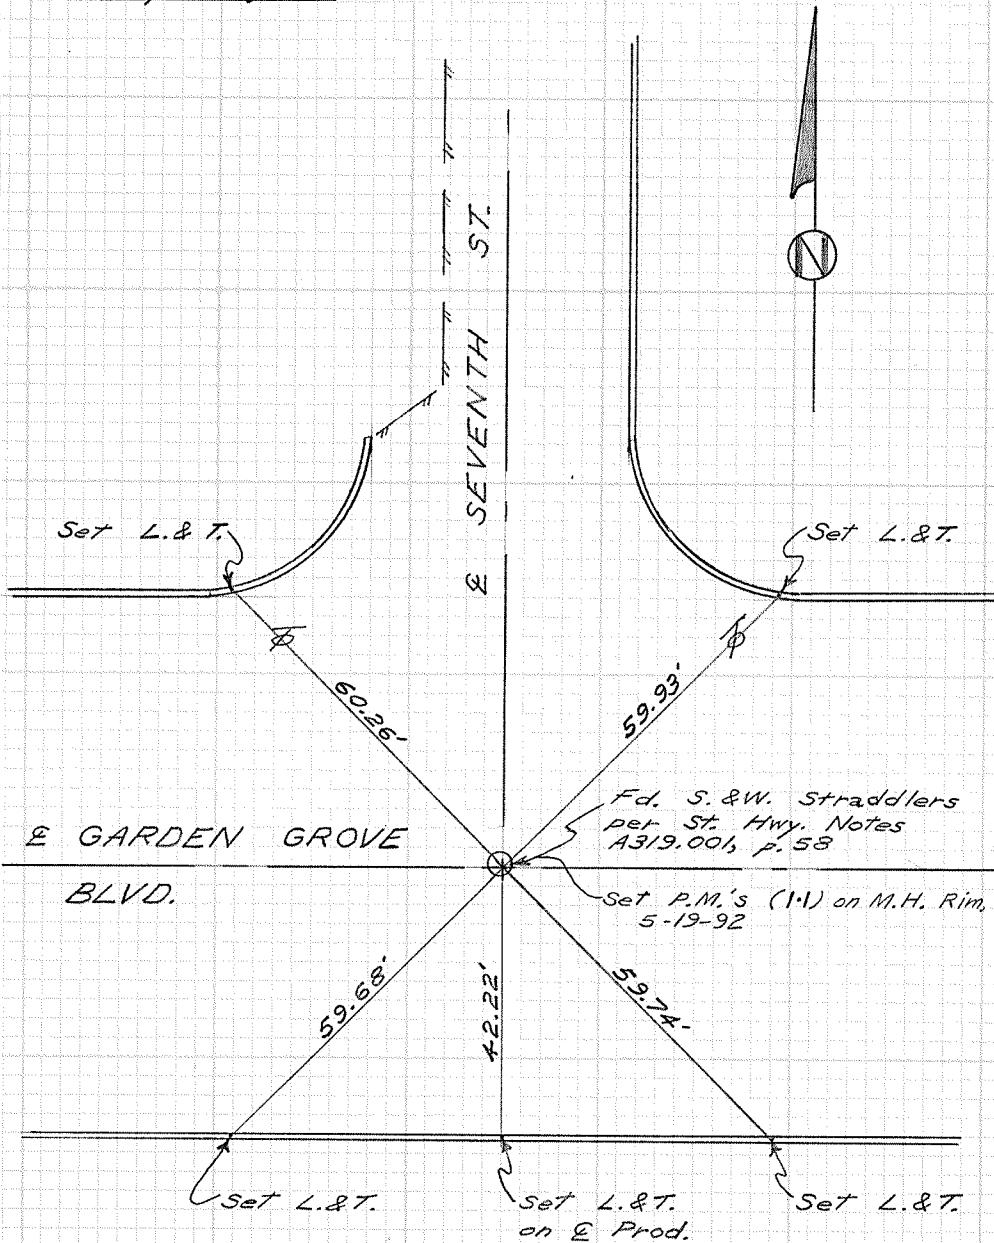

CITY OF GARDEN GROVE, CALIFORNIA

SURVEY OF Garden Grove Blvd. & Birchwood TB NO. 3 PAGE 37
 SURVEY BY Prickett & Party TRACT NO.
 DATE April 11, 1973

DO NOT EXTEND NOTES THIS SIDE OF LINE

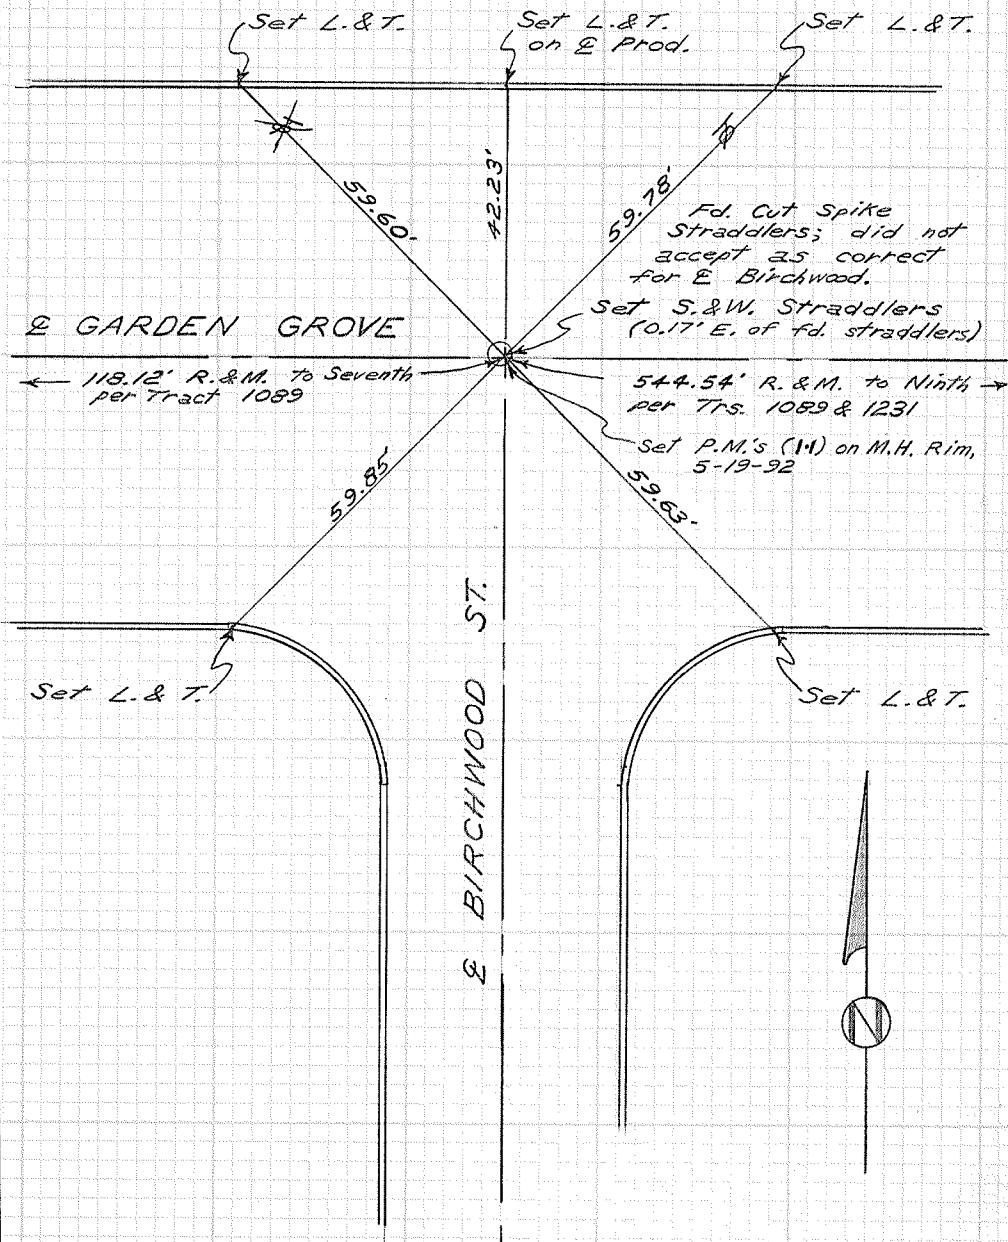


CITY OF GARDEN GROVE, CALIFORNIA

SURVEY OF Garden Grove Blvd & Eighth TB NO. 3 PAGE 38
 SURVEY BY Prickett & Party TRACT NO.
 DATE April 11, 1973

SURVEYORS SERVICE COMPANY. C-STA MESA - STOCK NO. 411


DO NOT EXTEND NOTES THIS SIDE OF LINE

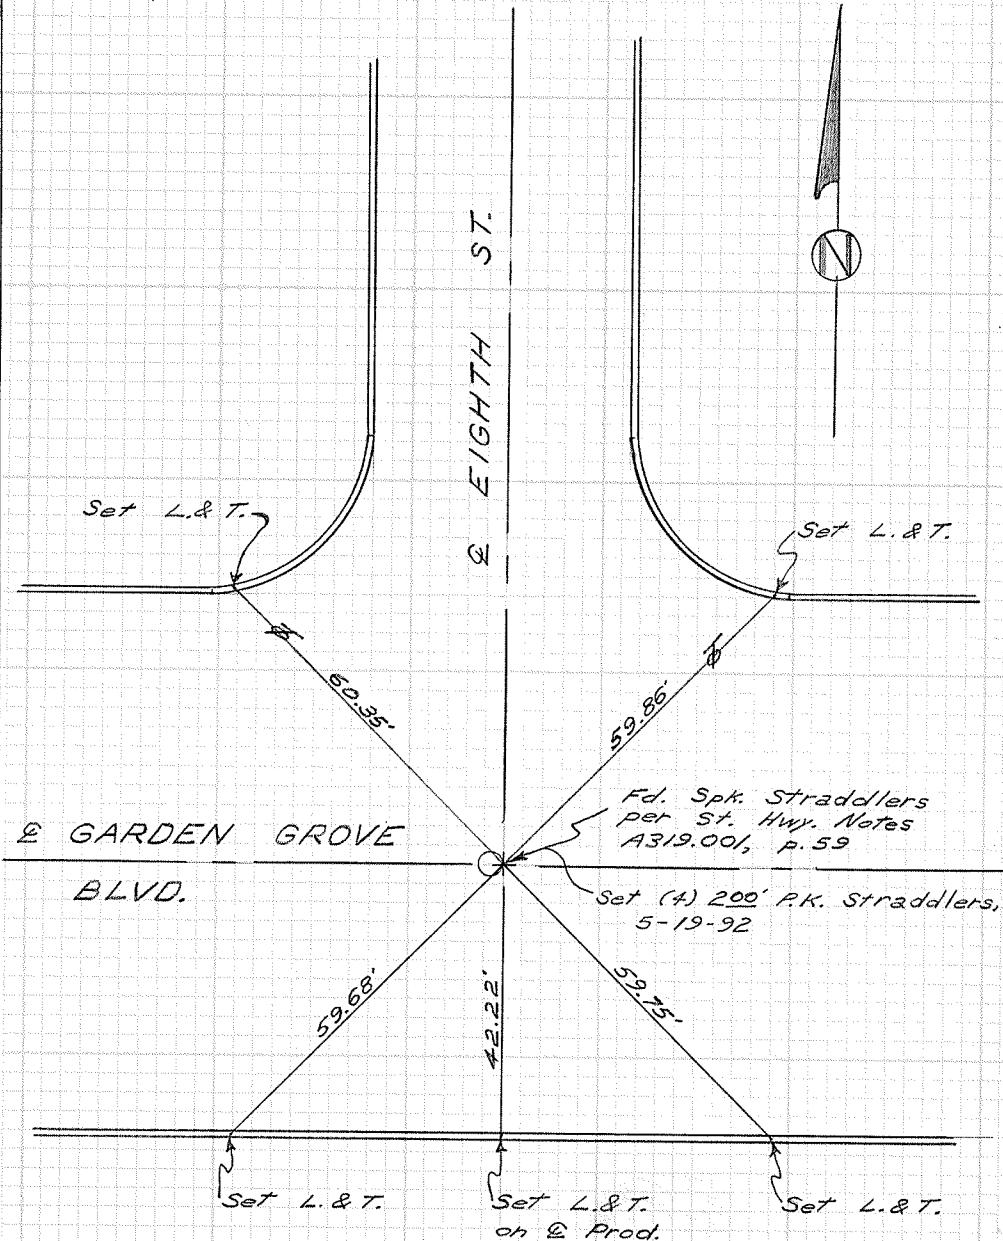

CITY OF GARDEN GROVE, CALIFORNIA

SURVEY OF Garden Grove Blvd. & Sandra TB NO. 3 PAGE 39
SURVEY BY Prickett & Party TRACT NO. _____
DATE April 11, 1973


DO NOT EXTEND NOTES THIS SIDE OF LINE

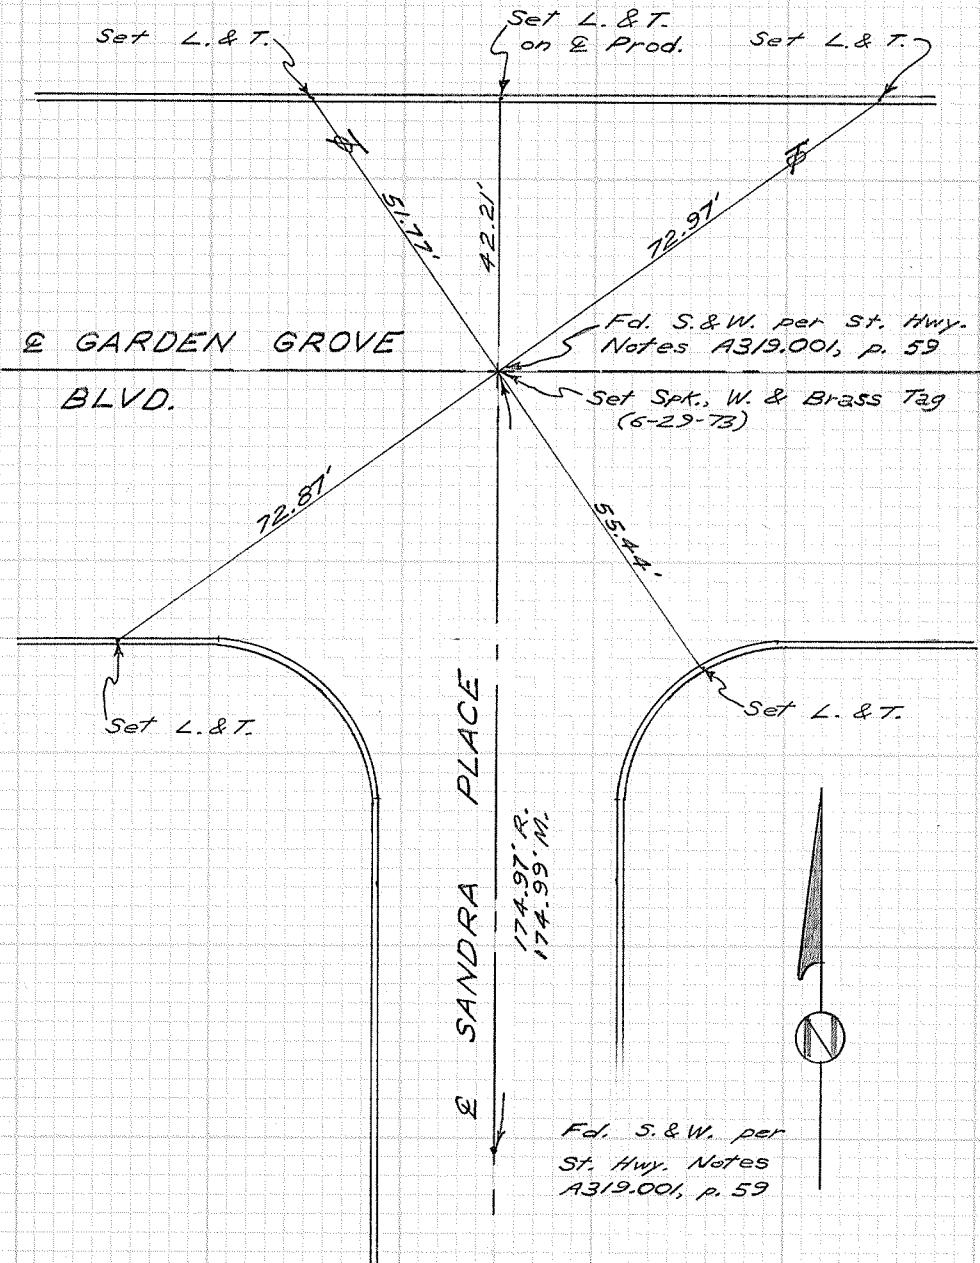

CITY OF GARDEN GROVE, CALIFORNIA

SURVEY OF Garden Grove Blvd. & Nina TB NO. 3 PAGE 40
SURVEY BY Prickett & Party TRACT NO.
DATE April 12, 1973


DO NOT EXTEND NOTES THIS SIDE OF LINE

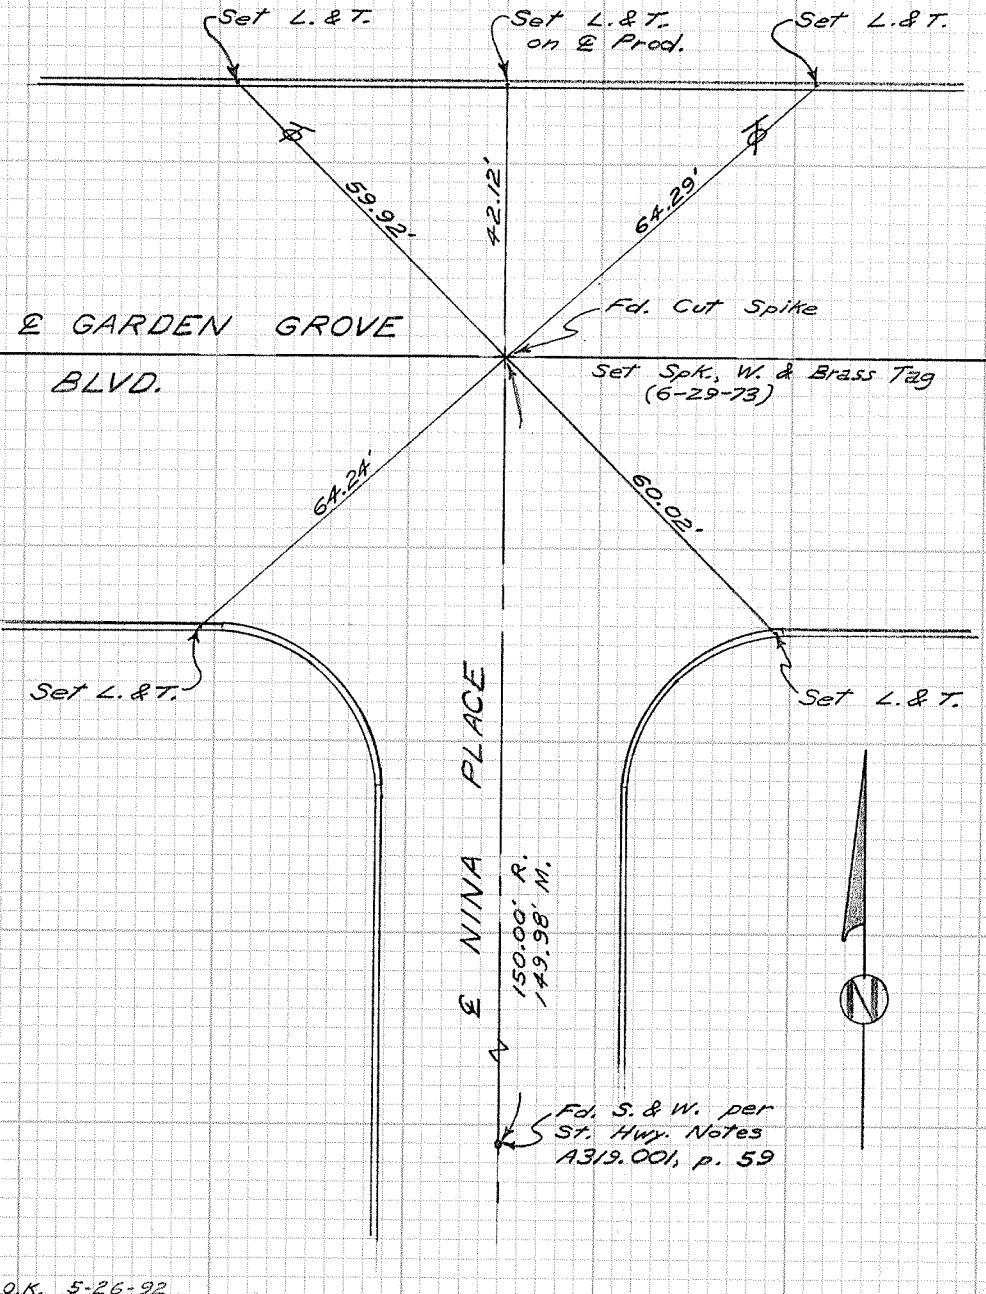

CITY OF GARDEN GROVE, CALIFORNIA

SURVEY OF Garden Grove Blvd. & Safford T B NO. 3 PAGE 41
 SURVEY BY Prickett & Party TRACT NO.
 DATE Nov. 28, 1972

DO NOT EXTEND NOTES THIS SIDE OF LINE

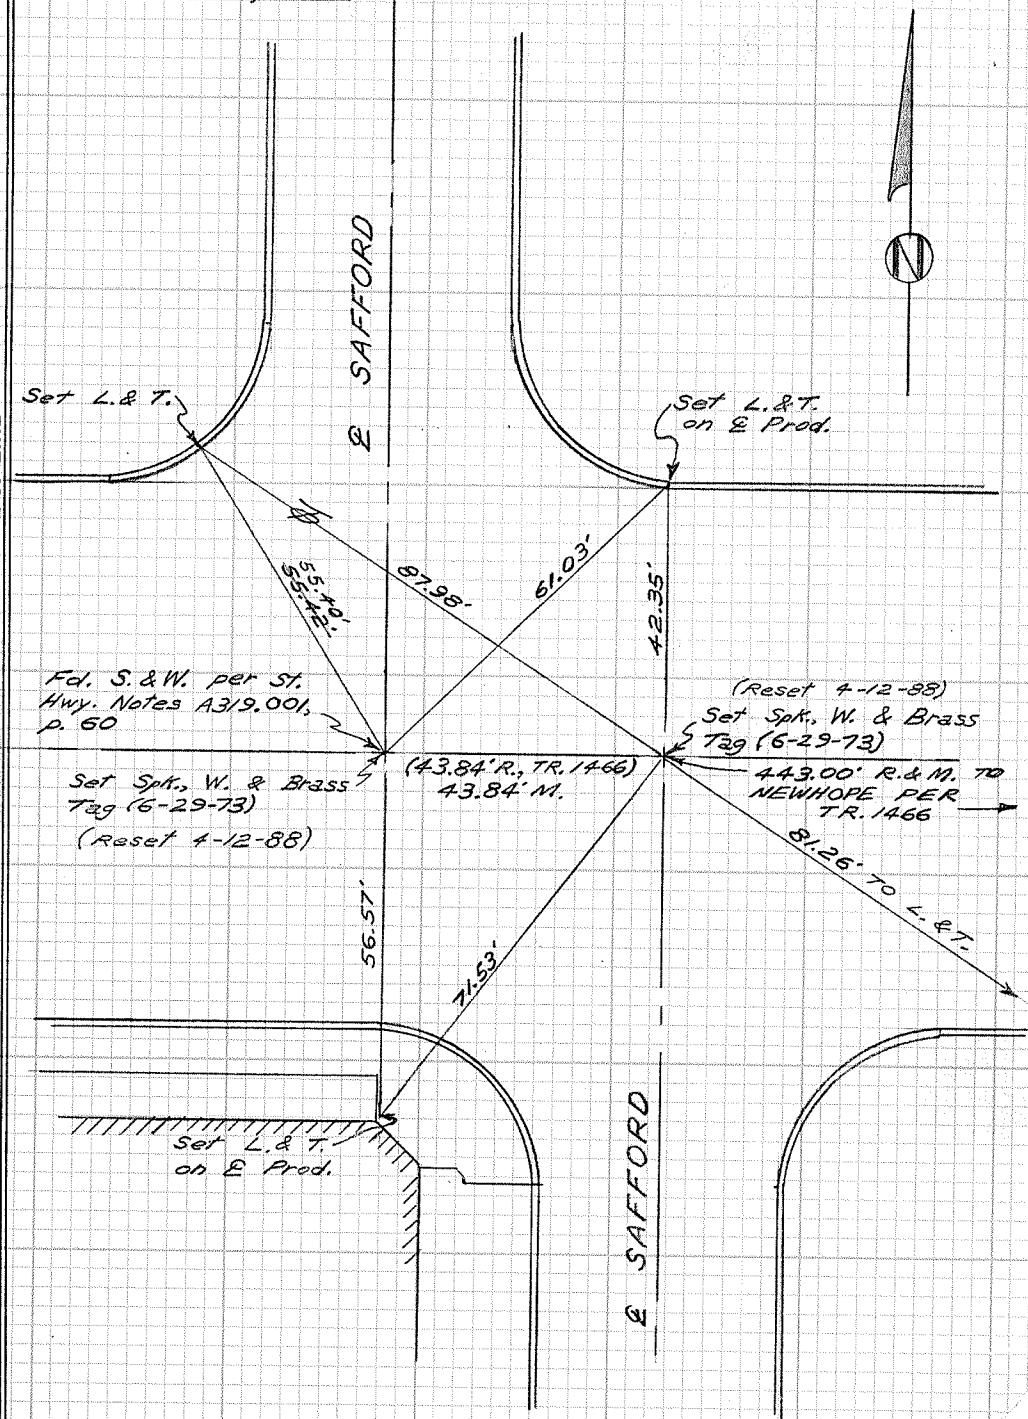


CITY OF GARDEN GROVE, CALIFORNIA

SURVEY OF Garden Grove Blvd. & Lemonwood T B NO. 3 PAGE 42
 SURVEY BY Prickett & Party TRACT NO.
 DATE April 12, 1973

SURVEYORS SERVICE COMPANY, COSTA MESA - STOCK NO. 411

A 31.001 P 60


DO NOT EXTEND NOTES THIS SIDE OF LINE

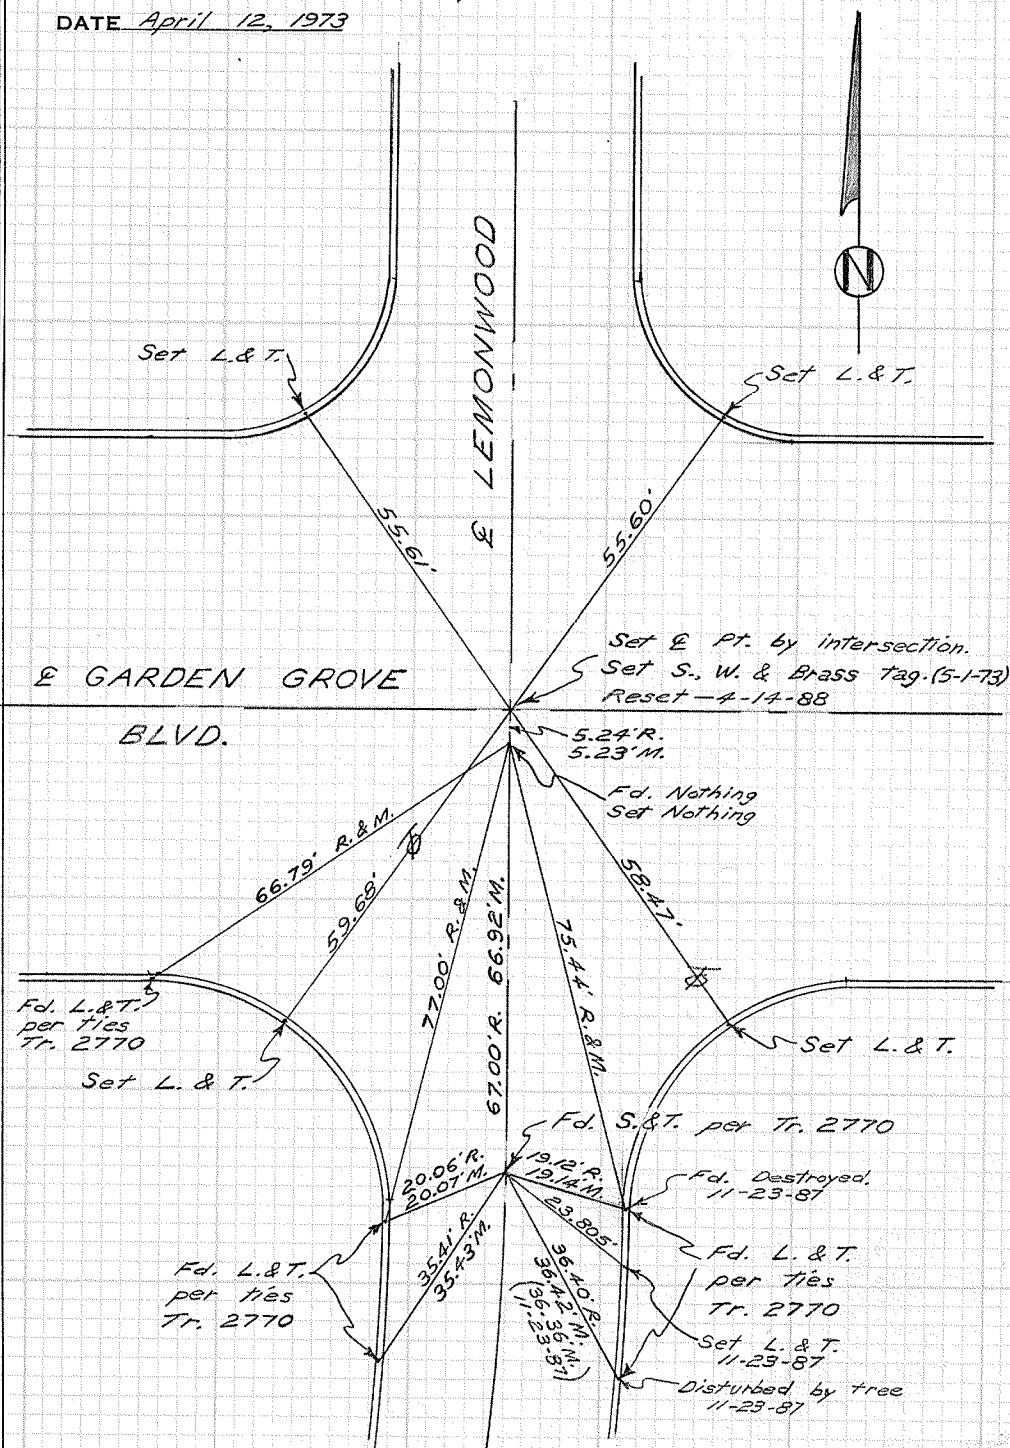

CITY OF GARDEN GROVE, CALIFORNIA

SURVEY OF Garden Grove Blvd & Rockinghorse TB NO. 3 PAGE 43
SURVEY BY Pritchett & Party TRACT NO.
DATE April 12, 1973

DO NOT EXTEND NOTES THIS SIDE OF LINE

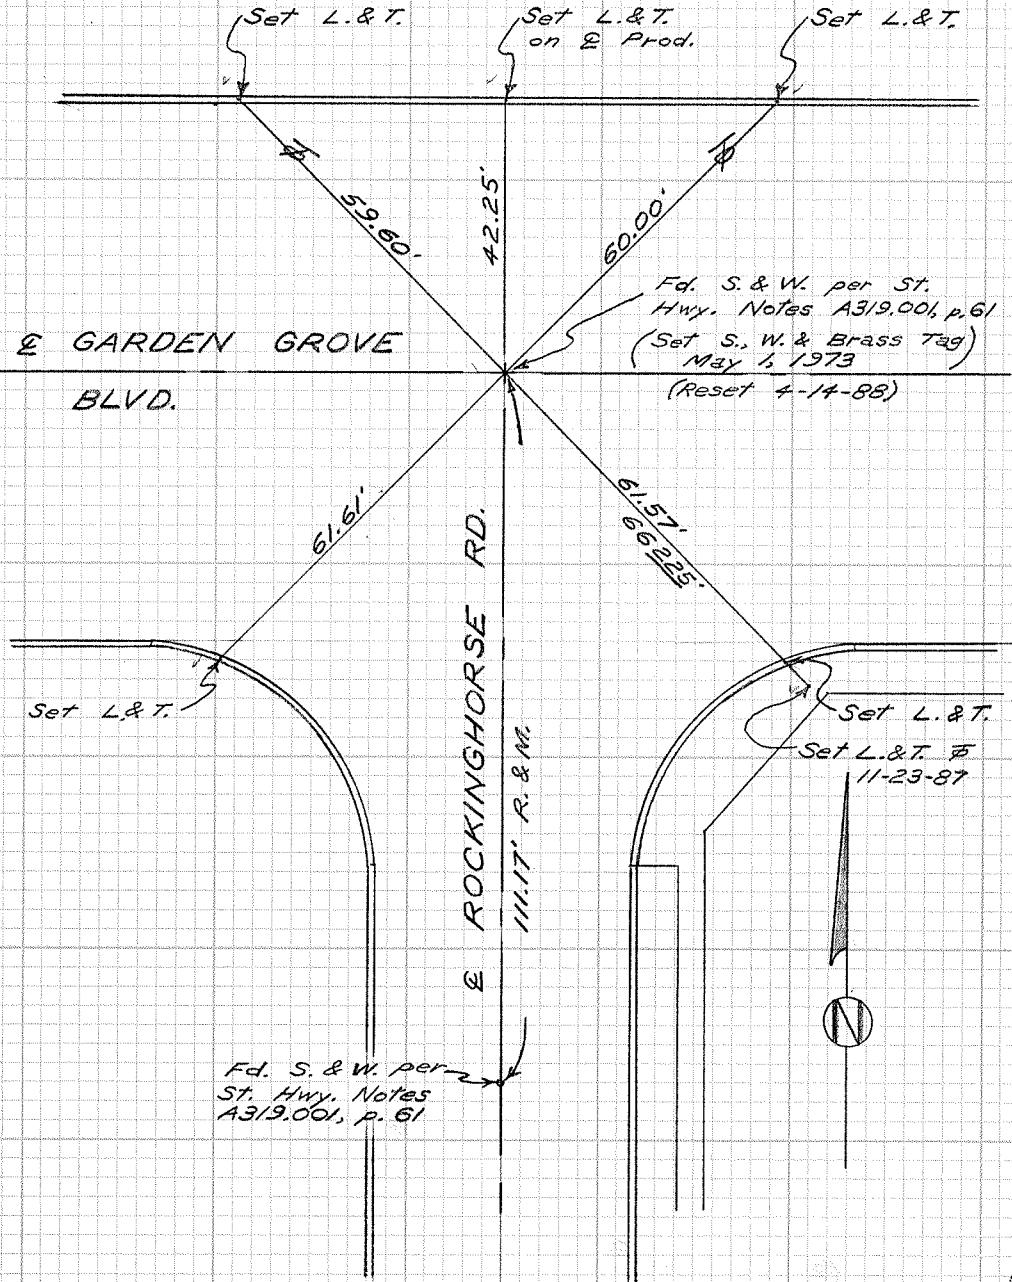


CITY OF GARDEN GROVE, CALIFORNIA

SURVEY OF Garden Grove Blvd. & Dungan TB NO. 3 PAGE 44

SURVEY BY Prickett & Party TRACT NO.

DATE April 17, 1973

DO NOT EXTEND NOTES THIS SIDE OF LINE

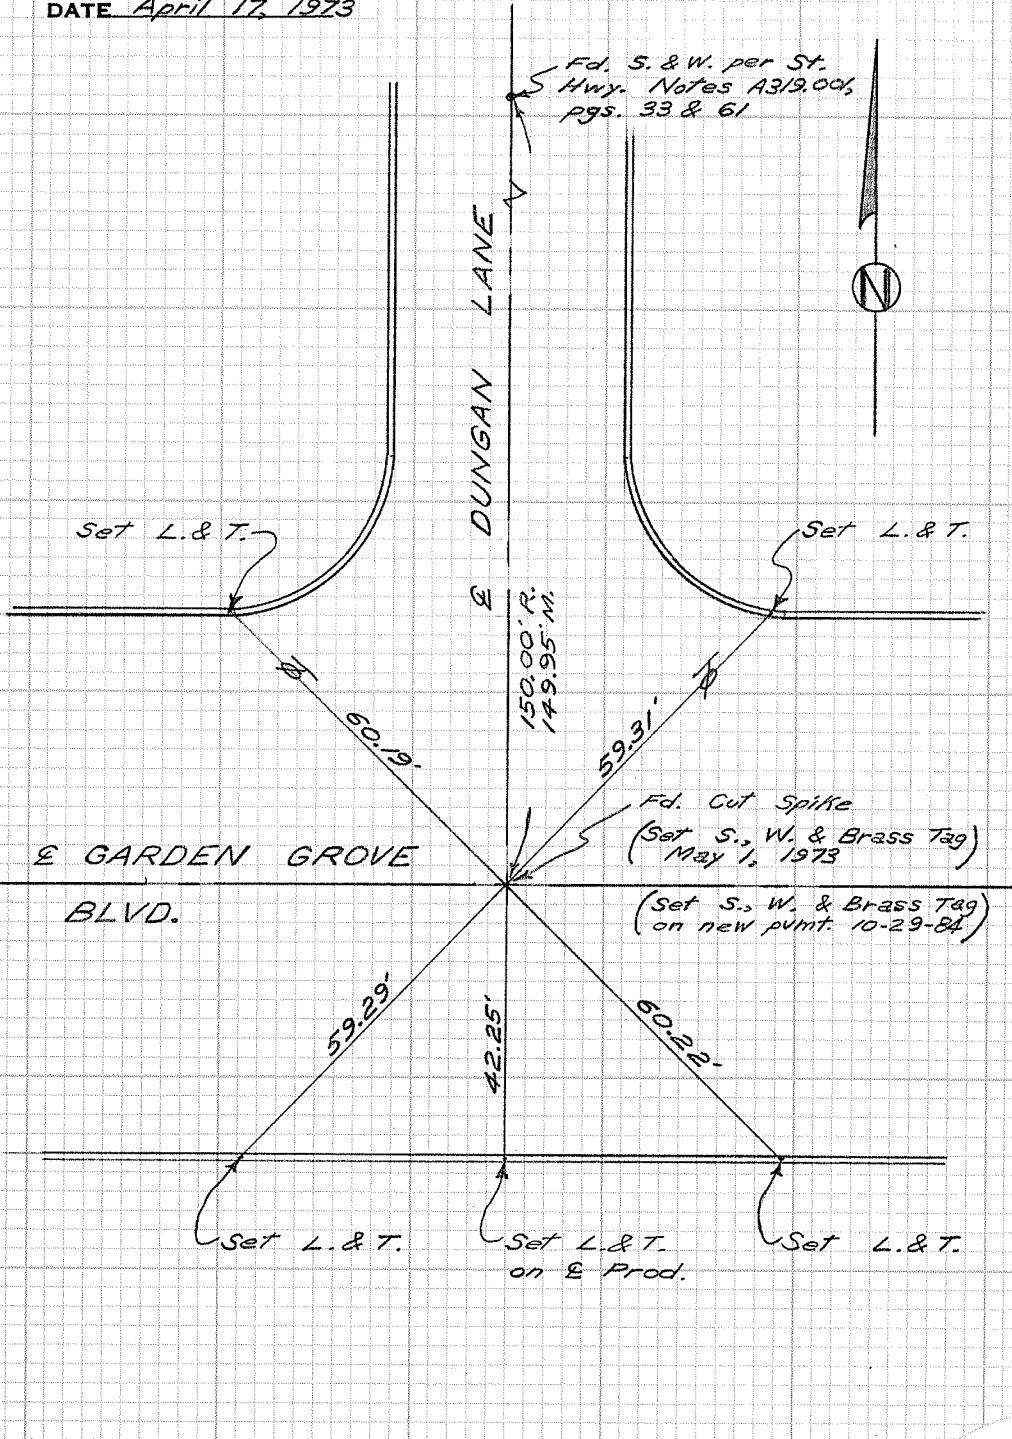

CITY OF GARDEN GROVE, CALIFORNIA

SURVEY OF Groveview + Lampson TB NO. 3 PAGE 45
 SURVEY BY Tuggle + Party TRACT NO.
 DATE 8-13-72

DO NOT EXTEND NOTES THIS SIDE OF LINE

1338
1670

Fd. L+T
Per Tr. 1670

£ GROVEVIEW (N)

set L+T
1^o N 10' B.C.R.

TRACT NO.

60.9'

1.62'

Fd. S+T
7.76 R. & P.

Set R. Hd.
Bolt w G.G. Brass
tag after Const.
5/14/73

£ GROVEVIEW (S)

49.73' R.
79.73' R.
2' M

Fd. L+T
Per Tr. 1670

£ LAMPSON

CITY OF GARDEN GROVE, CALIFORNIA

SURVEY OF Groveview St. & Lampson Ave. T.B. NO. 3 PAGE 45A
 SURVEY BY Prickett & Party TRACT NO.
 DATE Oct. 7, 1988

SURVEYORS SERVICE COMPANY. :TA MESA - STOCK NO. 411

DO NOT EXTEND NOTES THIS SIDE OF LINE

E LAMPSON AVE.

Set L. & T.

82' 605'

GROVEVIEW ST.

Fd. L. & T.
per G.G. T.B.
3, P. 45

E

Fd. Rd. Hd. Bolt &
Brass Tag per G.G.
T.B. 3, P. 45,
Set Lg. P.K. & Brass
T.B., 1-7-91

162' M.

Fd. Rd. Hd. Bolt &
Brass Tag per G.G.
T.B. 3, P. 45,
Set Lg. P.K. & Brass
T.B., 1-7-91

*821'
*973' R.
*970' M.

*833' R.
*833' M.

E GROVEVIEW ST.

Fd. L. & T. per
Tr. 1670 & G.G.
T.B. 3, P. 45

Fd. L. & T. per
Tr. 1670 & G.G.
T.B. 3, P. 45



CITY OF GARDEN GROVE, CALIFORNIA

SURVEY OF Lampson Ave & Blackthorn St T B NO. 3 PAGE 46
 SURVEY BY Tuggle & party TRACT NO.
 DATE 5/15/73

Scale 1" = 20'

DO NOT EXTEND NOTES THIS SIDE OF LINE

replaced with L&T. (3-20-79 W.R.P.)

Fd. G.G. ramset & washer (F.B.M.)

Set G.G. L&T

56.62

Set punched sh.k.
w. G.G. brass tag after
const. 5/15/73

@ Lampson Ave

338.62' to @ Groveview S.

42.35

Set "C" nail

190.00' to @ Shelly Dr

Set G.G. L&T

@ Blackthorn St.


Set G.G. L&T

CITY OF GARDEN GROVE, CALIFORNIA

SURVEY OF Lampson Ave. & Blackthorn St. TB NO 3 PAGE 46A

SURVEY BY Prickett & Party TRACT NO.

DATE Oct. 7, 1988

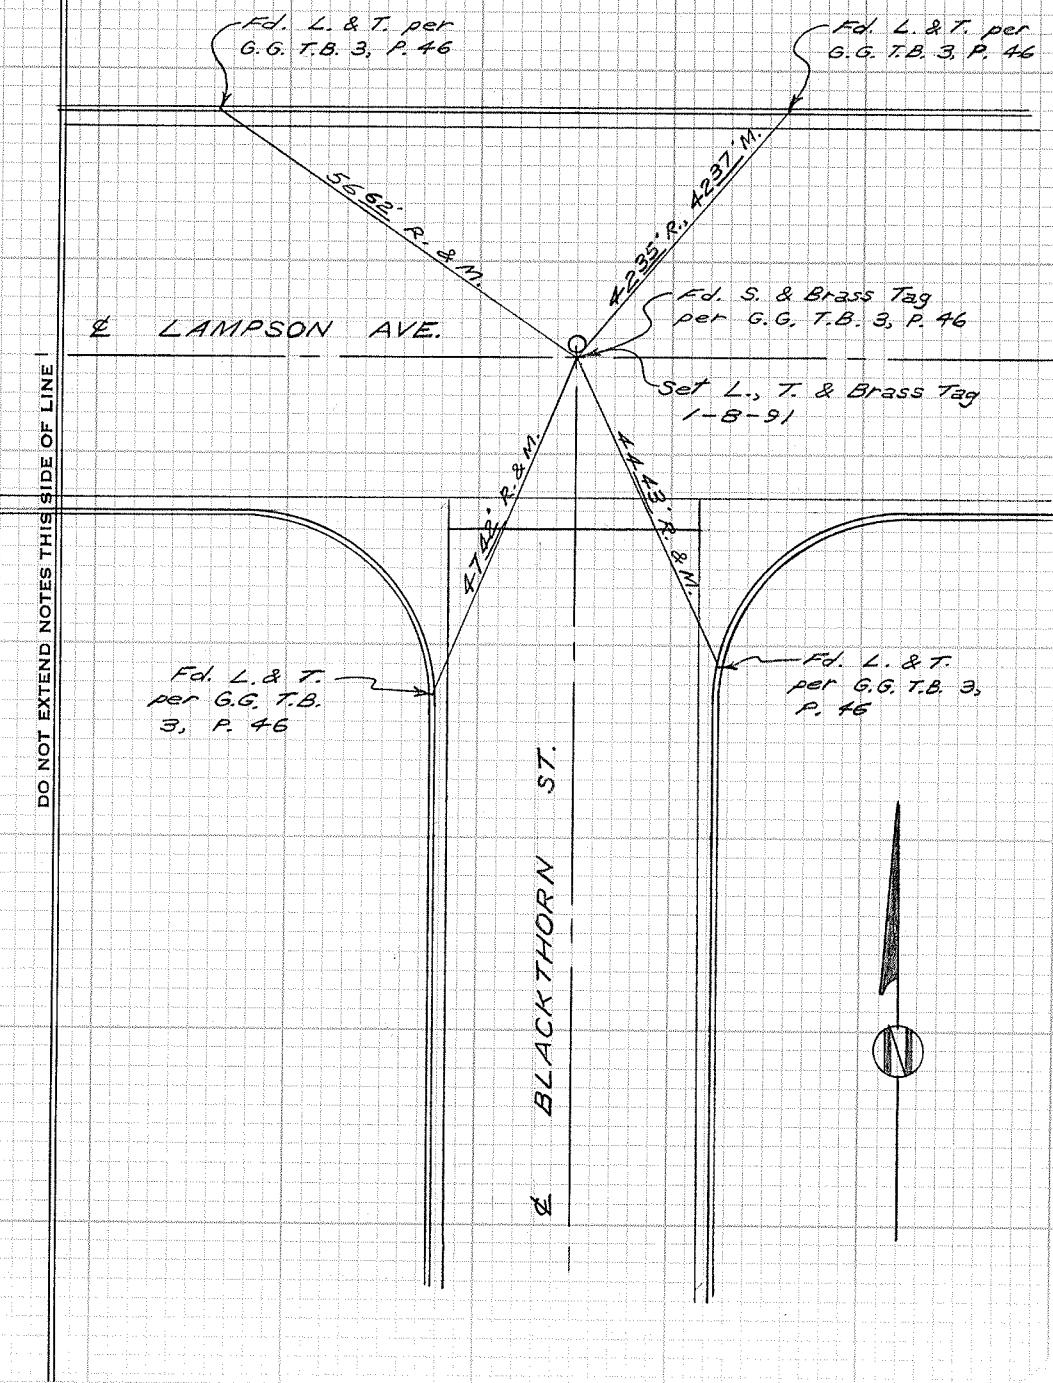

DO NOT EXTEND NOTES THIS SIDE OF LINE

F B NO. PAGE

166
172.62
338.62

160.00 172.62 160.00 30.00

338.63 M.

159.30 M

168.22

252-2

277.345-3

6251-2


2628

11/11/10 25

CITY OF GARDEN GROVE, CALIFORNIA

SURVEY OF SHELLY DR. & LAMPSON AVE T B NO. 3 PAGE 27
SURVEY BY Tuggie TRACT NO.
DATE 8-13-72

DO NOT EXTEND NOTES THIS SIDE OF LINE

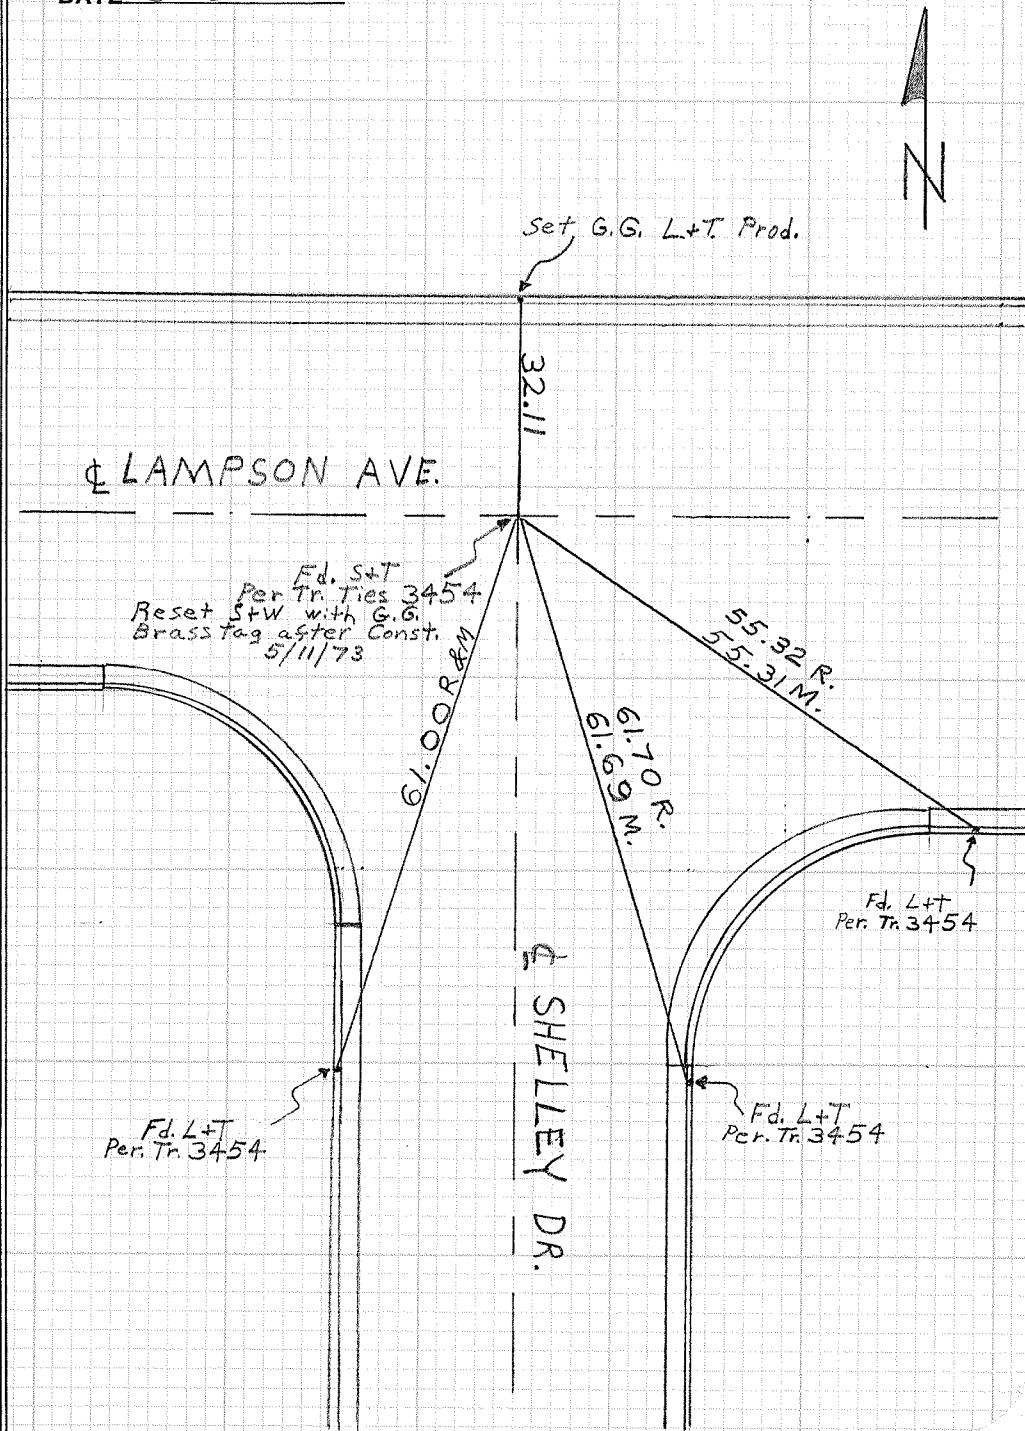

CITY OF GARDEN GROVE, CALIFORNIA

SURVEY OF Lampson Ave. & Shelley Dr T.B. NO. 3 PAGE 47A
SURVEY BY Prickett & Party TRACT NO. 3454
DATE Oct. 7 1988

JTA MESA - STOCK NO. 411

SURVEYORS SERVICE COMPANY.

DO NOT EXTEND NOTES THIS SIDE OF LINE

@ LAMPSON AVE.

Fd. L. & T.
per TA 3454
& G.G. T.B. 3, P. 47

@ SHELLEY DR

6'00" R. & M.
32'11" R. & M.

6'10" R.
8'0" M.

Fd. S., W. & BRASS Tag
per G.G. T.B. 3, P. 47
Set Lg. P.K. & Brass Tag
1-8-91

6'5" R.
3'2" M.
6'5" R.
3'0" M.

Fd. L. & T.
per TA 3454
& G.G. T.B. 3, P. 47




CITY OF GARDEN GROVE, CALIFORNIA

SURVEY OF Lampson Ave. & Morrie Lane TB NO. 3 PAGE 48
 SURVEY BY Tuggle & party TRACT NO.
 DATE 5/14/73

DO NOT EXTEND NOTES THIS SIDE OF LINE

SURVEYORS SERVICE COMPANY. R-STA MESA STOCK NO. 411

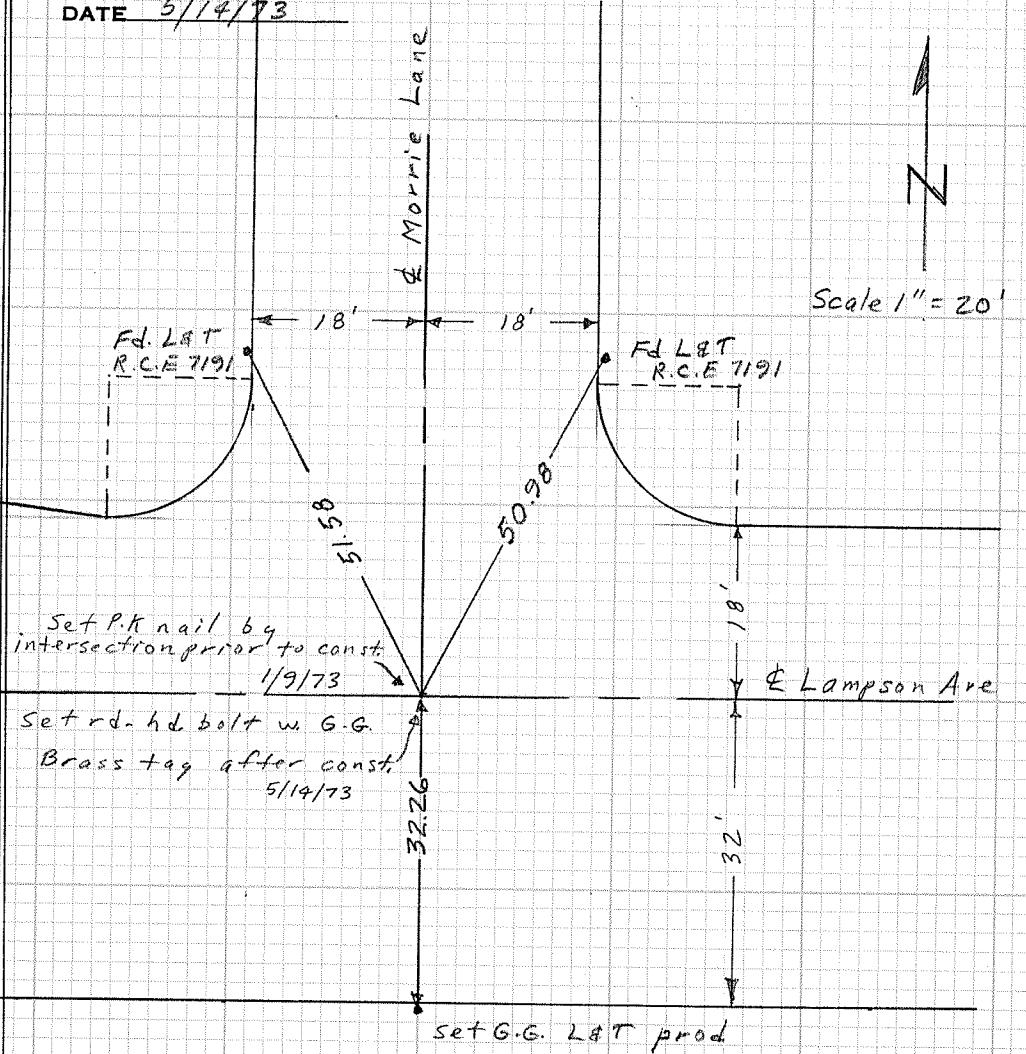


CITY OF GARDEN GROVE, CALIFORNIA

SURVEY OF Lampson Ave. & Morrie Lane T B NO. 3 PAGE 48A
 SURVEY BY Prickett & Party TRACT NO. 2074
 DATE Oct. 7, 1988

SURVEYORS SERVICE COMPANY, STA MESA - STOCK NO. 411


DO NOT EXTEND NOTES THIS SIDE OF LINE

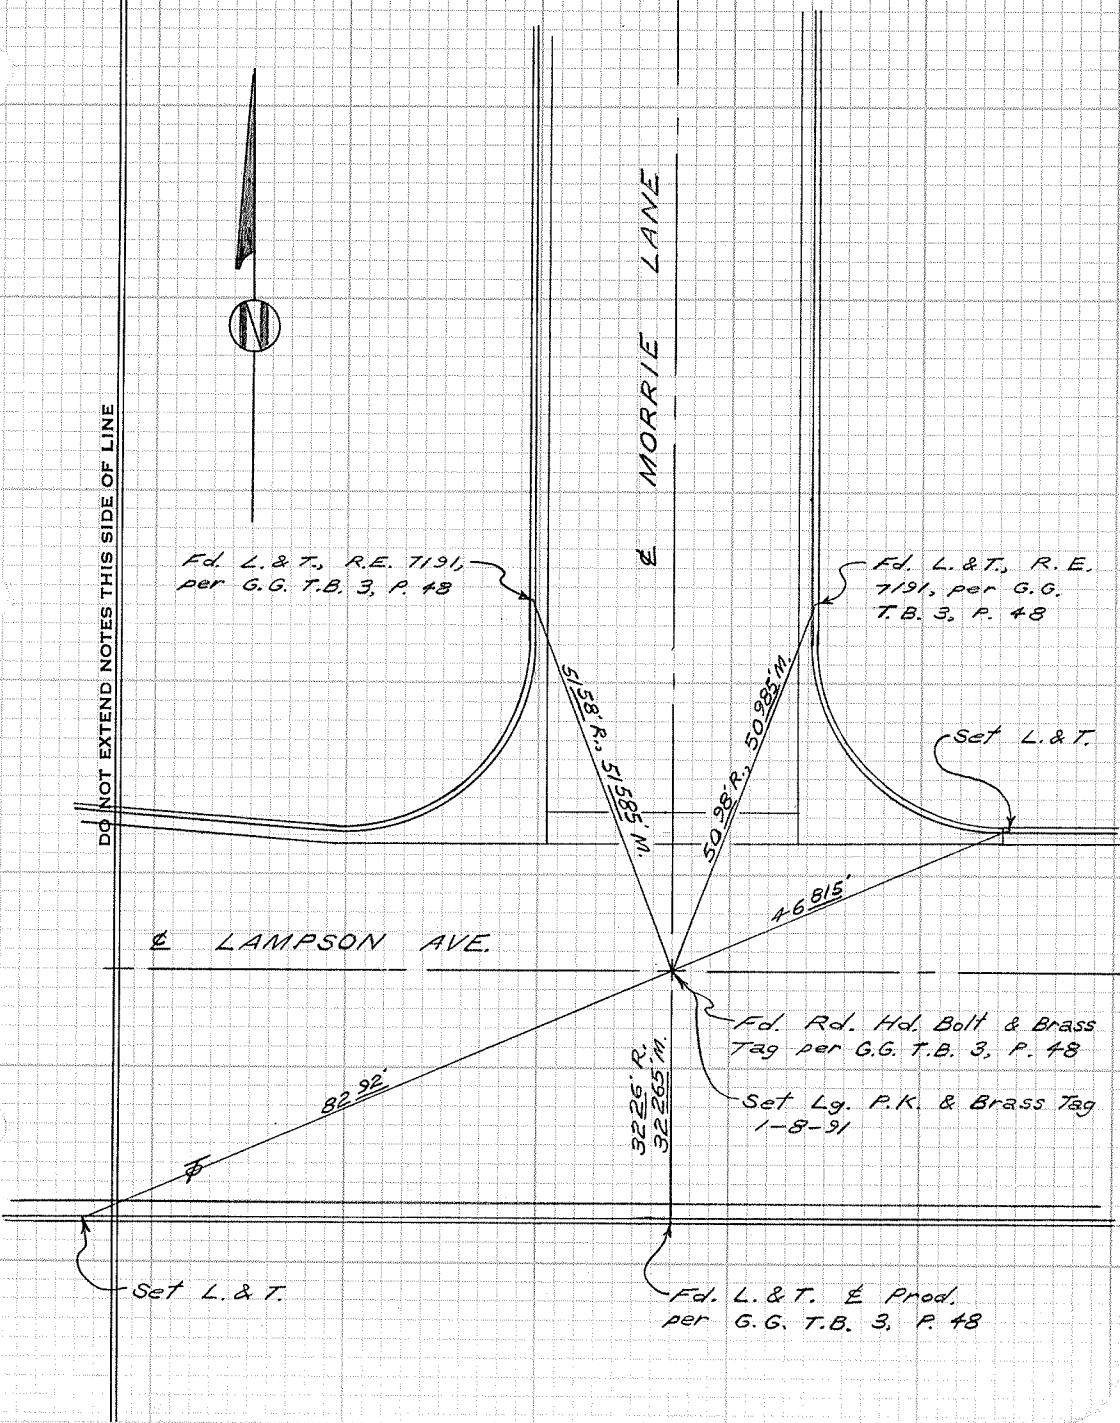

CITY OF GARDEN GROVE, CALIFORNIA

SURVEY OF Lampson + Kensington TB NO. 3 PAGE 49
 SURVEY BY Tuggey + Party TRACT NO.
 DATE August 13, 1972

DO NOT EXTEND NOTES THIS SIDE OF LINE

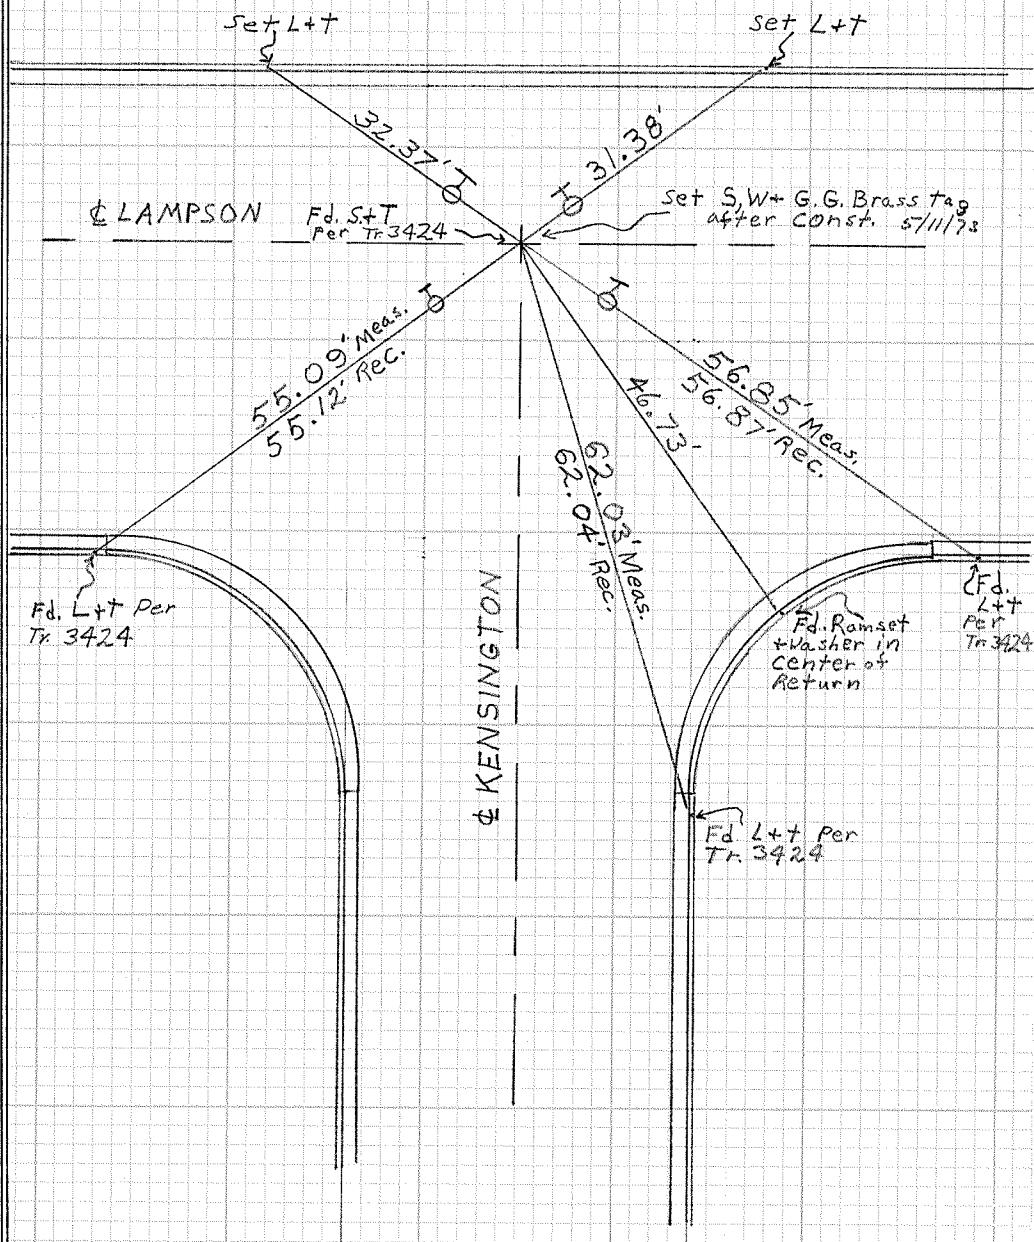


CITY OF GARDEN GROVE, CALIFORNIA

SURVEY OF Lampson Ave. & Kensington Ln. T B NO. 5 PAGE 49A
SURVEY BY Prickett & Party TRACT NO. 3424
DATE Oct. 7, 1988

SURVEYORS SERVICE COMPANY, TA MESA - STOCK NO. 411


DO NOT EXTEND NOTES THIS SIDE OF LINE

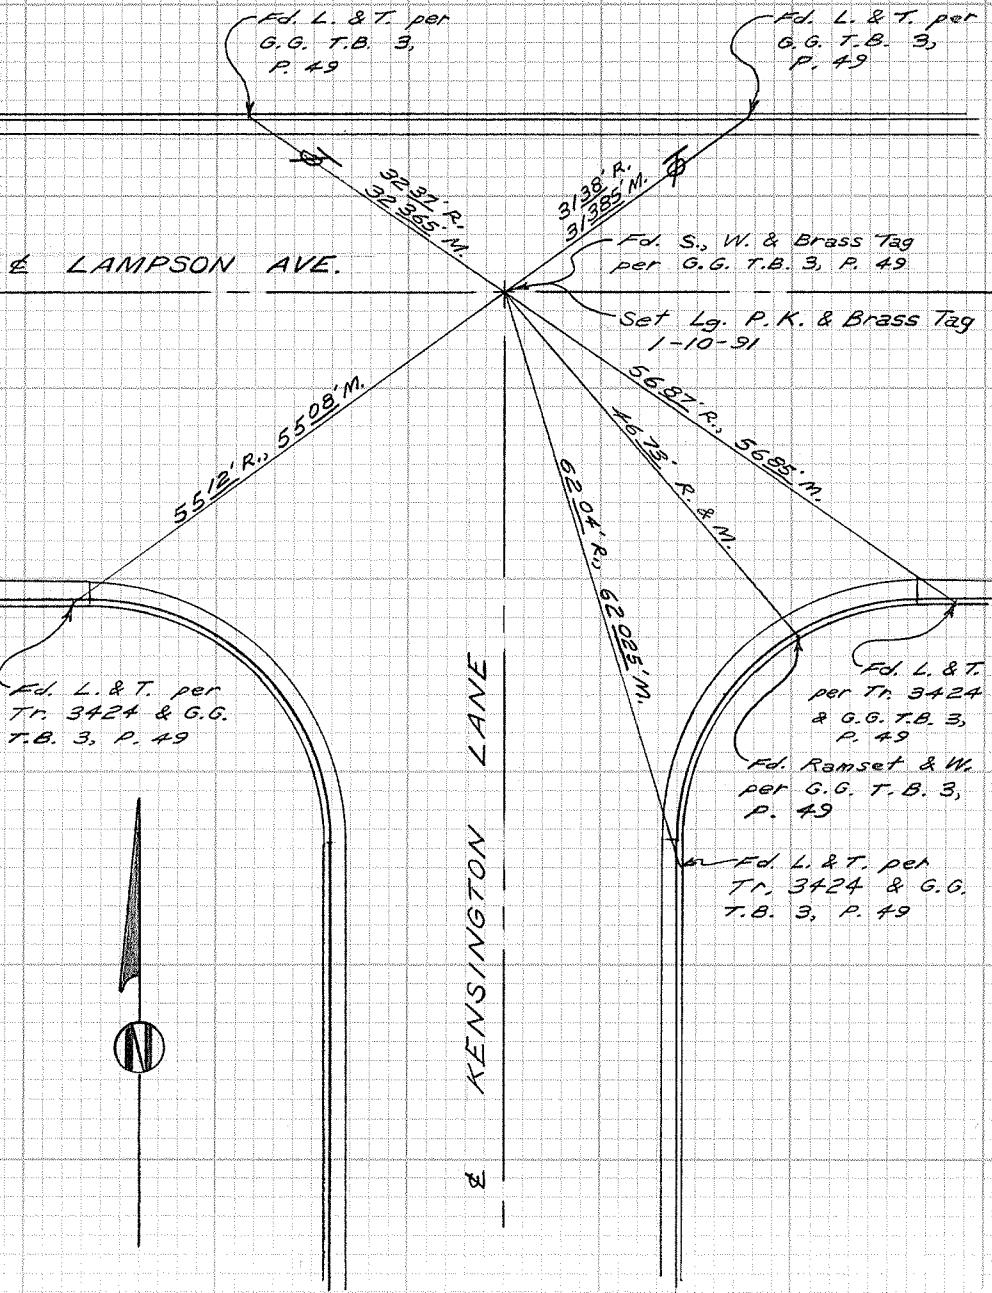

CITY OF GARDEN GROVE, CALIFORNIA

SURVEY OF Taft St & Paloma Ave. T B NO. 3 PAGE 50
SURVEY BY Tugge TRACT NO. 1172
DATE 4-20-73

DO NOT EXTEND NOTES THIS SIDE OF LINE

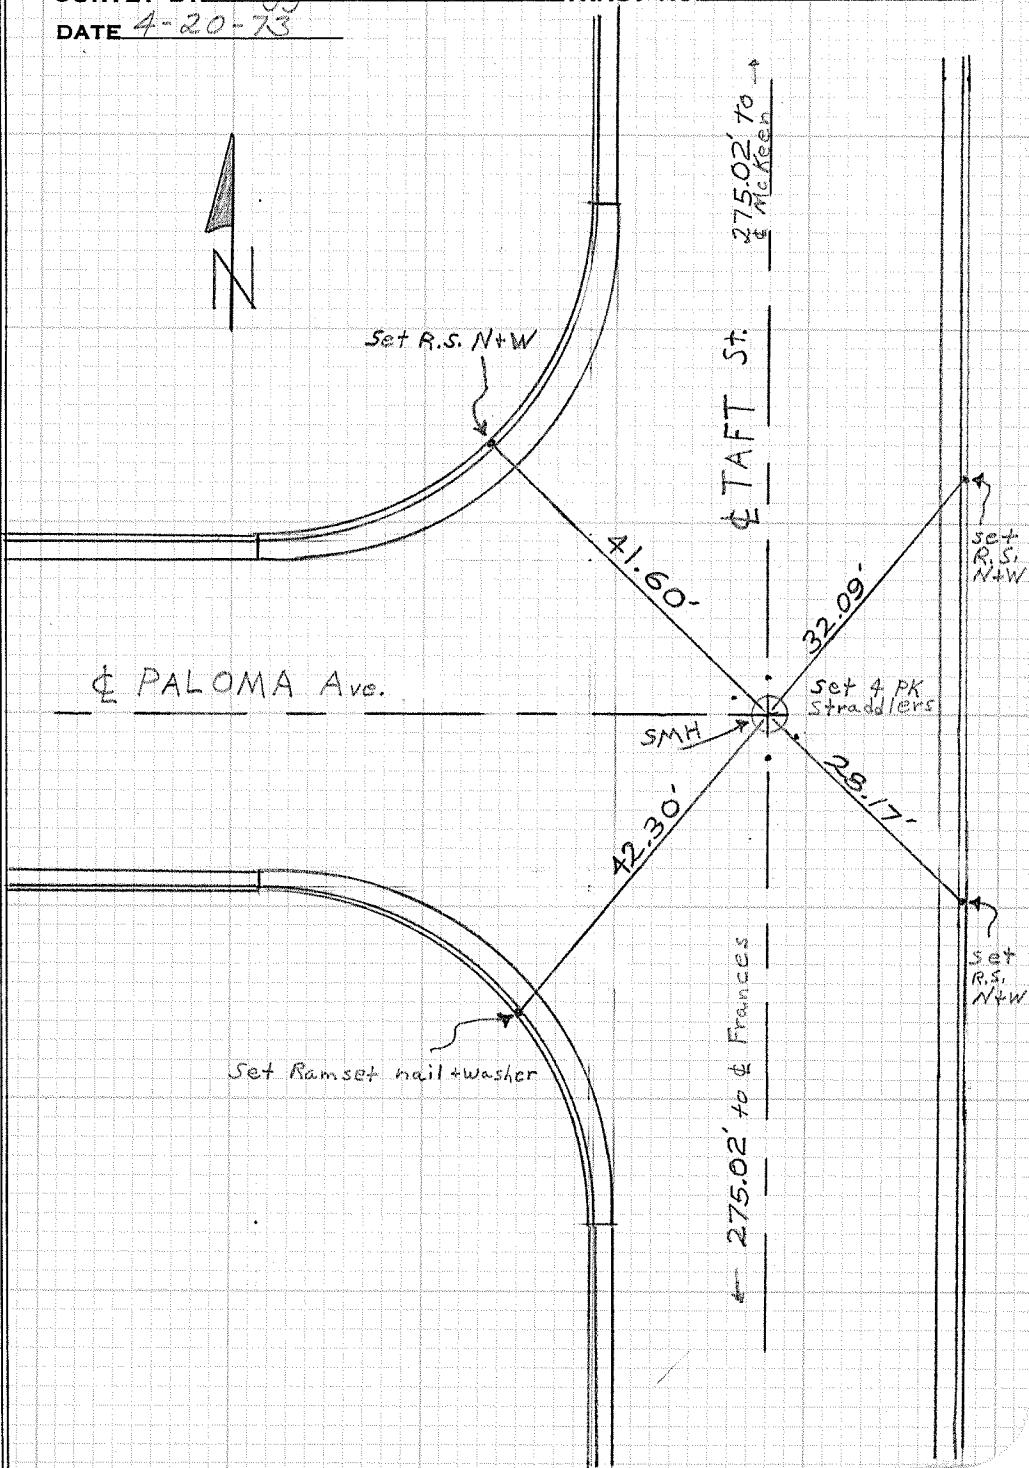

CITY OF GARDEN GROVE, CALIFORNIA

SURVEY OF Taft St. & Paloma Ave. T.B. NO. 3 PAGE 50A

SURVEY BY Prickett & Party TRACT NO. 1172

DATE Nov. 9, 1983

STA MESA - STOCK NO. 411

SURVEYORS SERVICE COMPANY

DO NOT EXTEND NOTES THIS SIDE OF LINE

E PALOMA AVE.

Fd. Ramset
N. & W. per
G.G. T.B. 3,
p. 50

Set four 200' S. & W. straddlers
that produce a point on line
002°W. of pt. 002° per tie.

Fd. Ramset
N. & W. per
G.G. T.B. 3,
p. 50

4230' R.
42285M.
42285M.
42285M.

E TAFT ST.

Fd. Ramset
N. & W. per
G.G. T.B. 3,
p. 50


Fd. Ramset
N. & W. per
G.G. T.B. 3,
p. 50



CITY OF GARDEN GROVE, CALIFORNIA

SURVEY OF CENTURY BLVD & DOROTHY TB NO. 3 PAGE 51
 SURVEY BY TUGG & PARTY TRACT NO.
 DATE 7/19/73

DO NOT EXTEND NOTES THIS SIDE OF LINE

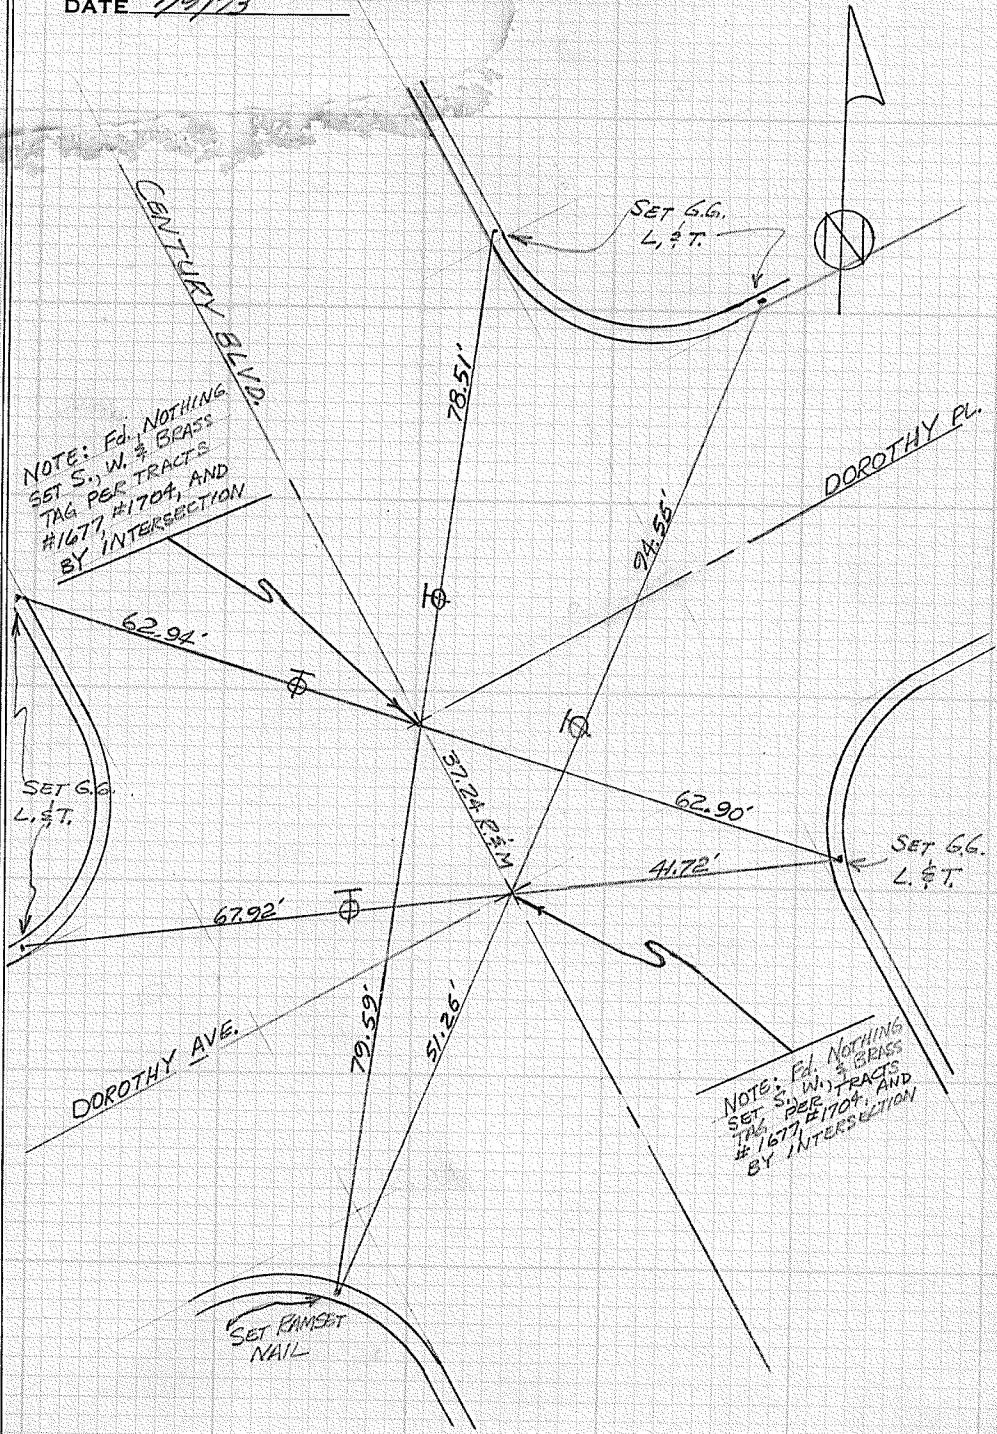


CITY OF GARDEN GROVE, CALIFORNIA

SURVEY OF Century Blvd. & Dorothy Ave. T B NO. 3 PAGE 51A
SURVEY BY Prickett & Party TRACT NO. // /
DATE May 4, 1993

TAMESA - STOCK NO. 411

SURVEYORS SERVICE COMPANY.

DO NOT EXTEND NOTES THIS SIDE OF LINE

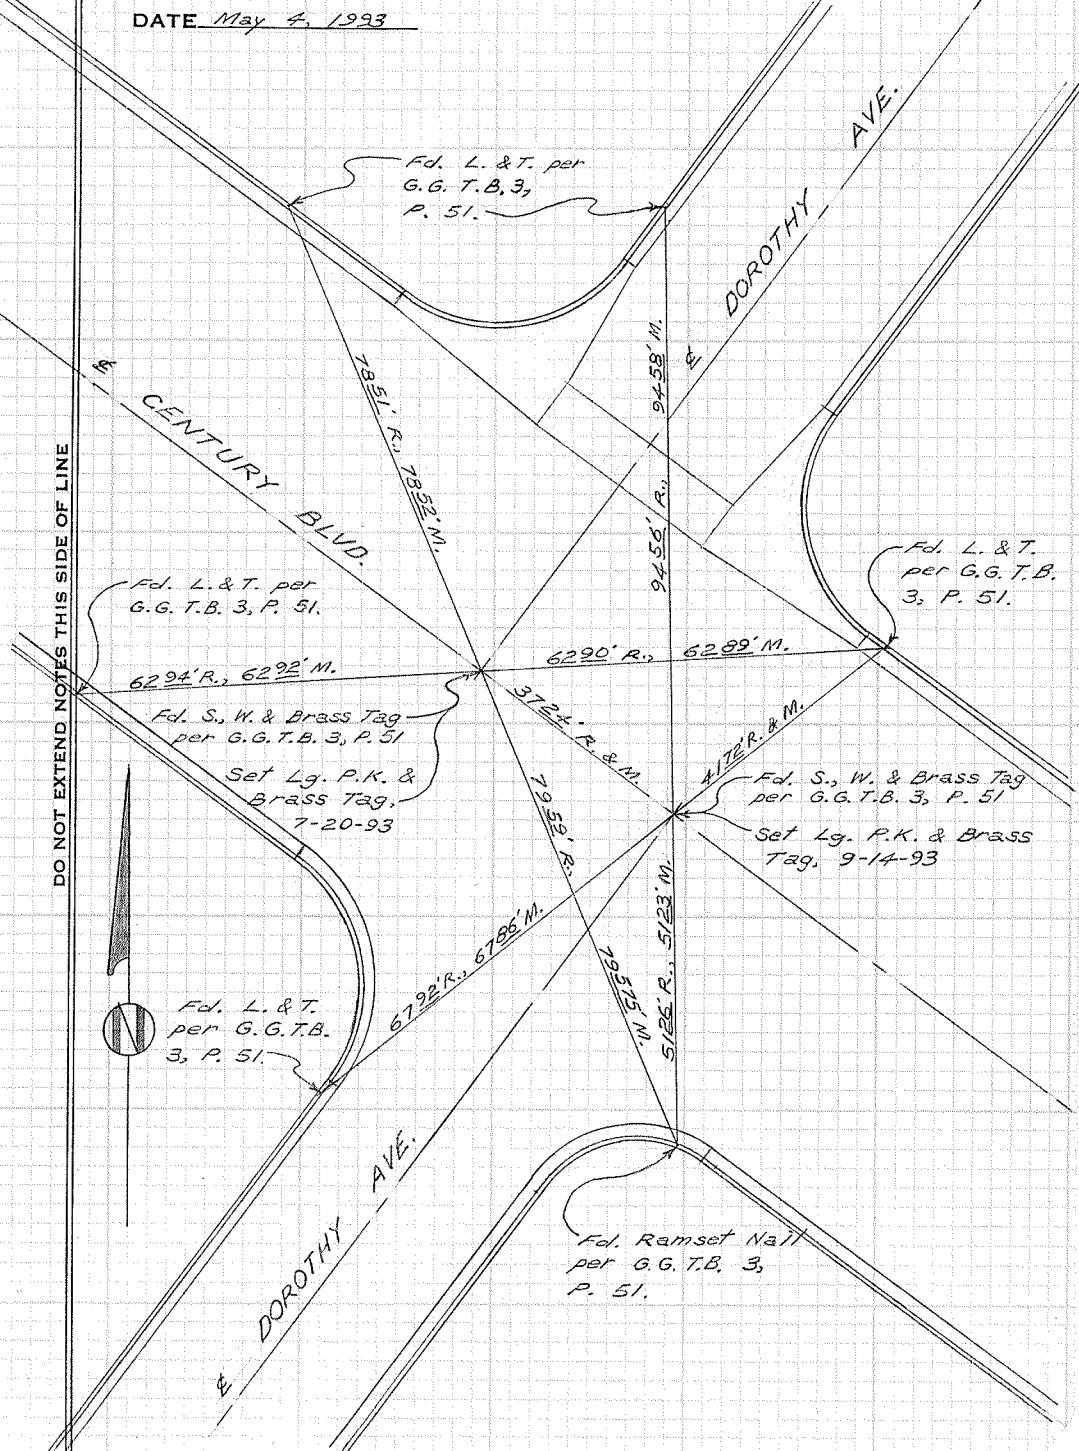


CITY OF GARDEN GROVE, CALIFORNIA

SURVEY OF Century & Main (Euclid) TB NO. 3 PAGE 52

SURVEY BY Prickett & Party TRACT NO.

DATE May 20, 1974

DO NOT EXTEND NOTES THIS SIDE OF LINE

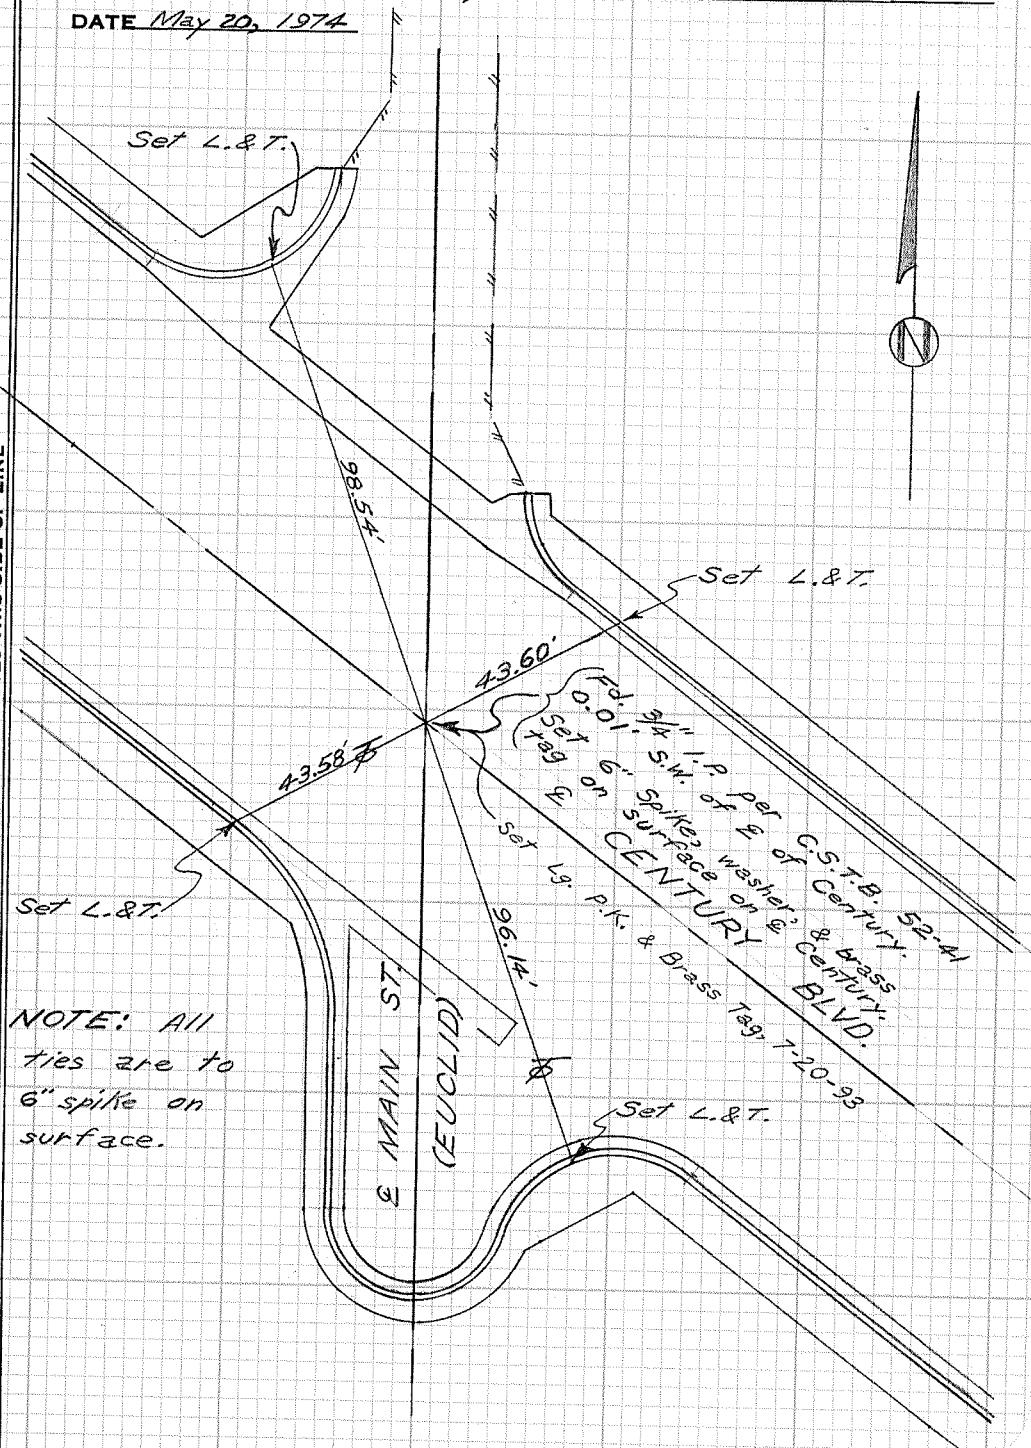

CITY OF GARDEN GROVE, CALIFORNIA

SURVEY OF Century Blvd. & Main St. T B NO. 3 PAGE 52A

SURVEY BY Brickett & Party TRACT NO.

DATE Sept. 12, 1994

OSTA MESA - STOCK NO. 411

SURVEYORS SERVICE COMPANY

DO NOT EXTEND NOTES THIS SIDE OF LINE

Fd. L. & T.
per G.G. T.B. 3, P. 52

43'58" R. & M.

Set L. & T.
136' 6"

Fd. L. & T. per
G.G. T.B. 3, P. 52

136' 6" R.
W.L.E. 13' 9"

CENTURY

BLVD.

MAIN ST. - Vacated

Set L. & T.
136' 6" R.
Fd. Lg. P.K. & Bress T. 29
per G.G. T.B. 3, P. 52

CITY OF GARDEN GROVE, CALIFORNIA

SURVEY OF Century & McKeen


T B NO. 3 PAGE 53

SURVEY BY Prickett & Party

TRACT NO.

DATE May 16, 1978

DO NOT EXTEND NOTES THIS SIDE OF LINE

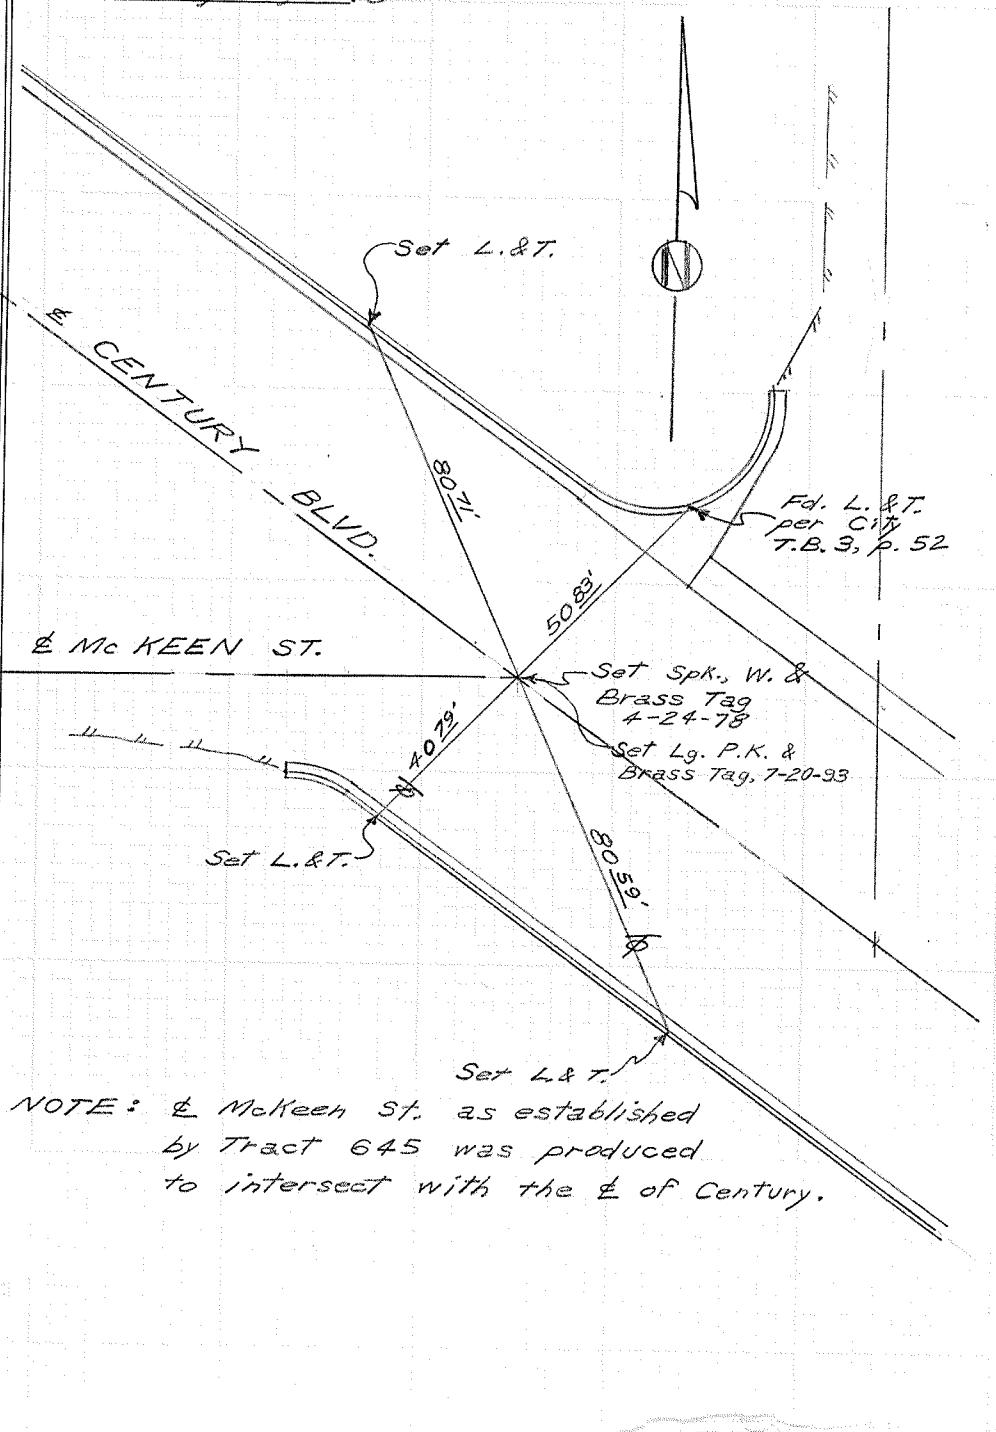


CITY OF GARDEN GROVE, CALIFORNIA

SURVEY OF Century Blvd. & McKeen St. T B NO. 3 PAGE 53A
SURVEY BY Prickett & Party TRACT NO.
DATE Sept. 12, 1994

SURVEYORS SERVICE COMPANY OSTA MESA - STOCK NO. 411


DO NOT EXTEND NOTES THIS SIDE OF LINE

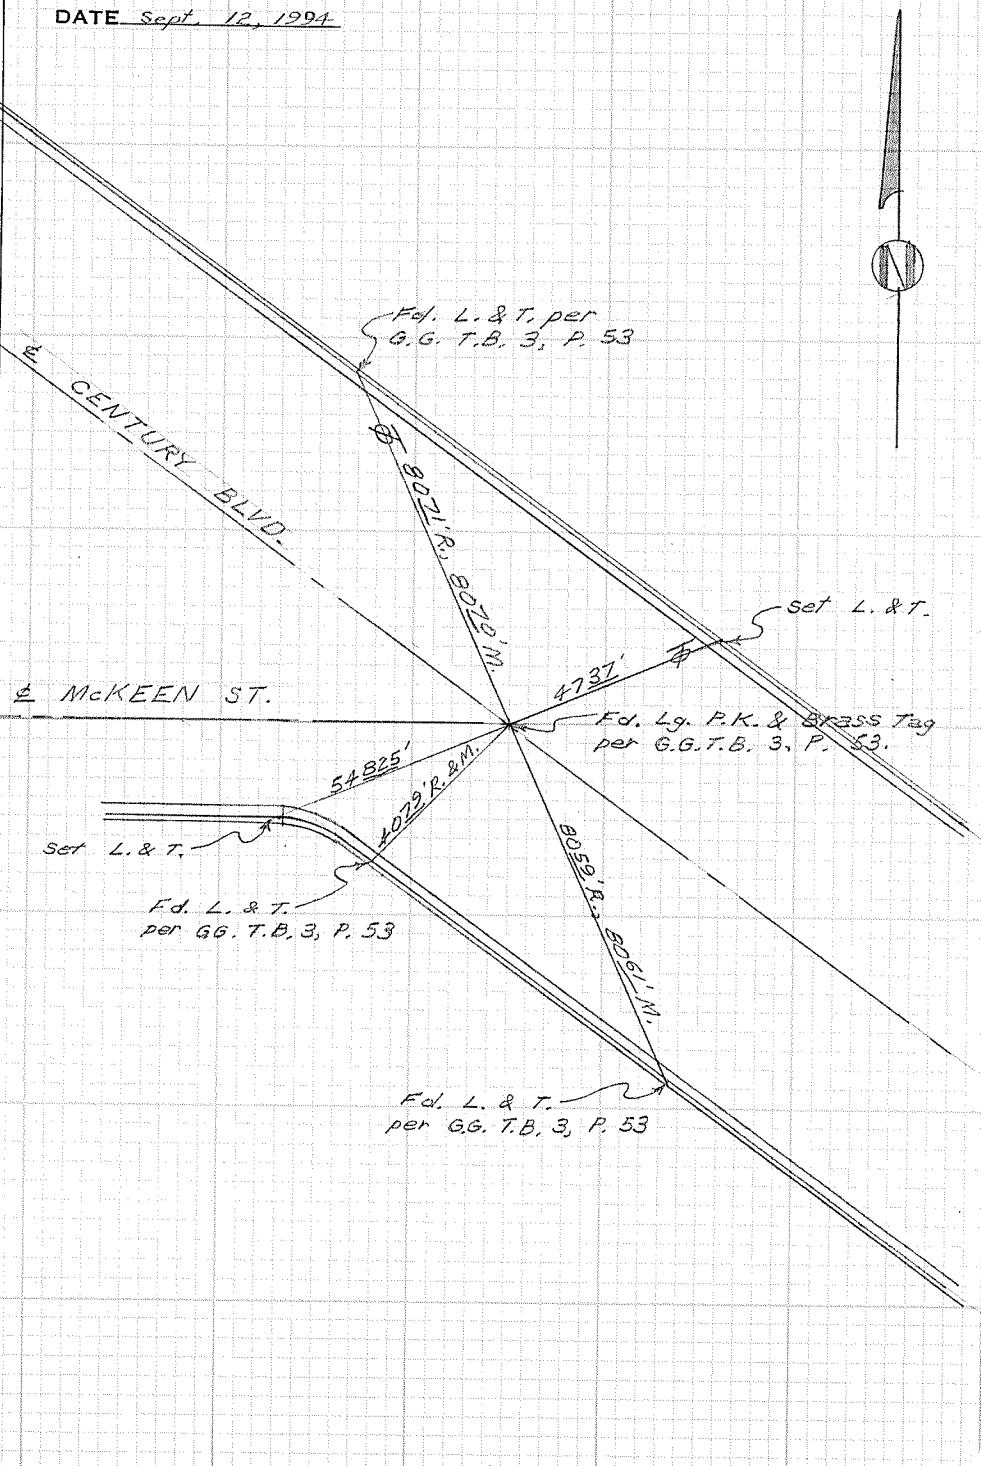

CITY OF GARDEN GROVE, CALIFORNIA

SURVEY OF Taft & Century TB NO 3 PAGE 54
SURVEY BY Prickett & Party TRACT NO.
DATE May 20, 1974


DO NOT EXTEND NOTES THIS SIDE OF LINE

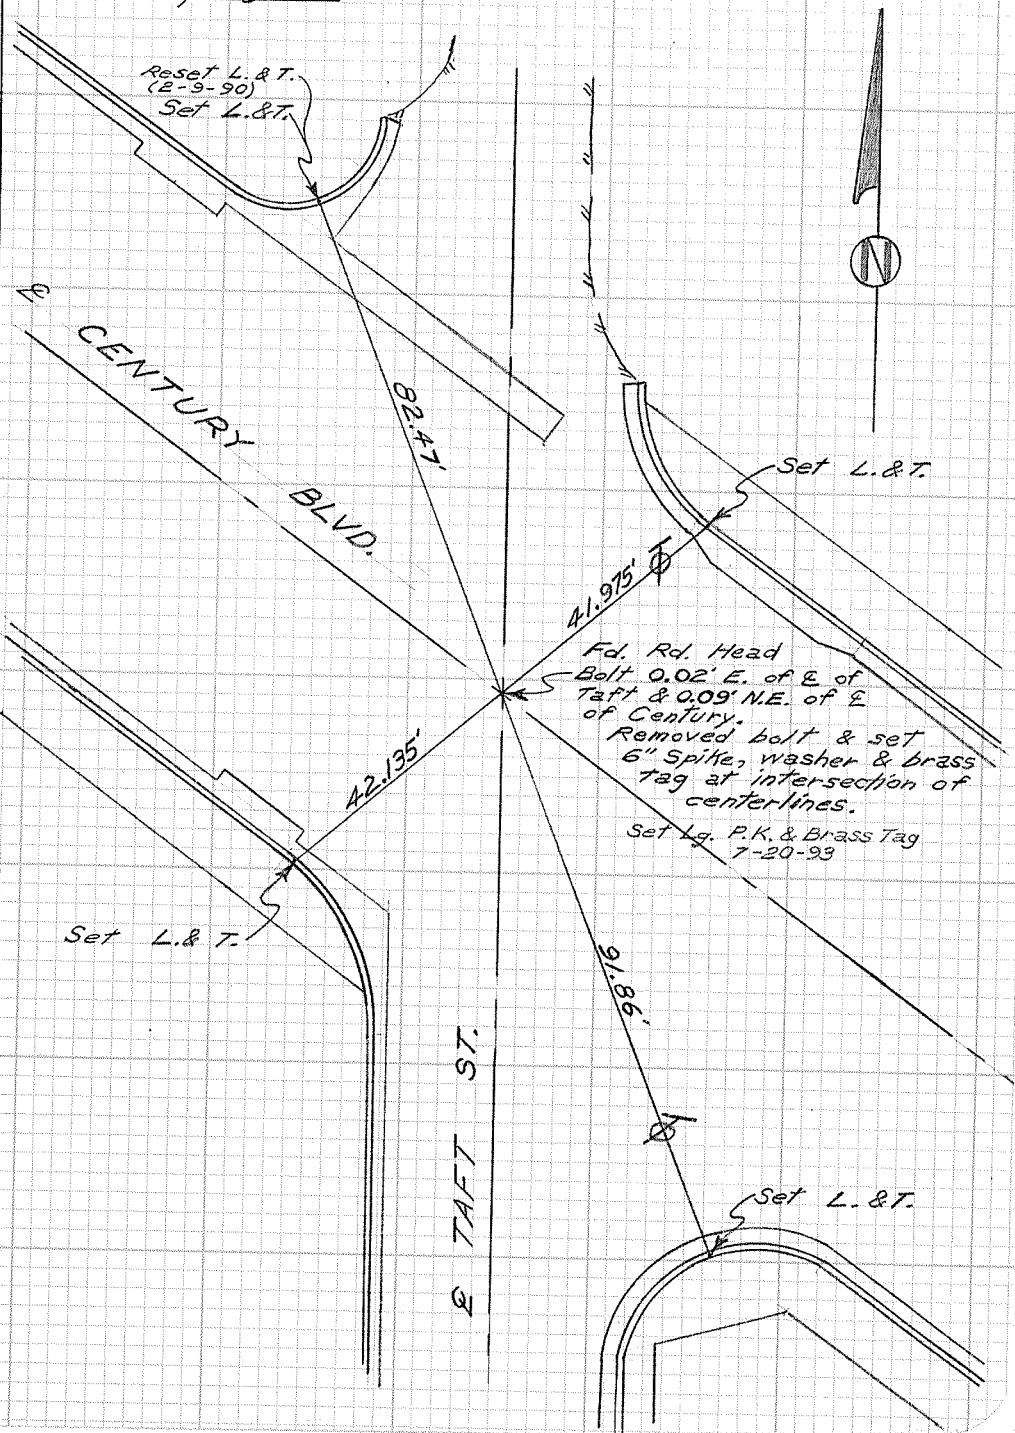

CITY OF GARDEN GROVE, CALIFORNIA

SURVEY OF Century & Walnut TB NO. 3 PAGE 55
SURVEY BY Prickett & Party TRACT NO.
DATE May 21, 1974

DO NOT EXTEND NOTES THIS SIDE OF LINE

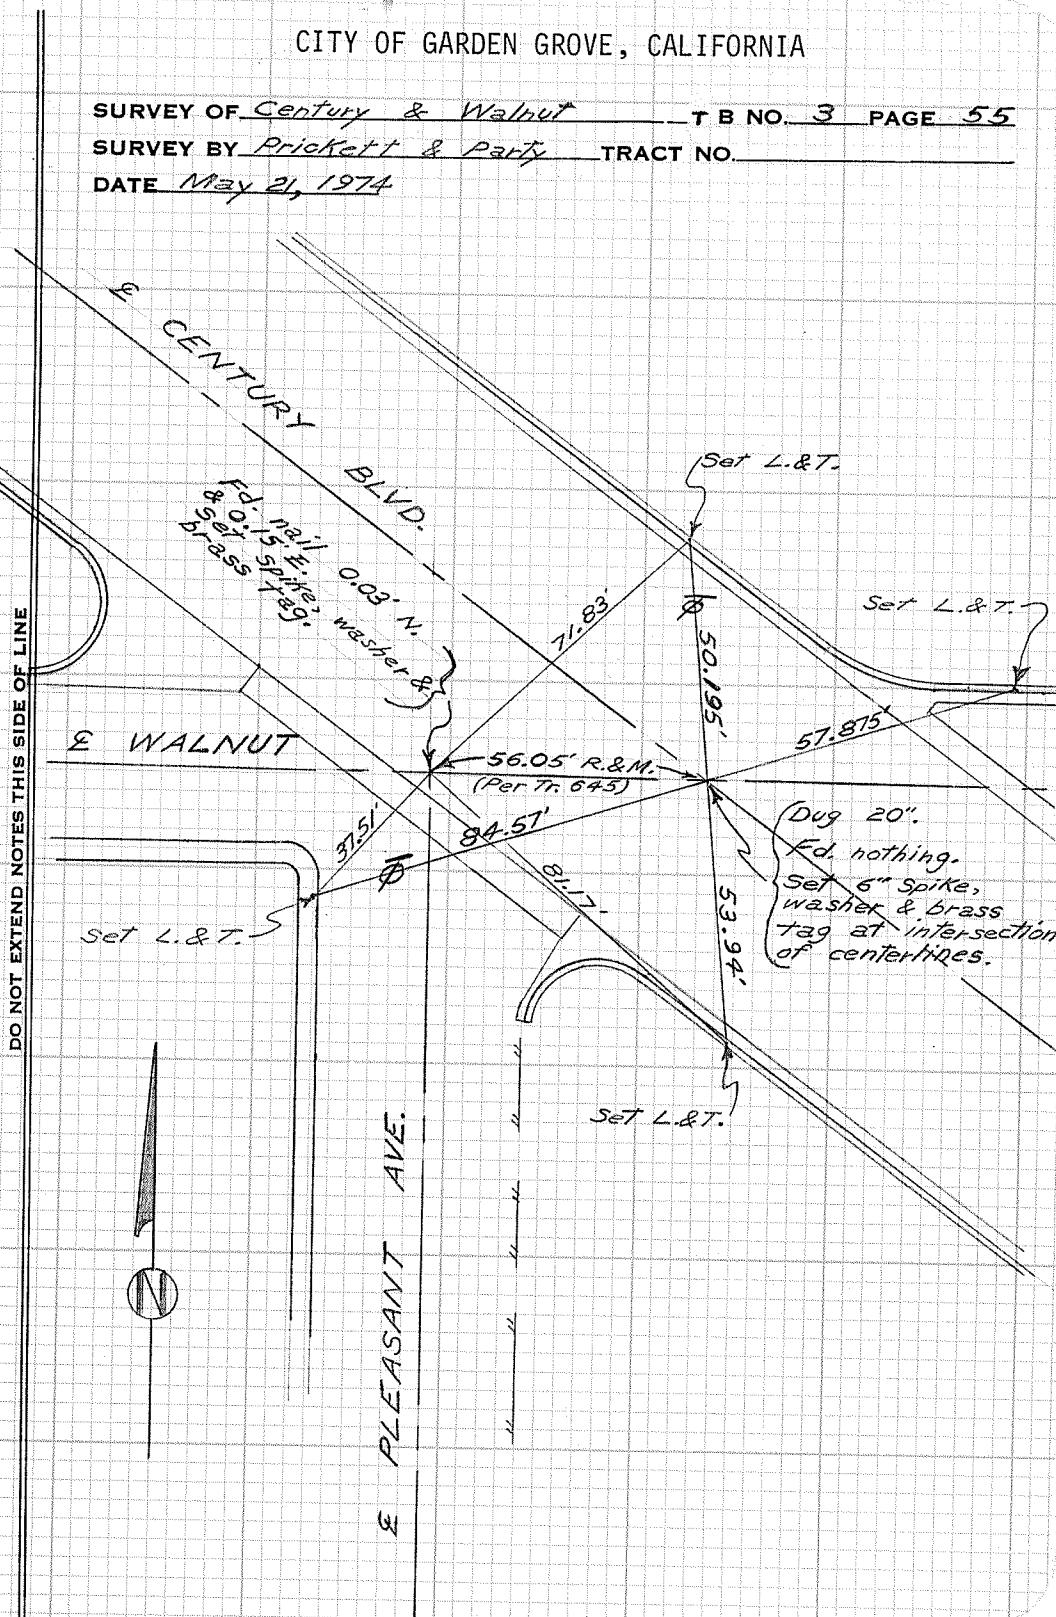

CITY OF GARDEN GROVE, CALIFORNIA


SURVEY OF Century Blvd. & Walnut & Pleasant T B NO. 3 PAGE 55A

SURVEY BY Prickett & Party **TRACT NO.**

DATE May 4, 1993

TA MESA - STOCK NO. 411
SURVEYORS SERVICE COMPANY.


DO NOT EXTEND NOTES THIS SIDE OF LINE

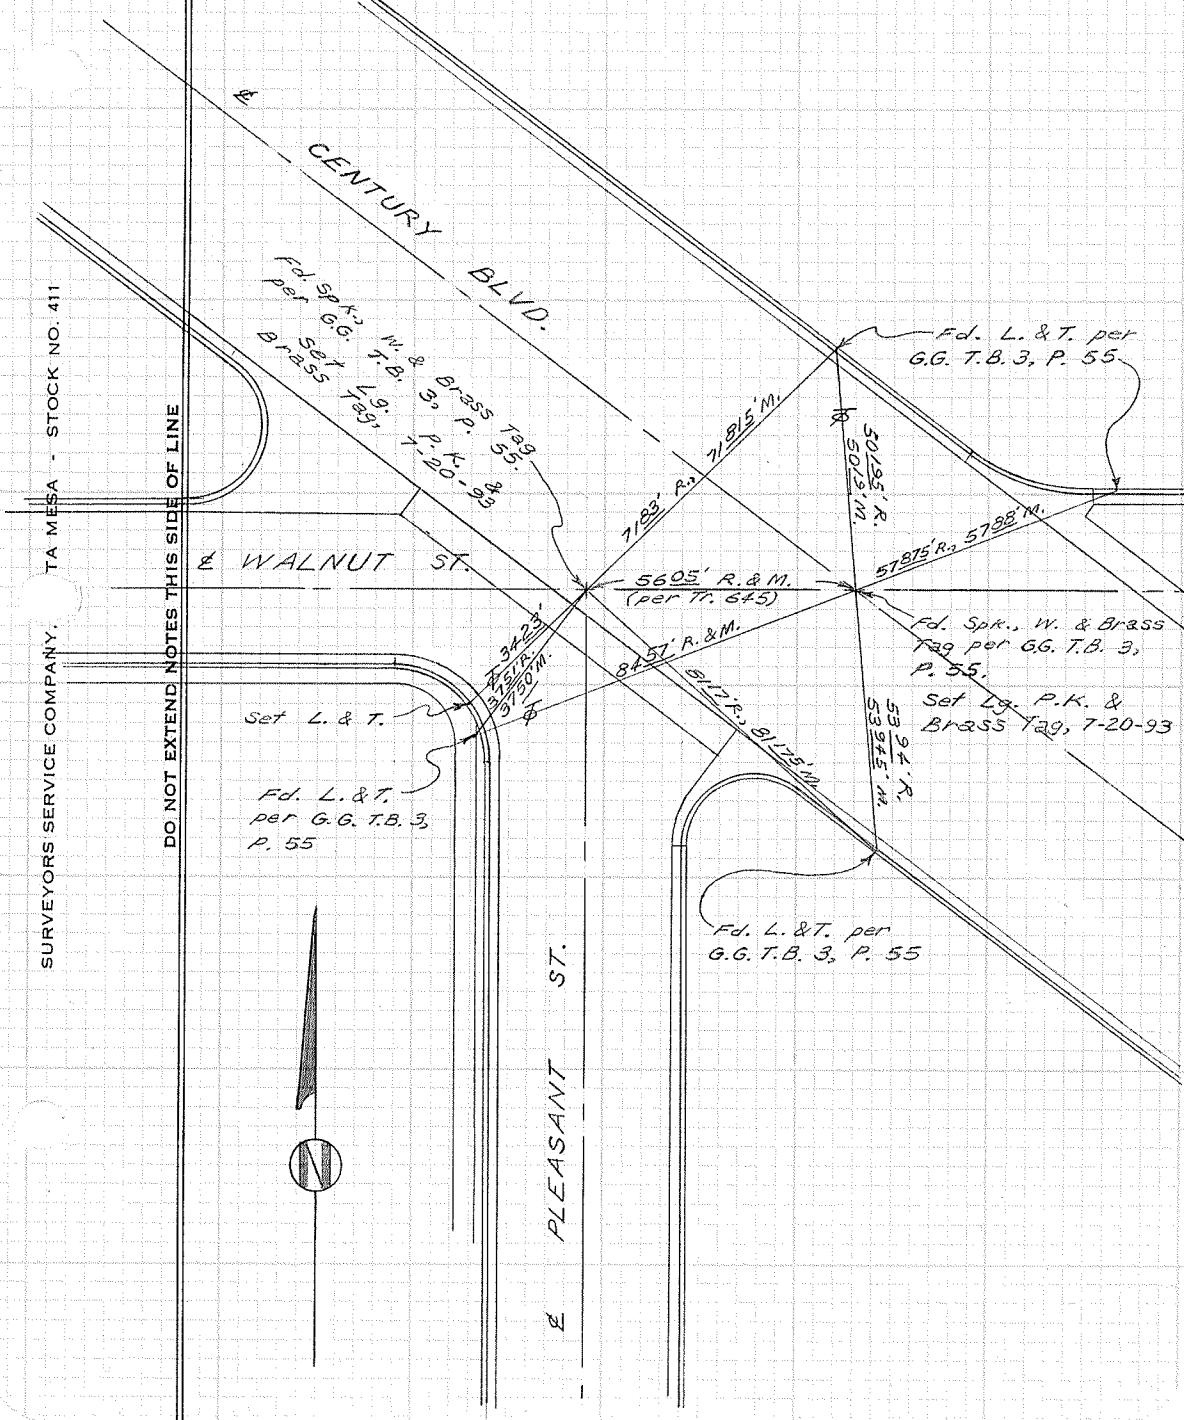

CITY OF GARDEN GROVE, CALIFORNIA

SURVEY OF Century & Westlake TB NO. 3 PAGE 56
SURVEY BY Prickett & Party TRACT NO.
DATE May 17, 1974

DO NOT EXTEND NOTES THIS SIDE OF LINE

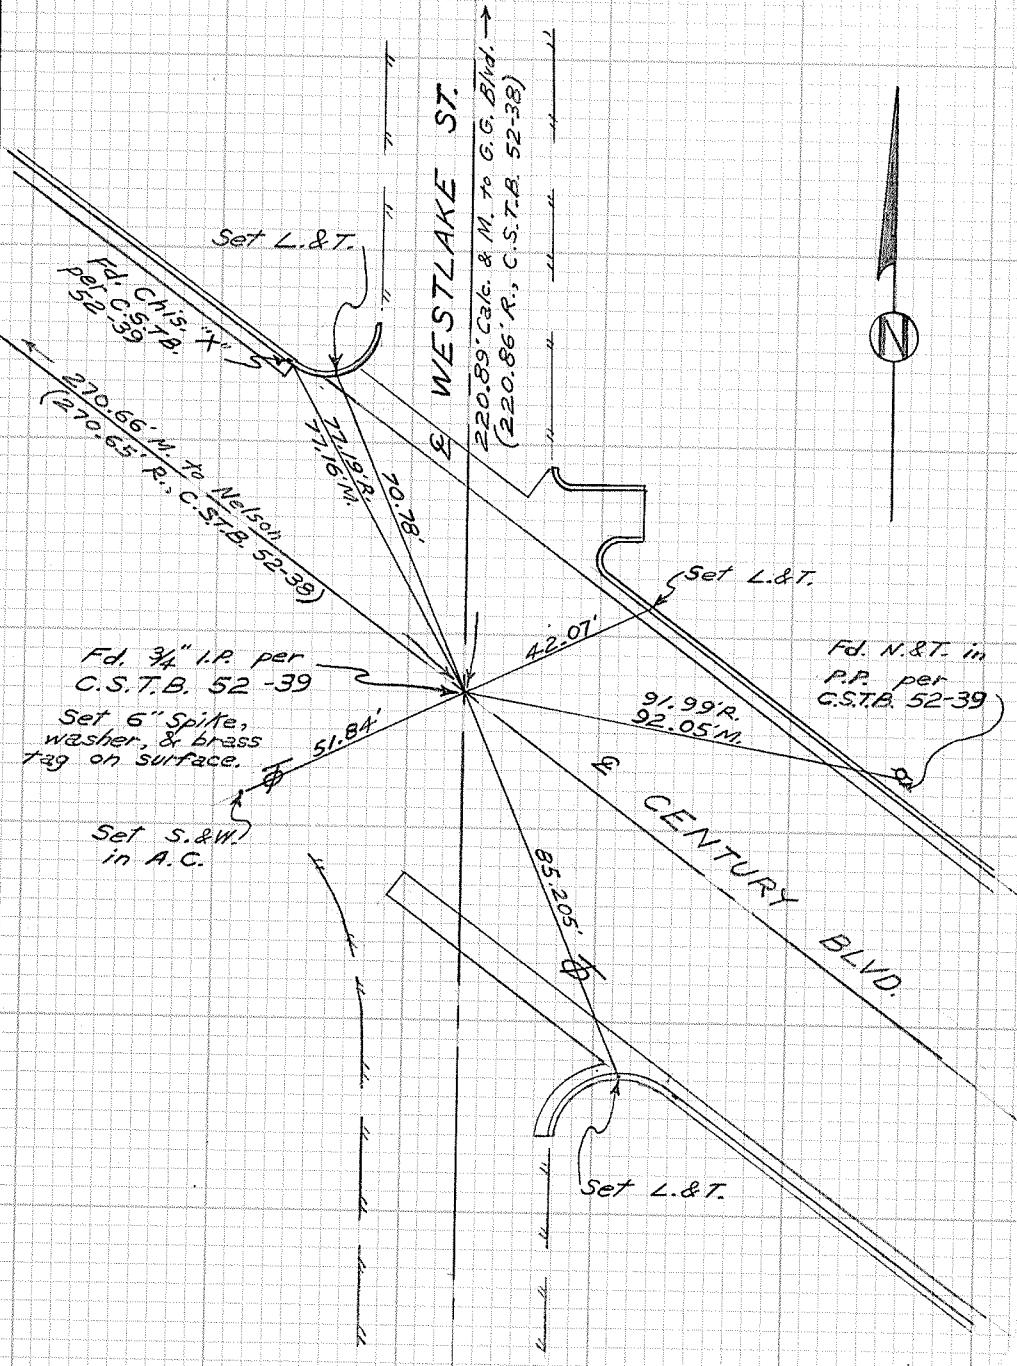


CITY OF GARDEN GROVE, CALIFORNIA

SURVEY OF Century Blvd. & Westlake T B NO. 3 PAGE 56A

SURVEY BY Prickett & Party TRACT NO.

DATE Oct. 22, 1977

DO NOT EXTEND NOTES THIS SIDE OF LINE

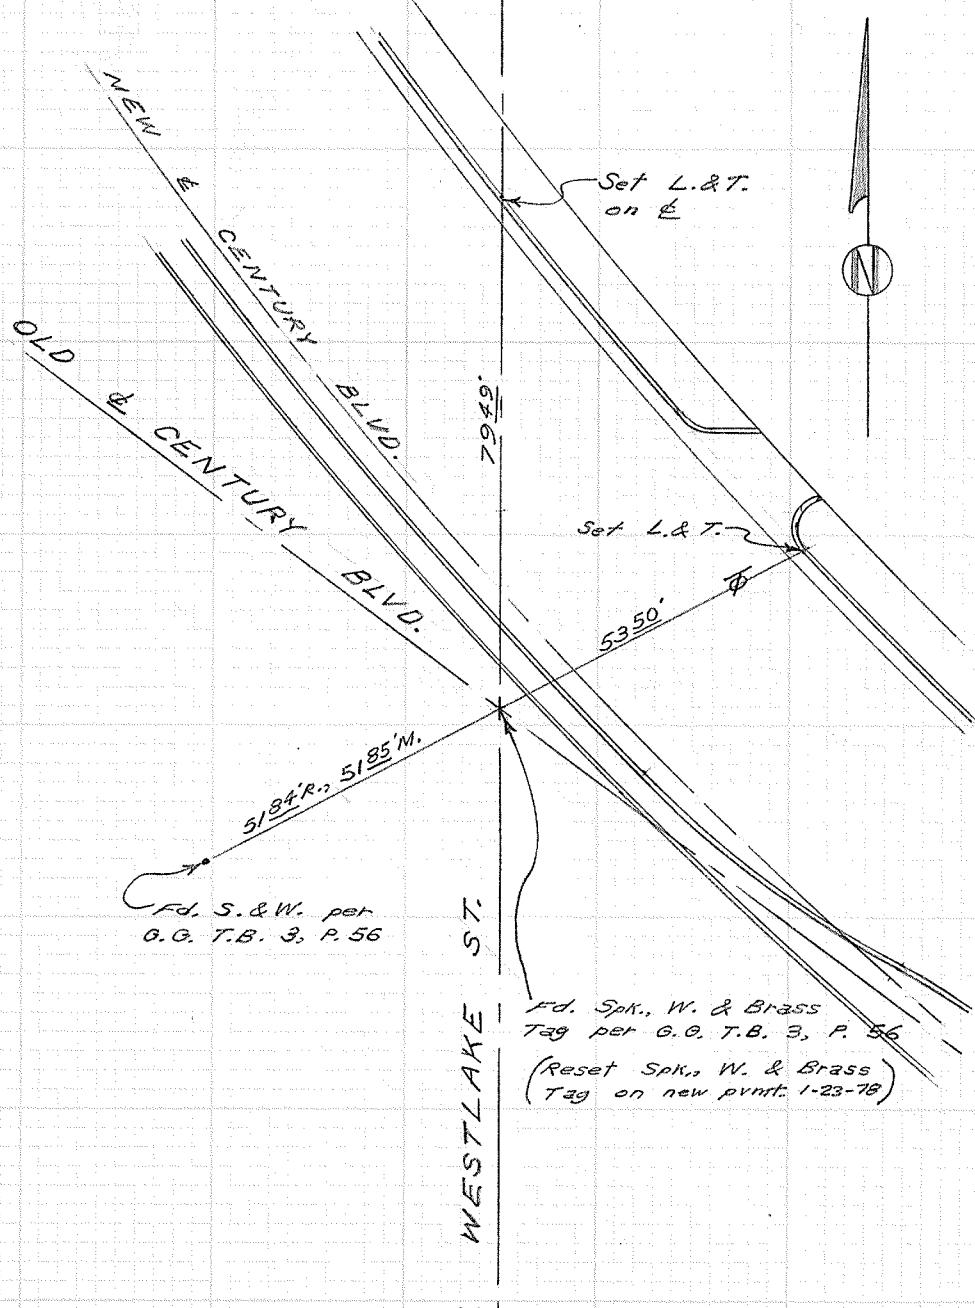


CITY OF GARDEN GROVE, CALIFORNIA

Garden Grove Blvd., Century,
 SURVEY OF Westlake & Nelson T B NO. 3 PAGE 57
 SURVEY BY Pritchett & Party TRACT NO.
 DATE MAY 21, 1974

DO NOT EXTEND NOTES THIS SIDE OF LINE

LAWFORD SURVEYORS SERVICE COMPANY, COSTA MESA - STOCK NO. 111

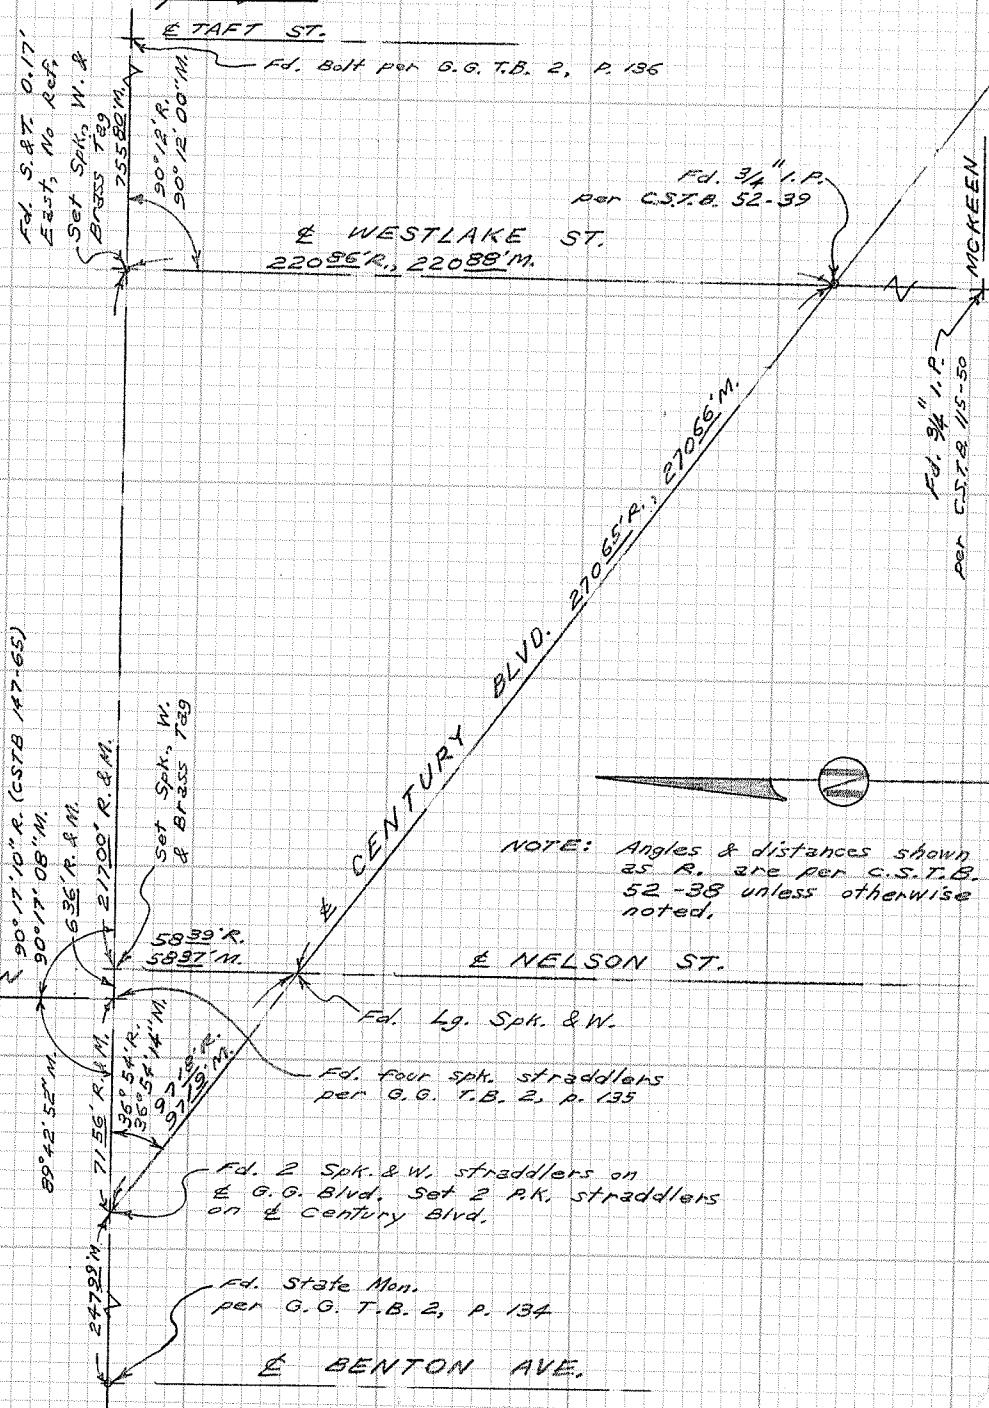


CITY OF GARDEN GROVE, CALIFORNIA

SURVEY OF Gdn. Grove Blvd., Century, Nelson T.B. NO. 3 PAGE 57A
 SURVEY BY PRICKETT & PARTNERS TRACT NO.
 DATE OCT. 18, 1978

DO NOT EXTEND NOTES THIS SIDE OF LINE

STA MESA - STOCK NO. 41

SURVEYORS SERVICE COMPANY

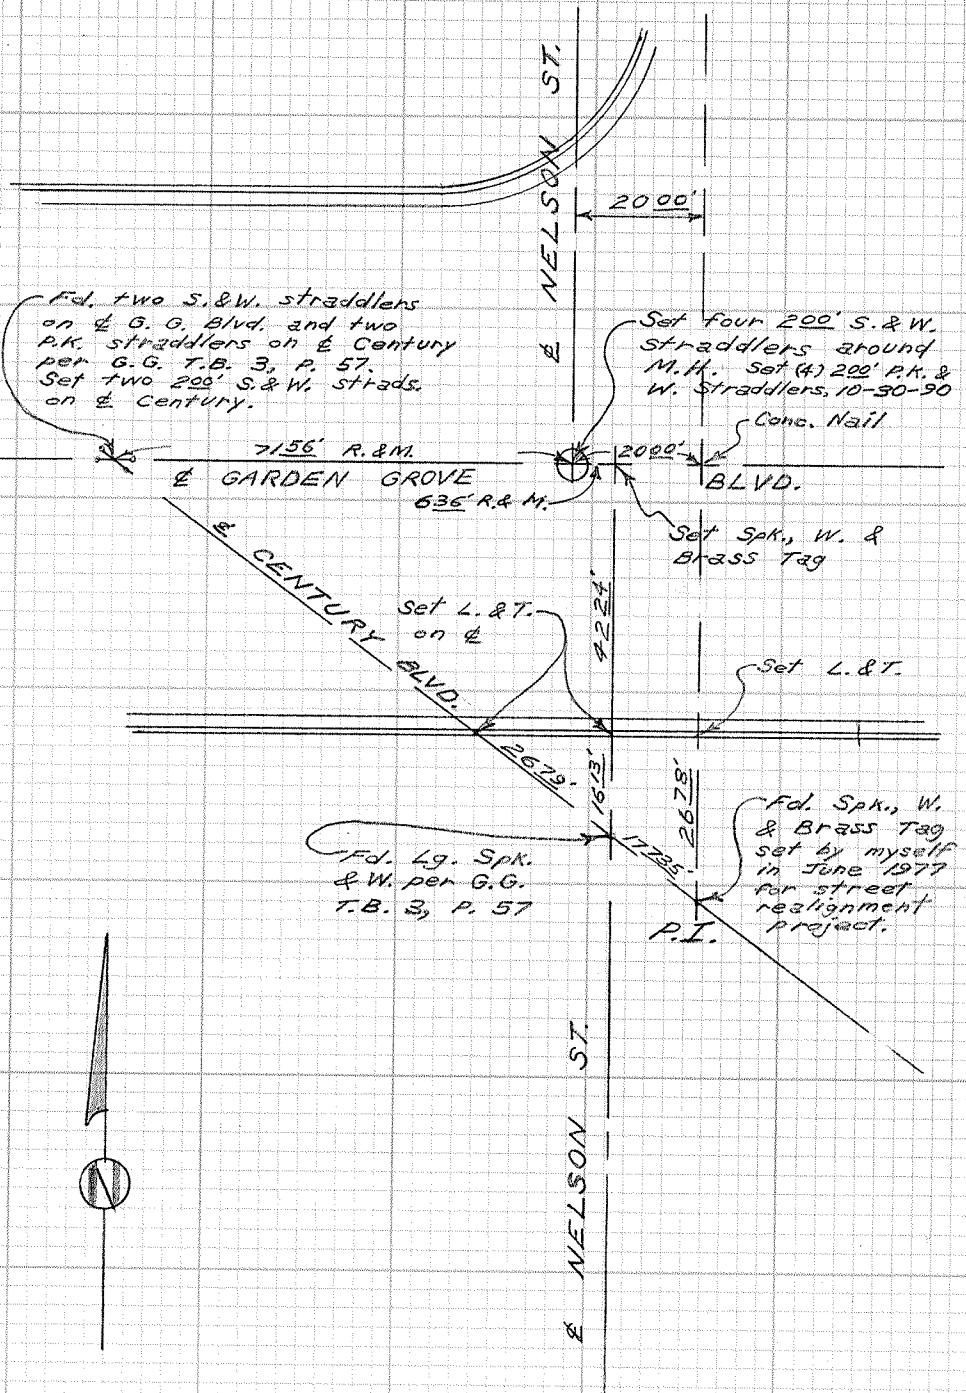

CITY OF GARDEN GROVE, CALIFORNIA


SURVEY OF Westlake & McKeen

T B NO. 3 PAGE 58

SURVEY BY Prickett & Party TRACT NO.

DATE May 17, 1974

DO NOT EXTEND NOTES THIS SIDE OF LINE

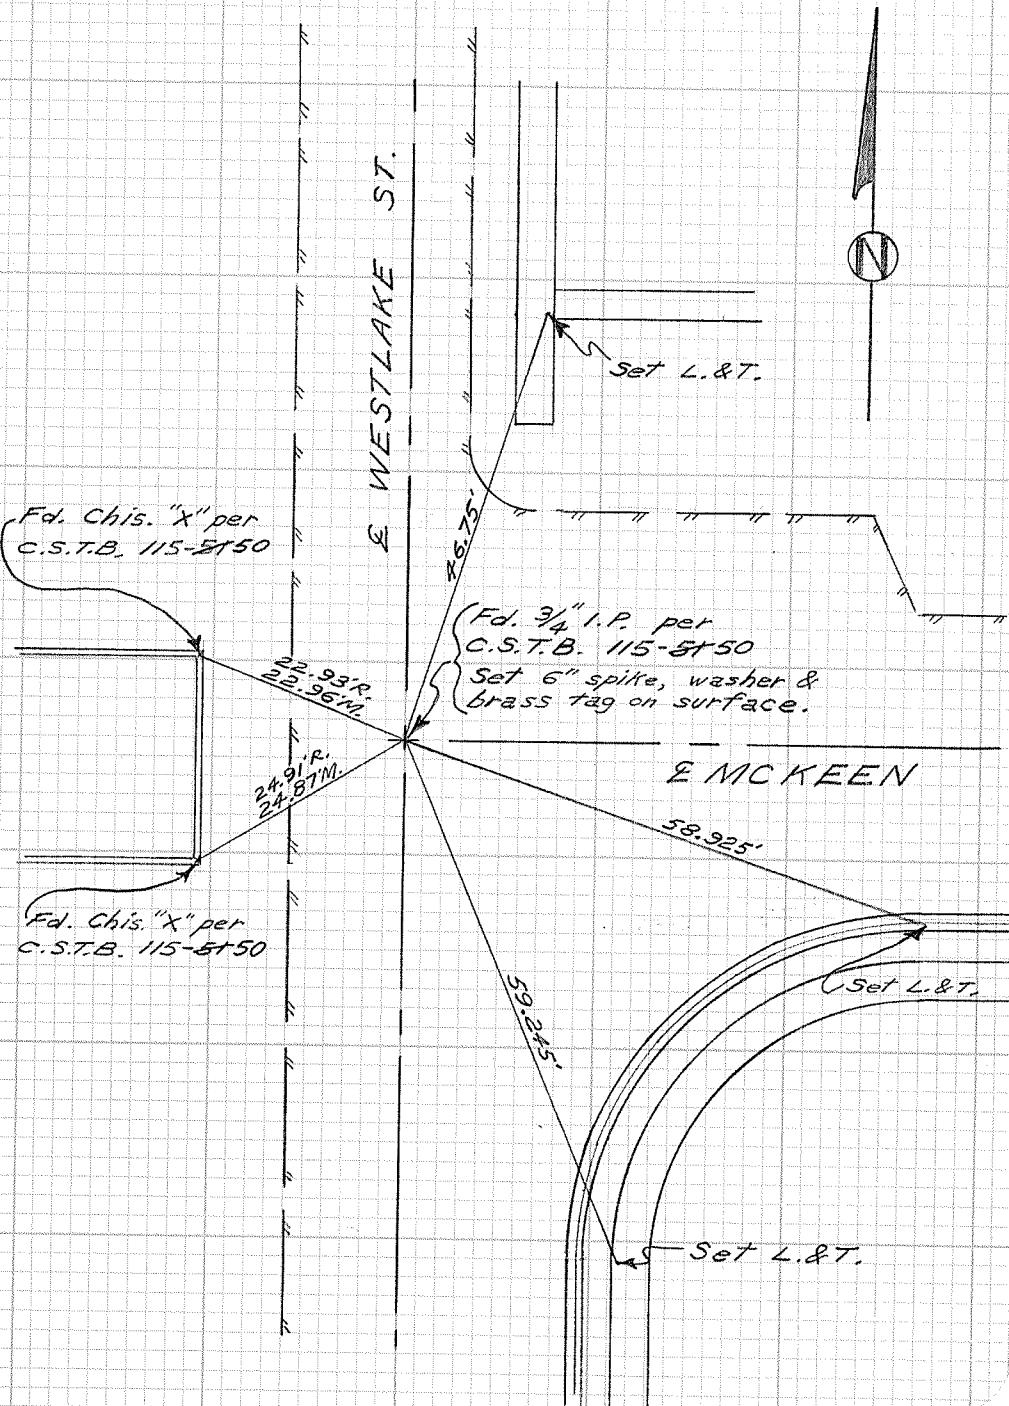


CITY OF GARDEN GROVE, CALIFORNIA

SURVEY OF Westlake & McKeen T B NO. 3 PAGE 58A
SURVEY BY Prickett & Party TRACT NO.
DATE Sept. 27, 1979

STAMPEA - STOCK NO. 411

SURVEYORS SERVICE COMPANY


DO NOT EXTEND NOTES THIS SIDE OF LINE

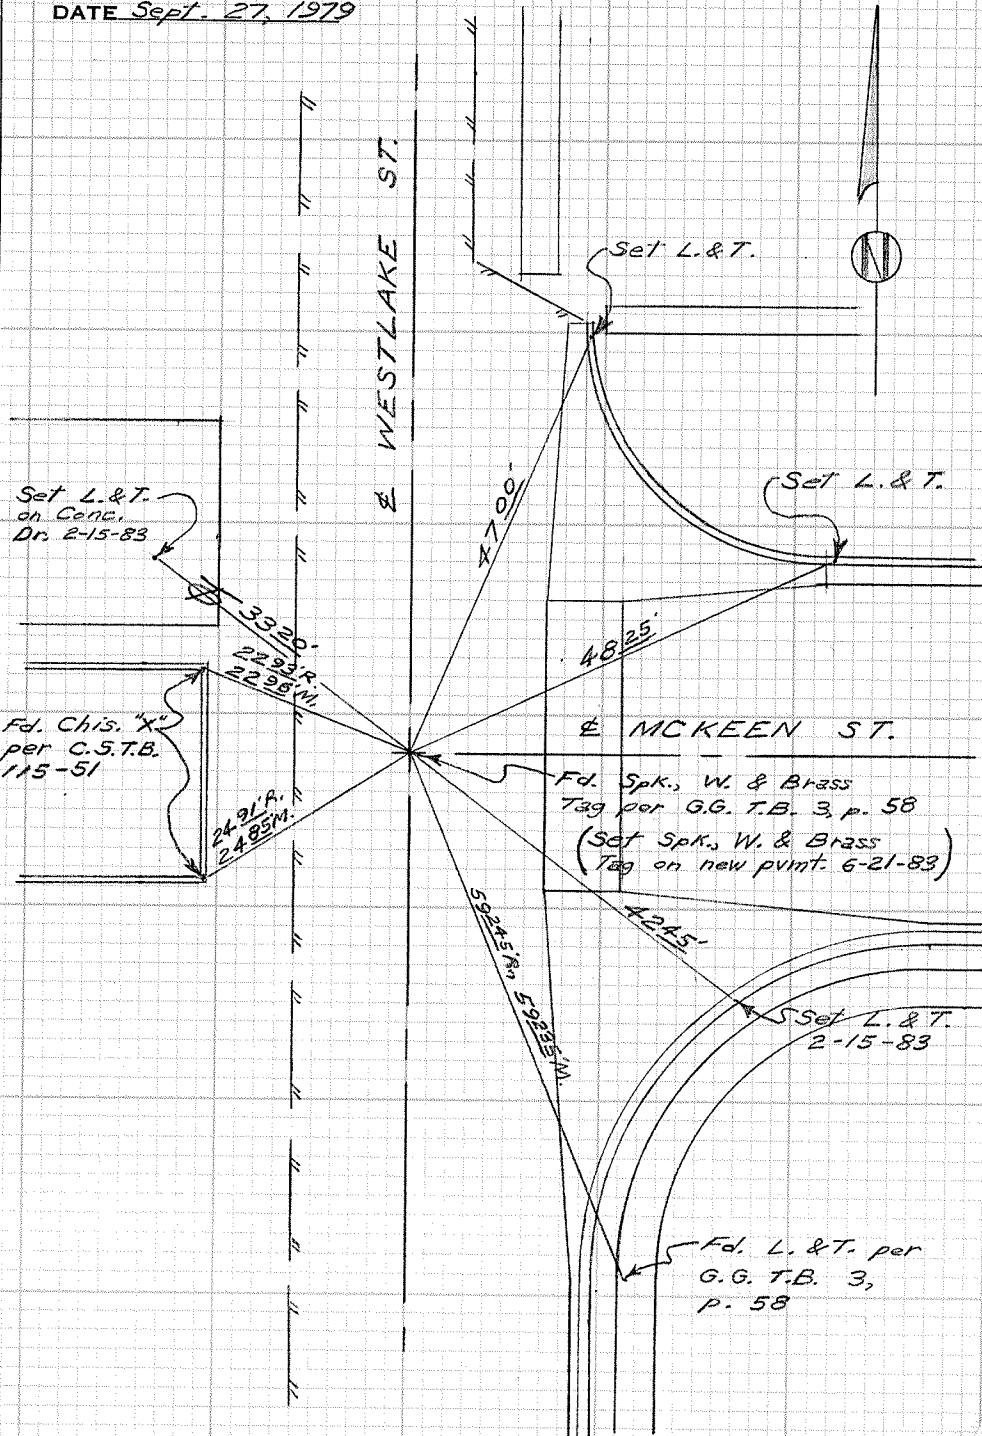

CITY OF GARDEN GROVE, CALIFORNIA

SURVEY OF Chapman & Loara TB NO. 3 PAGE 59
 SURVEY BY Prickett & Party TRACT NO.
 DATE Feb. 6, 1975

DO NOT EXTEND NOTES THIS SIDE OF LINE

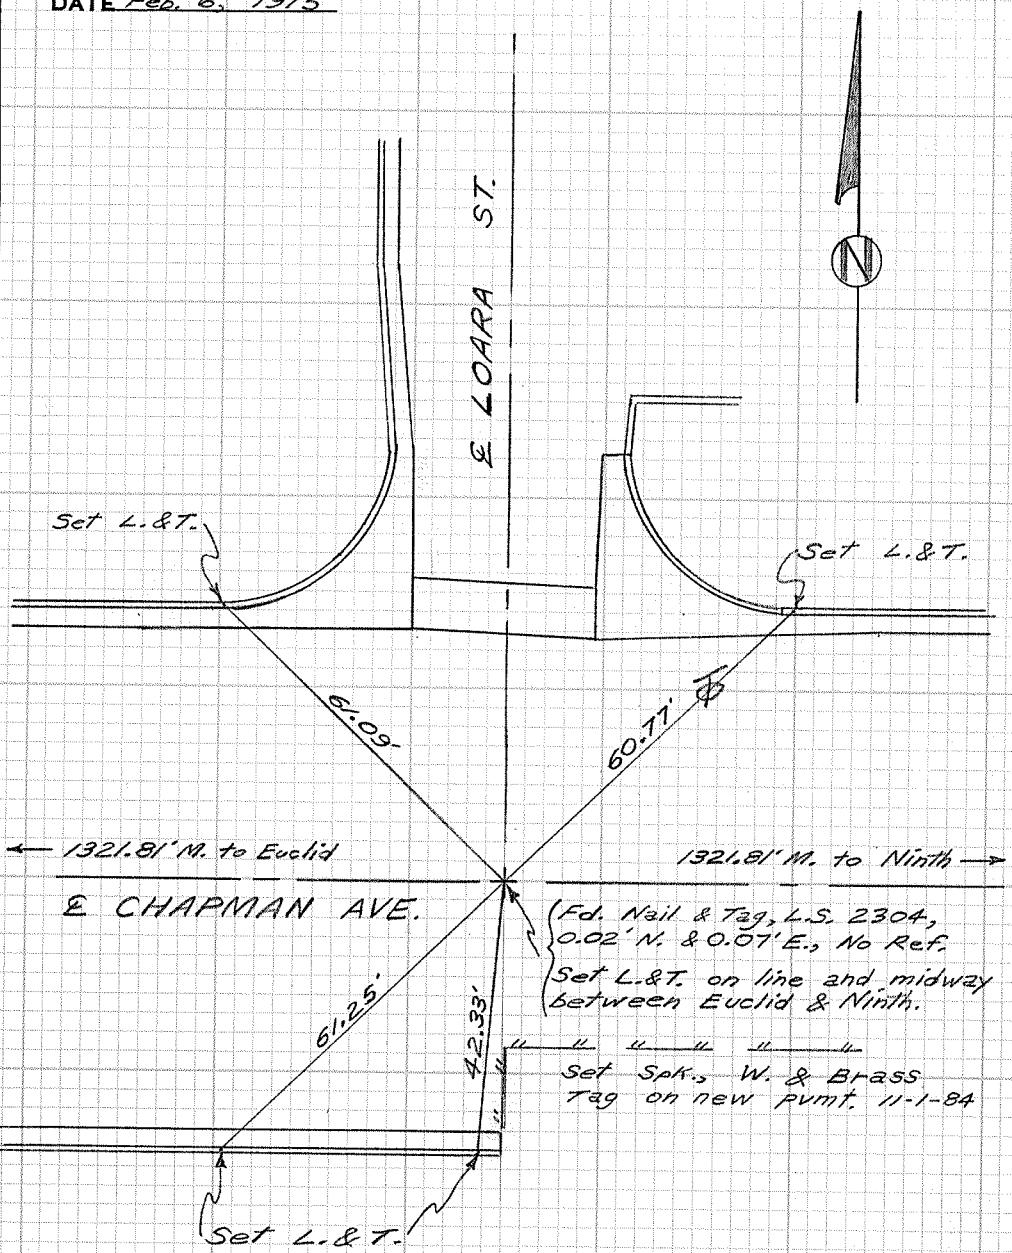


CITY OF GARDEN GROVE, CALIFORNIA

SURVEY OF Chapman Ave. & Loara St. T.B. NO. 3 PAGE 59A
SURVEY BY Prickett & Party TRACT NO.
DATE Oct. 26, 1990

SURVEYORS SERVICE COMPANY, TA MESA - STOCK NO: 411


DO NOT EXTEND NOTES THIS SIDE OF LINE

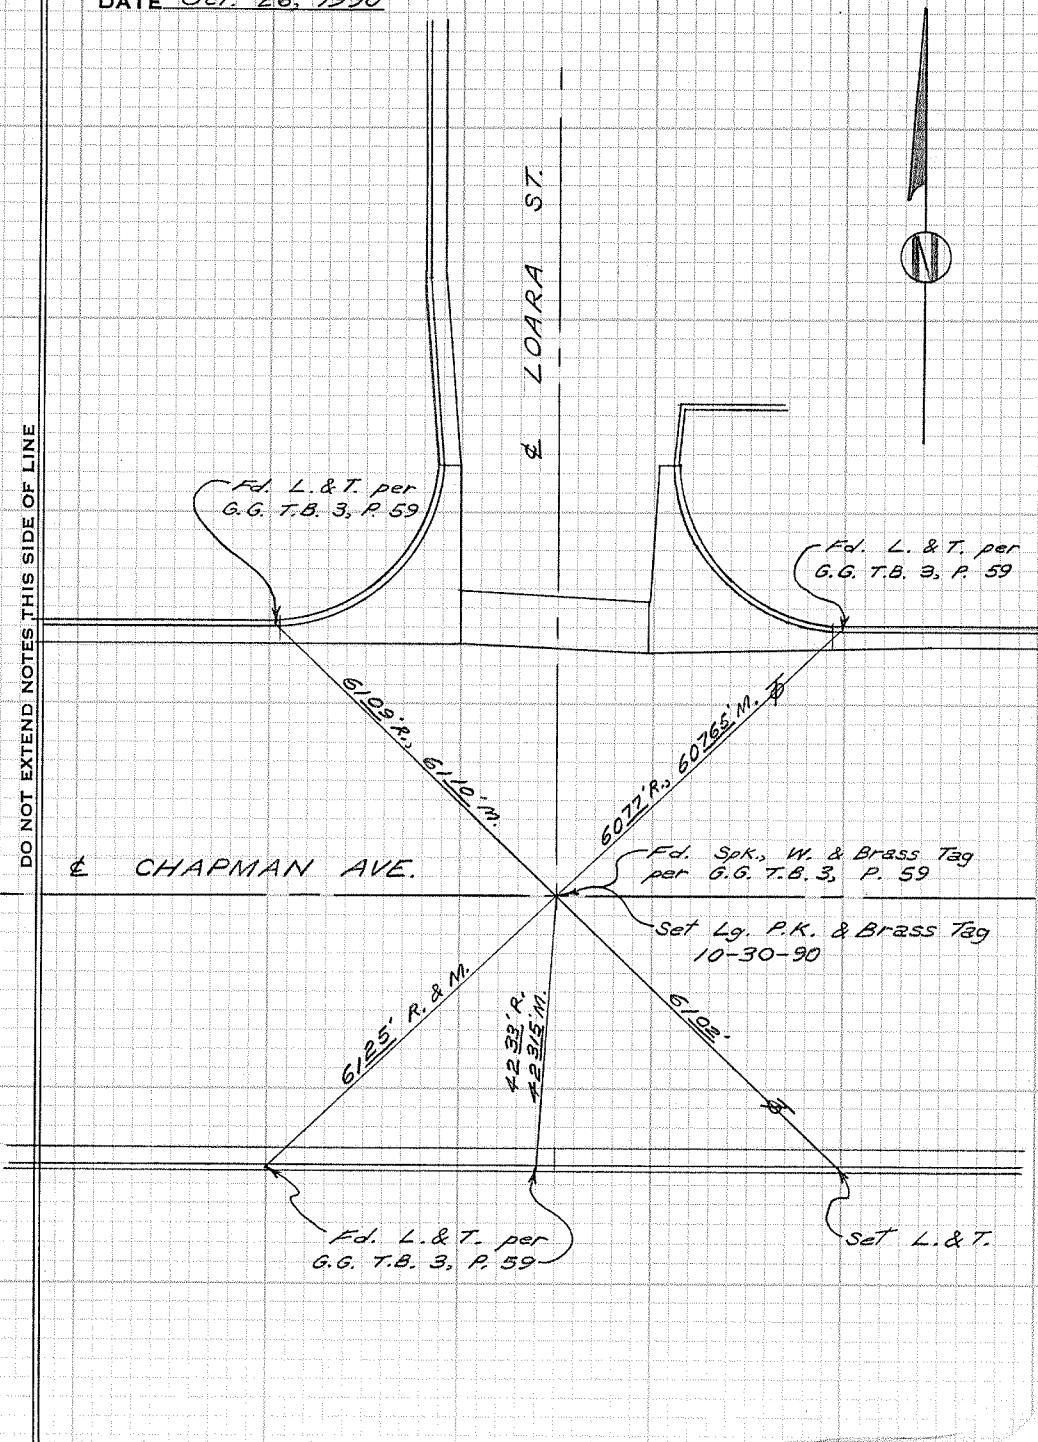

CITY OF GARDEN GROVE, CALIFORNIA

SURVEY OF Orangewood & Loara TB NO 3 PAGE 60
SURVEY BY Prickett & Party TRACT NO.
DATE Feb. 6, 1975


DO NOT EXTEND NOTES THIS SIDE OF LINE

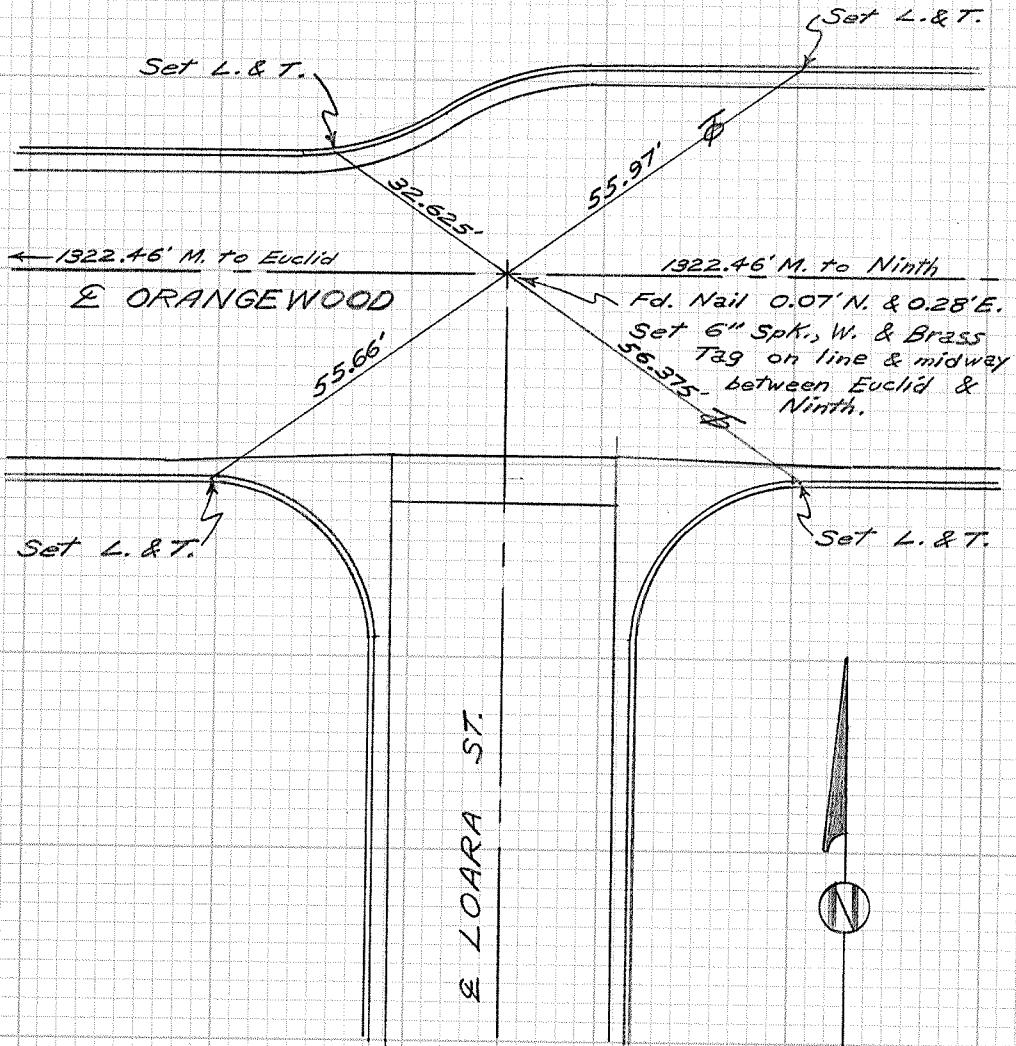

CITY OF GARDEN GROVE, CALIFORNIA

SURVEY OF Loara & Bixler TB NO. 3 PAGE 61
SURVEY BY Prickett & Party TRACT NO.
DATE Feb. 6, 1975

DO NOT EXTEND NOTES THIS SIDE OF LINE

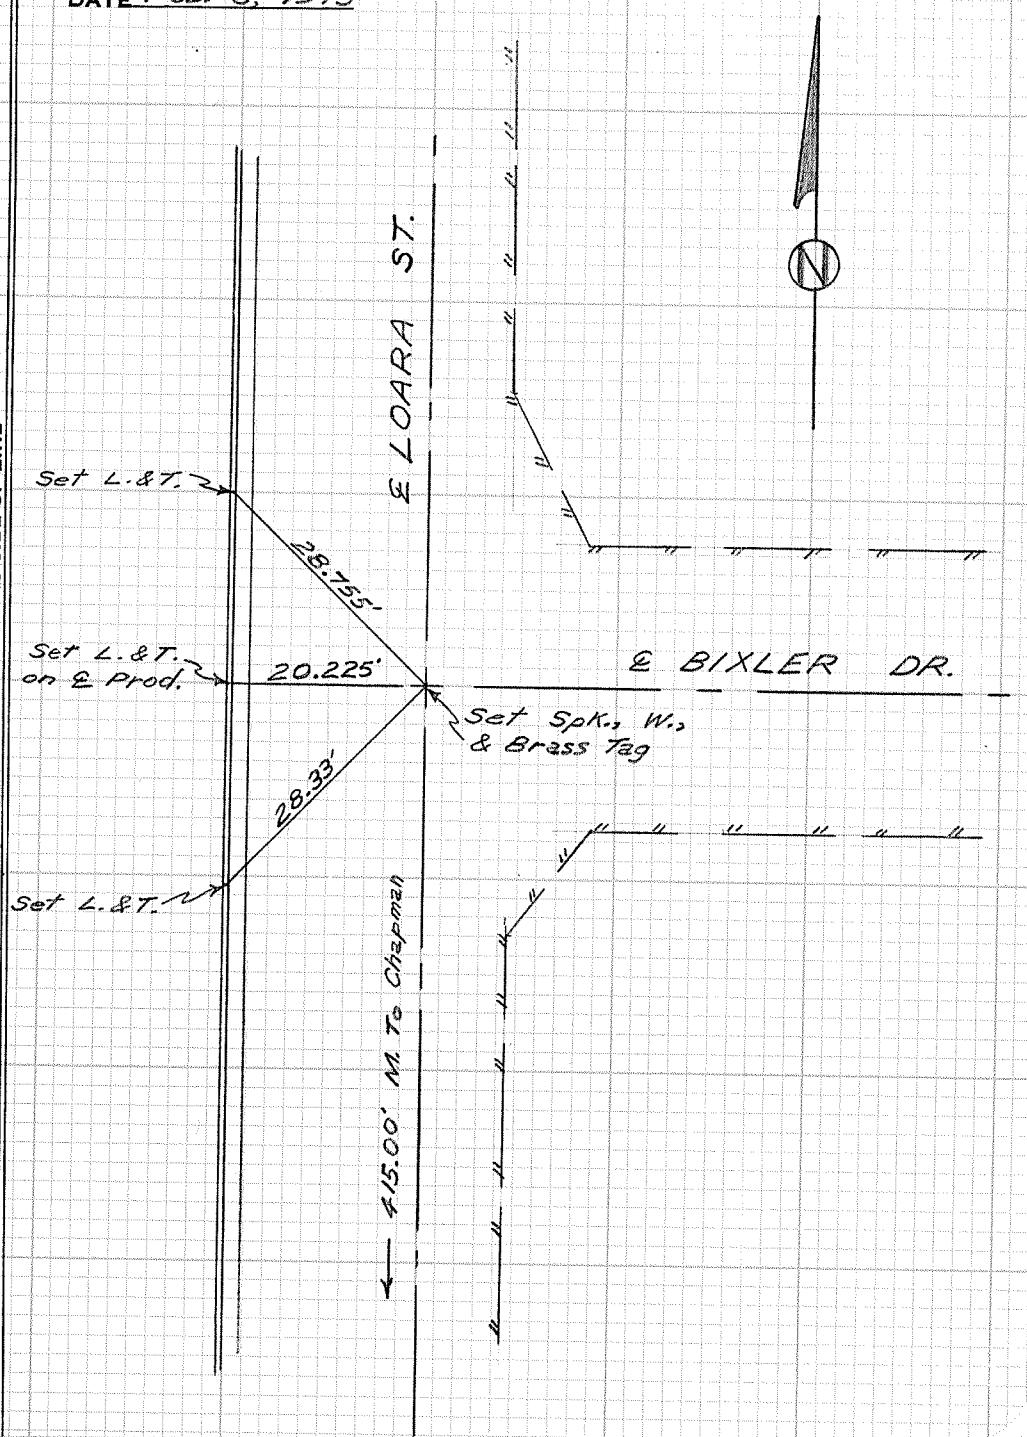

CITY OF GARDEN GROVE, CALIFORNIA

SURVEY OF Loara & Bixler T B NO. 3 PAGE 61A

SURVEY BY Prickett & Party TRACT NO.

DATE Oct. 17, 1979

STA. MESA - STOCK NO. 411

SURVEYORS SERVICE COMPANY

DO NOT EXTEND NOTES THIS SIDE OF LINE

Fd. L.&T.,
per G.G. T.B. 3,
P. 61

Fd. L.&T.,
& Prod. per
G.G.T.B. 3,
P. 61

Fd. L.&T.,
per G.G. T.B. 3,
P. 61

20225' R&M.

2833' R&M.

2875' R&M.

LOARA ST.

29645' S.

3002'

@ BIXLER DR.

Fd. four 200' S. & W.
straddlers around M.H.

Set L.&T.

Set L.&T.
3-24-80

DO NOT EXTEND NOTES THIS SIDE OF LINE

CITY OF GARDEN GROVE, CALIFORNIA

N.E. Cor. of S.W. $\frac{1}{4}$ of S.W. $\frac{1}{4}$ Sec. 28

SURVEY OF Loara & N. City Limits TB NO. 3 PAGE 62

SURVEY BY Pickett & Party TRACT NO.

DATE April 16, 1975

CITY T.B. 3, p. 60

E ORANGEWOOD

N. line of S. $\frac{1}{2}$ of
S. $\frac{1}{4}$ of Sec. 28,
T. 4 S., R. 10 W.

Set L.&T.

Set L.&T.

32.52'

1817.91' N. to Chapman

E LOARA ST.

Dug 20", Fd. Nothing.
Set 6" Spk., W. & Brass
Tag on surface. Also
set four S. & W. straddlers.

Set

6"

Spk.

W.

&

Brass

Tag

on

surface.

Also

set

four

S.

&

W.

straddlers.

.

.

E CHAPMAN

CITY T.B. 3, p. 59


CITY T.B. 3, p. 60

CITY T.B. 3, p. 60

CITY OF GARDEN GROVE, CALIFORNIA

SURVEY OF Stanford & Hazel TB NO. 3 PAGE 63
 SURVEY BY Prickett & Party TRACT NO.
 DATE JANUARY 12, 1976


DO NOT EXTEND NOTES THIS SIDE OF LINE

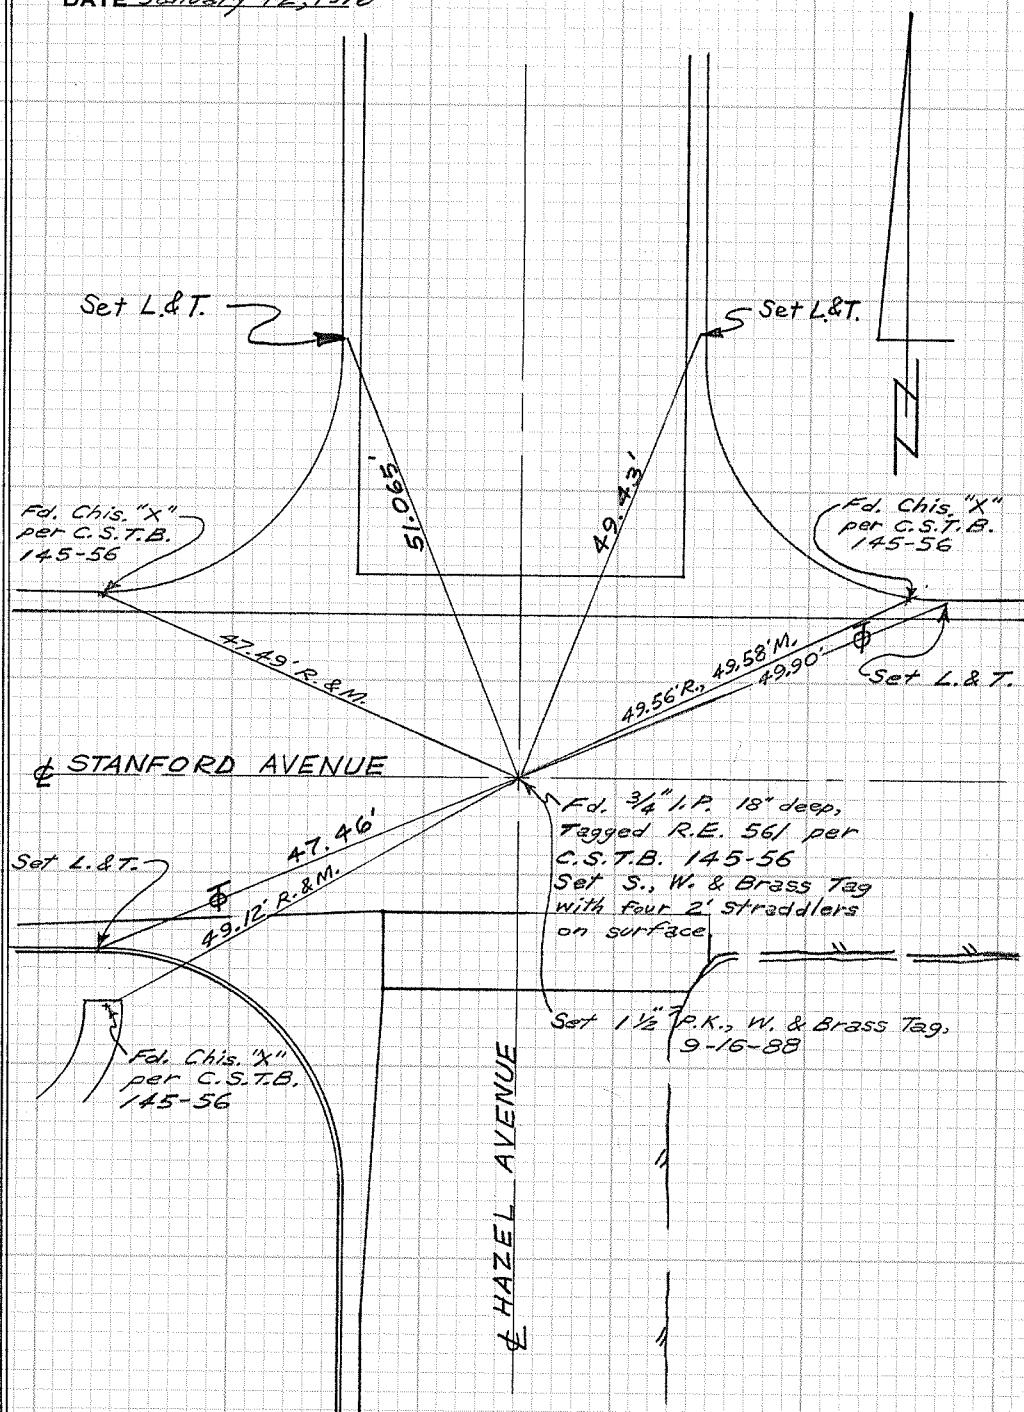

CITY OF GARDEN GROVE, CALIFORNIA

SURVEY OF Stanford & Lucille TB NO. 3 PAGE 64
 SURVEY BY Prickett & Party TRACT NO.
 DATE January 13, 1976

DO NOT EXTEND NOTES THIS SIDE OF LINE

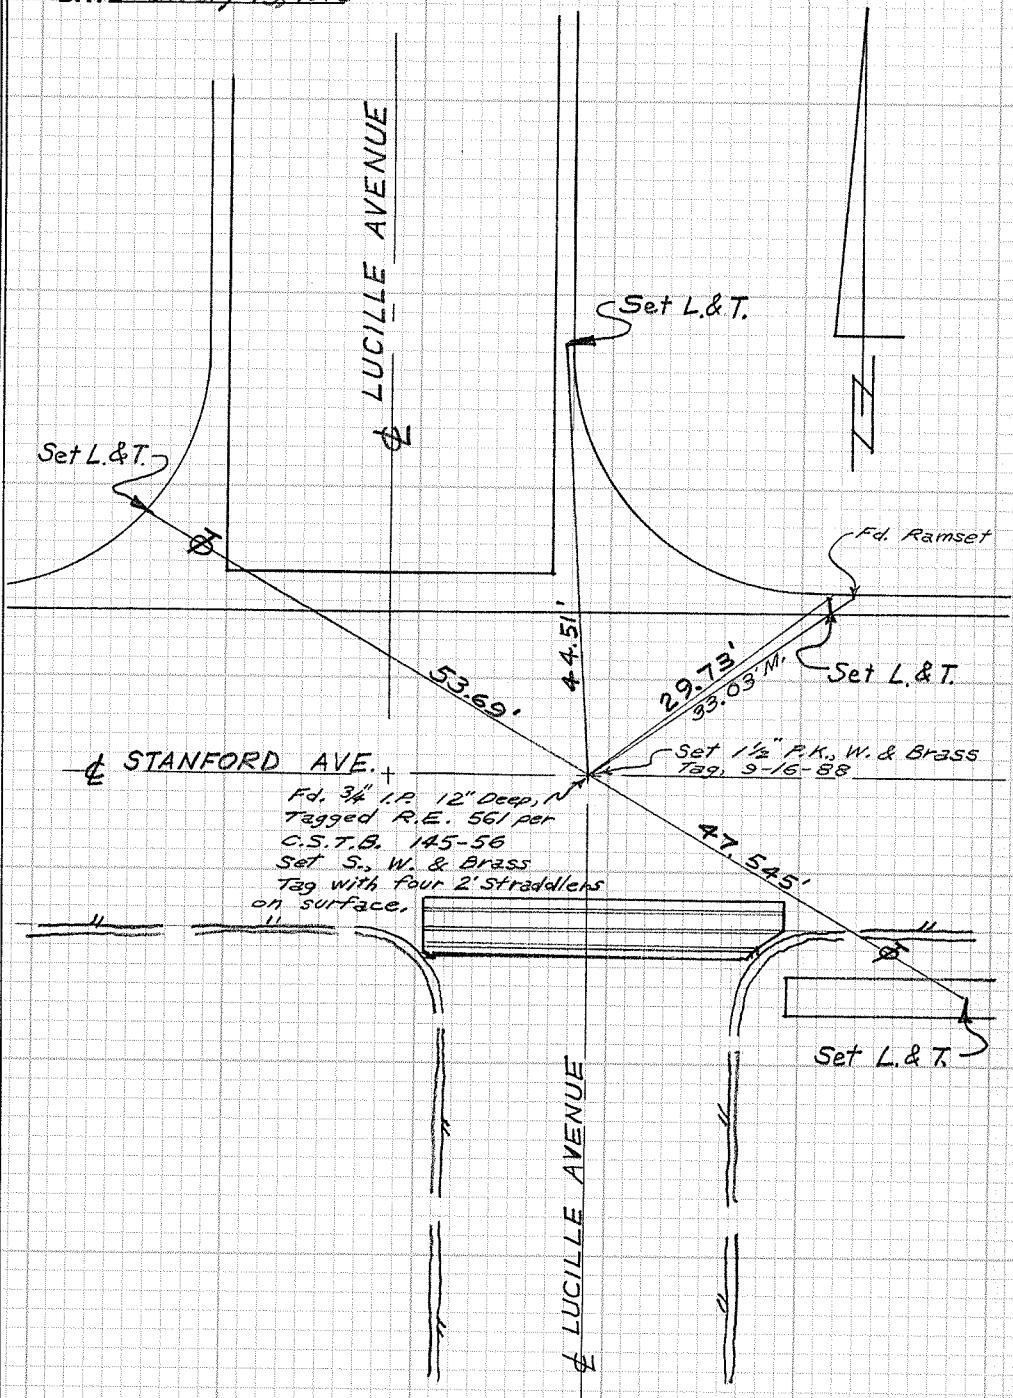


SURVEYORS SERVICE COMPANY DSTA MESA - STOCK NO. 411

CITY OF GARDEN GROVE, CALIFORNIA

SURVEY OF Taft St & Walnut St. T.B. NO. 3 PAGE 65
SURVEY BY Prickett & Party TRACT NO.
DATE Jan. 18, 1977

DO NOT EXTEND NOTES THIS SIDE OF LINE

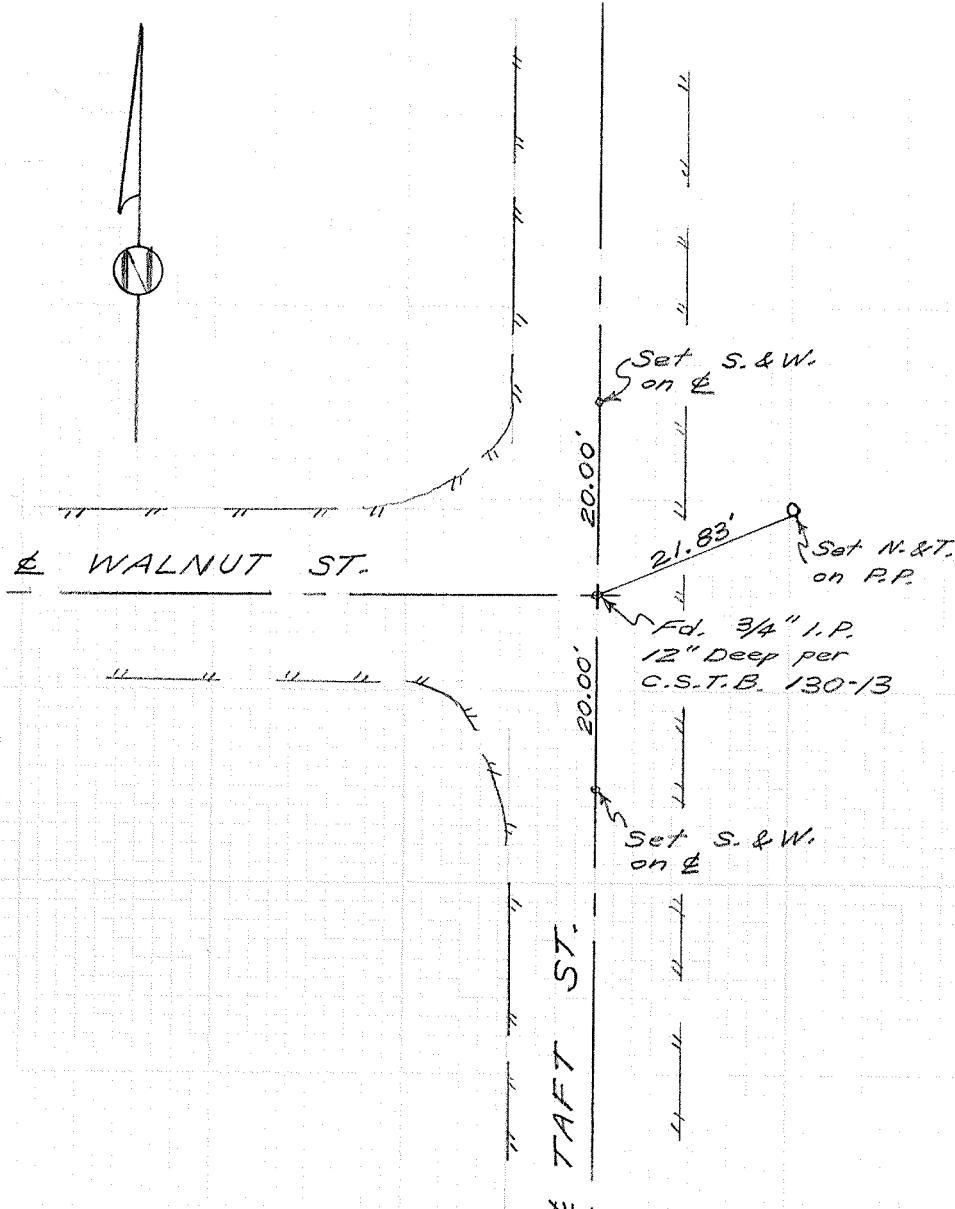

CITY OF GARDEN GROVE, CALIFORNIA

SURVEY OF Taft St. & Walnut St. T B NO. 3 PAGE 65A
SURVEY BY PRICKETT & PARTNERS TRACT NO. 645
DATE JAN. 29, 1982

11

STA MESA STOCK NO. 411

SURVEYORS SERVICE COMPANY

DO NOT EXTEND NOTES THIS SIDE OF LINE

E WALNUT ST.
5000'

Set S. & W. on E

E TAFT ST.

2000' R.M.

Fd. S. & W. on E
per G.G. T.B. 3, P. 65

Fd. four 200' straddlers
around M.H.
(Set four 200' straddlers on)
new pavement 3-10-82
3500'

Set Brass Tack
in 2"x2" Hub on
& Prod.


Fd. S. & W. on E
per G.G. T.B. 3, P. 65

CITY OF GARDEN GROVE, CALIFORNIA

SURVEY OF Taft St. & Walnut St. T.B. NO. 3 PAGE 658
SURVEY BY Prickett & Party TRACT NO. 645
DATE Sept. 1, 1989

SURVEYORS SERVICE COMPANY STA MESA - STOCK NO. 411

DO NOT EXTEND NOTES THIS SIDE OF LINE

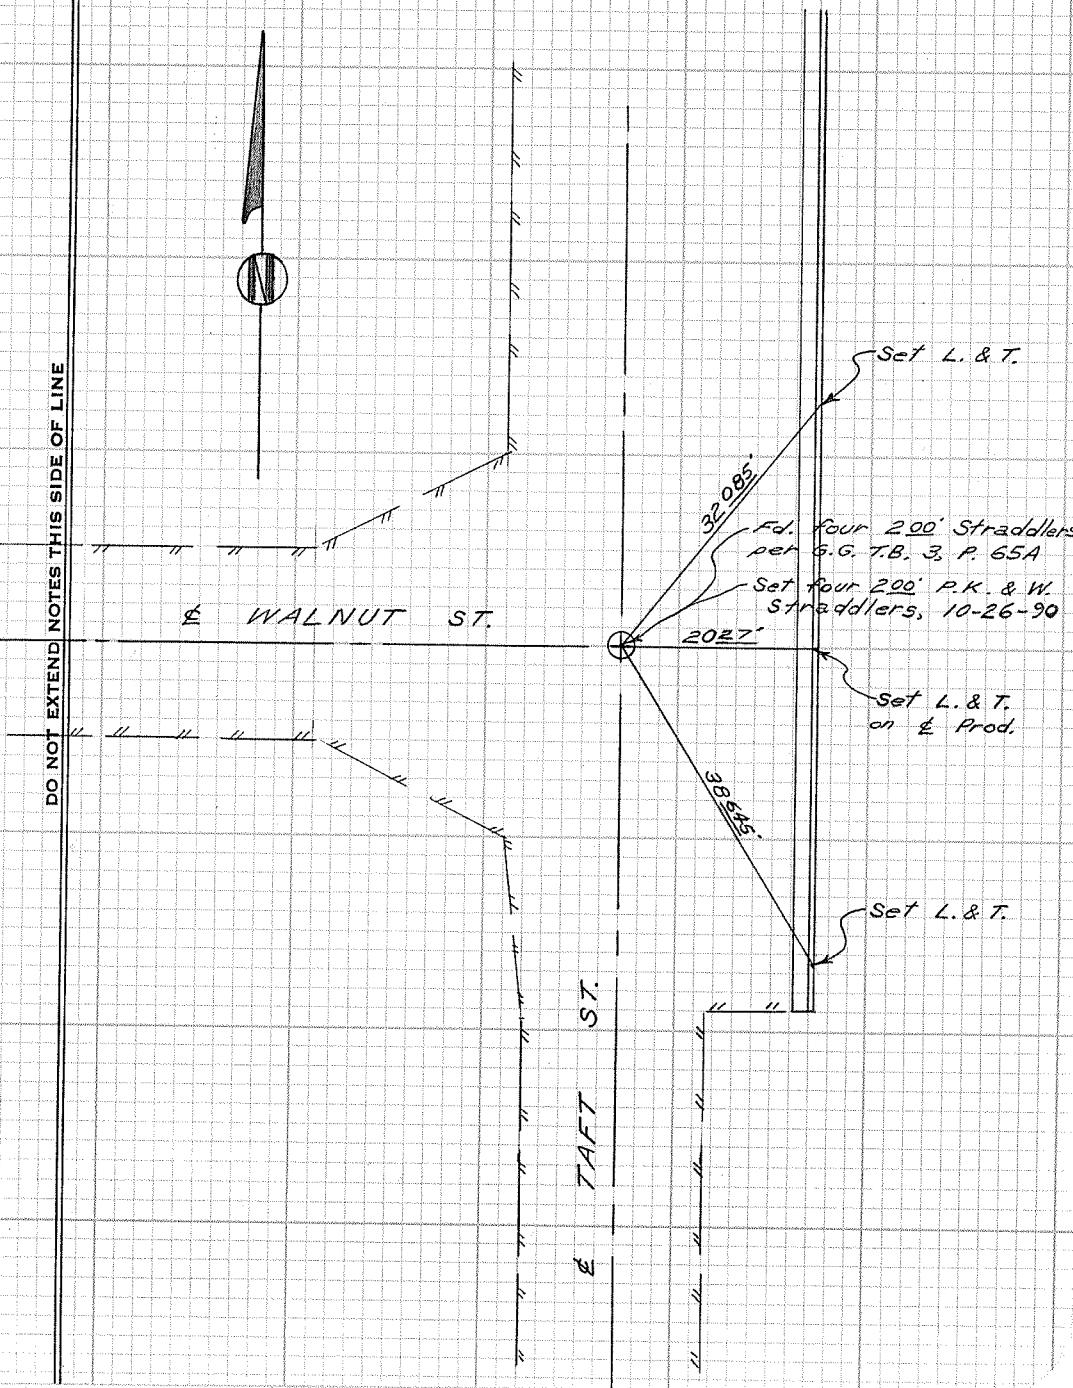

CITY OF GARDEN GROVE, CALIFORNIA

SURVEY OF Trask & E. W. of Brookhurst T B NO. 3 PAGE 66

SURVEY BY Prickett & Party TRACT NO.

DATE August 17, 1978

Set L.&T. on
conc. S.W.

Set L.&T. →

CONST. E TRASK AVE.

Fd. State Div. Hwy.
Survey Mon. per
AOR022C, p. 0063

Set R.R. spike with
4 S.E.W. straddlers
10-17-78

Set L.&T.
(10-17-78)

Set L.&T.
(10-17-78)

DO NOT EXTEND NOTES THIS SIDE OF LINE

Set L.&T. on T.C.
on S'ly. side freeway
offramp




CITY OF GARDEN GROVE, CALIFORNIA

SURVEY OF Trask Ave. & N. W. of Brookhurst T B NO. 3 PAGE 66A
SURVEY BY Prickett & Party TRACT NO.
DATE Oct. 14, 1991

TA MESA STOCK NO. 411


SURVEYORS SERVICE COMPANY,

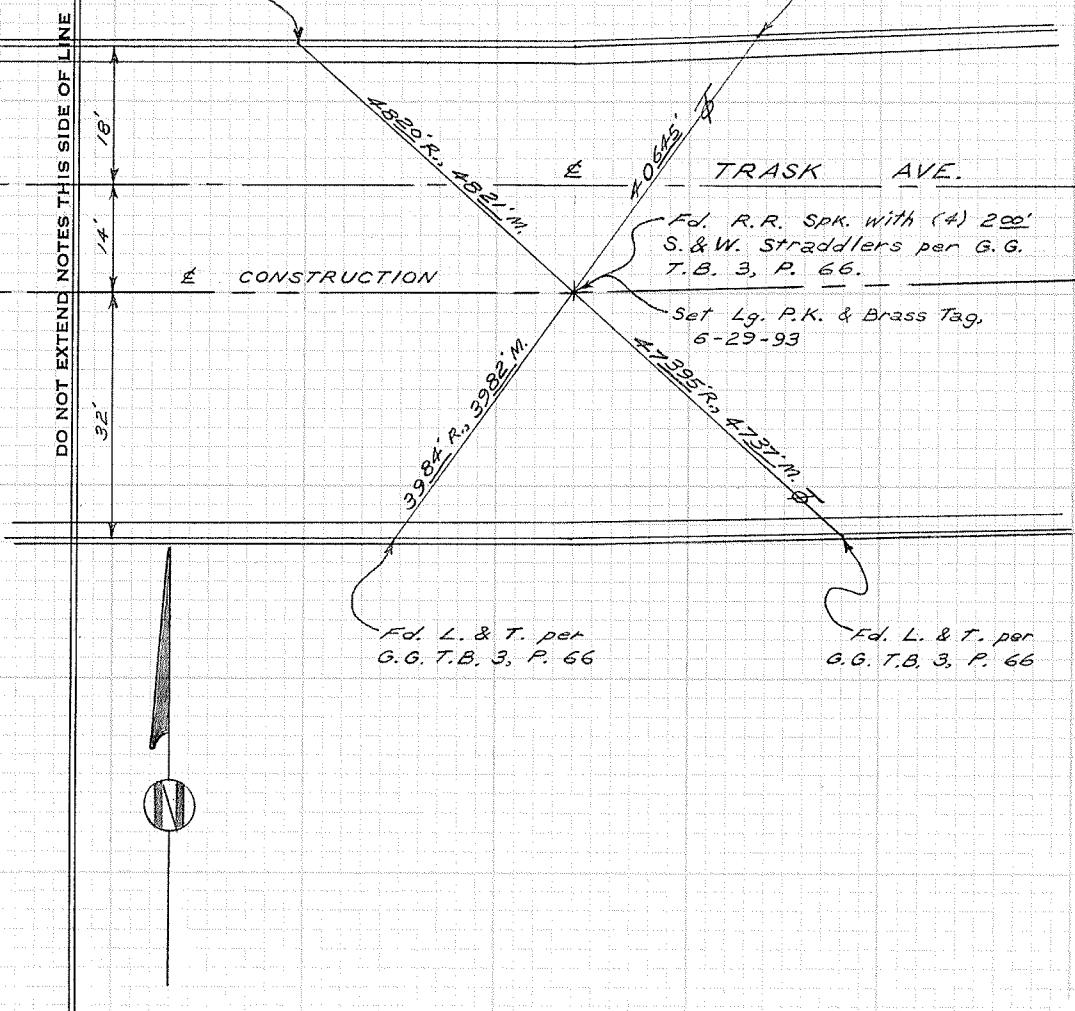

CITY OF GARDEN GROVE, CALIFORNIA

SURVEY OF Trask & Westlake T B NO. 3 PAGE 67
SURVEY BY Prickett & Party TRACT NO.
DATE March 3, 1976


DO NOT EXTEND NOTES THIS SIDE OF LINE

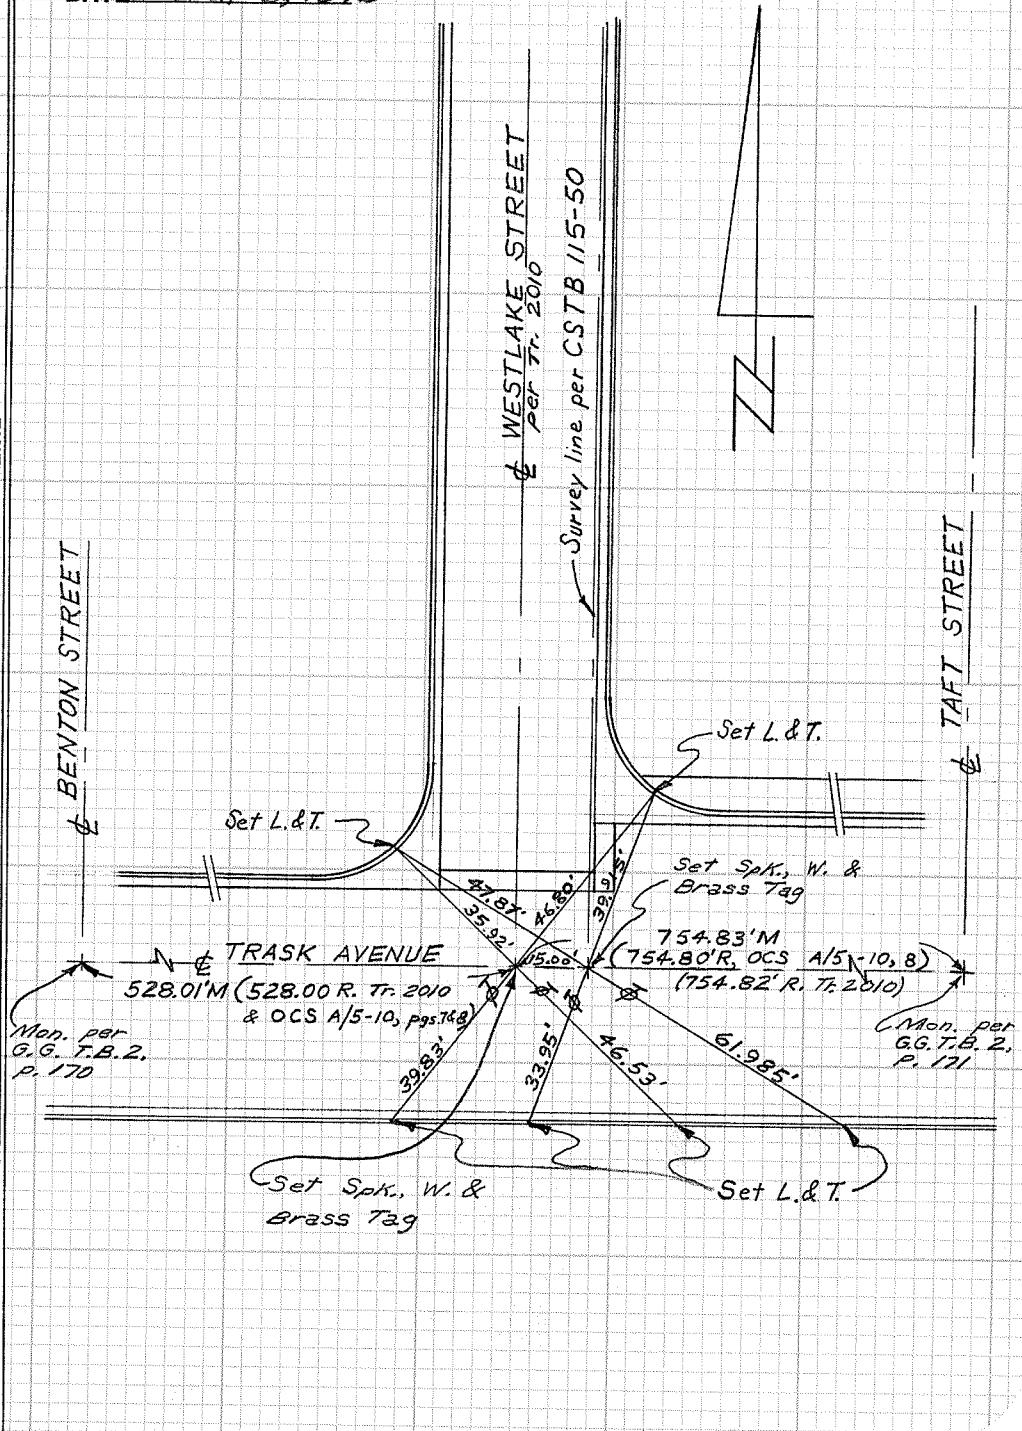

CITY OF GARDEN GROVE, CALIFORNIA

SURVEY OF Westlake & Dorothy TB NO. 3 PAGE 68
SURVEY BY Prickett & Party TRACT NO.
DATE March 4, 1976


DO NOT EXTEND NOTES THIS SIDE OF LINE

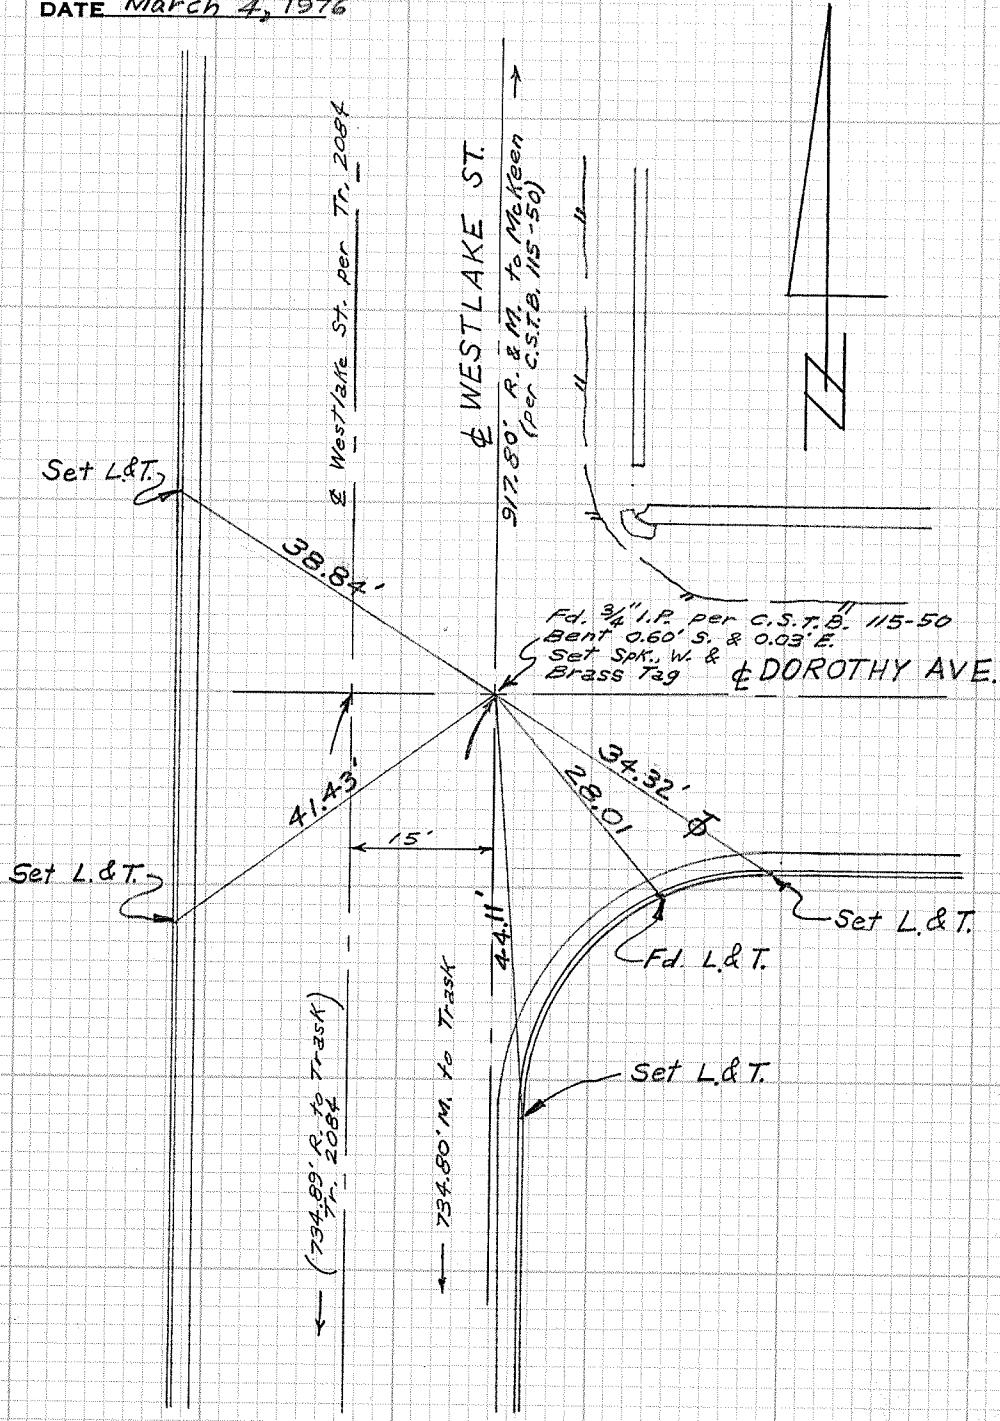

CITY OF GARDEN GROVE, CALIFORNIA

SURVEY OF Westlake & Frances TB NO. 3 PAGE 69
SURVEY BY Prickett & Party TRACT NO.
DATE March 5, 1976

DO NOT EXTEND NOTES THIS SIDE OF LINE

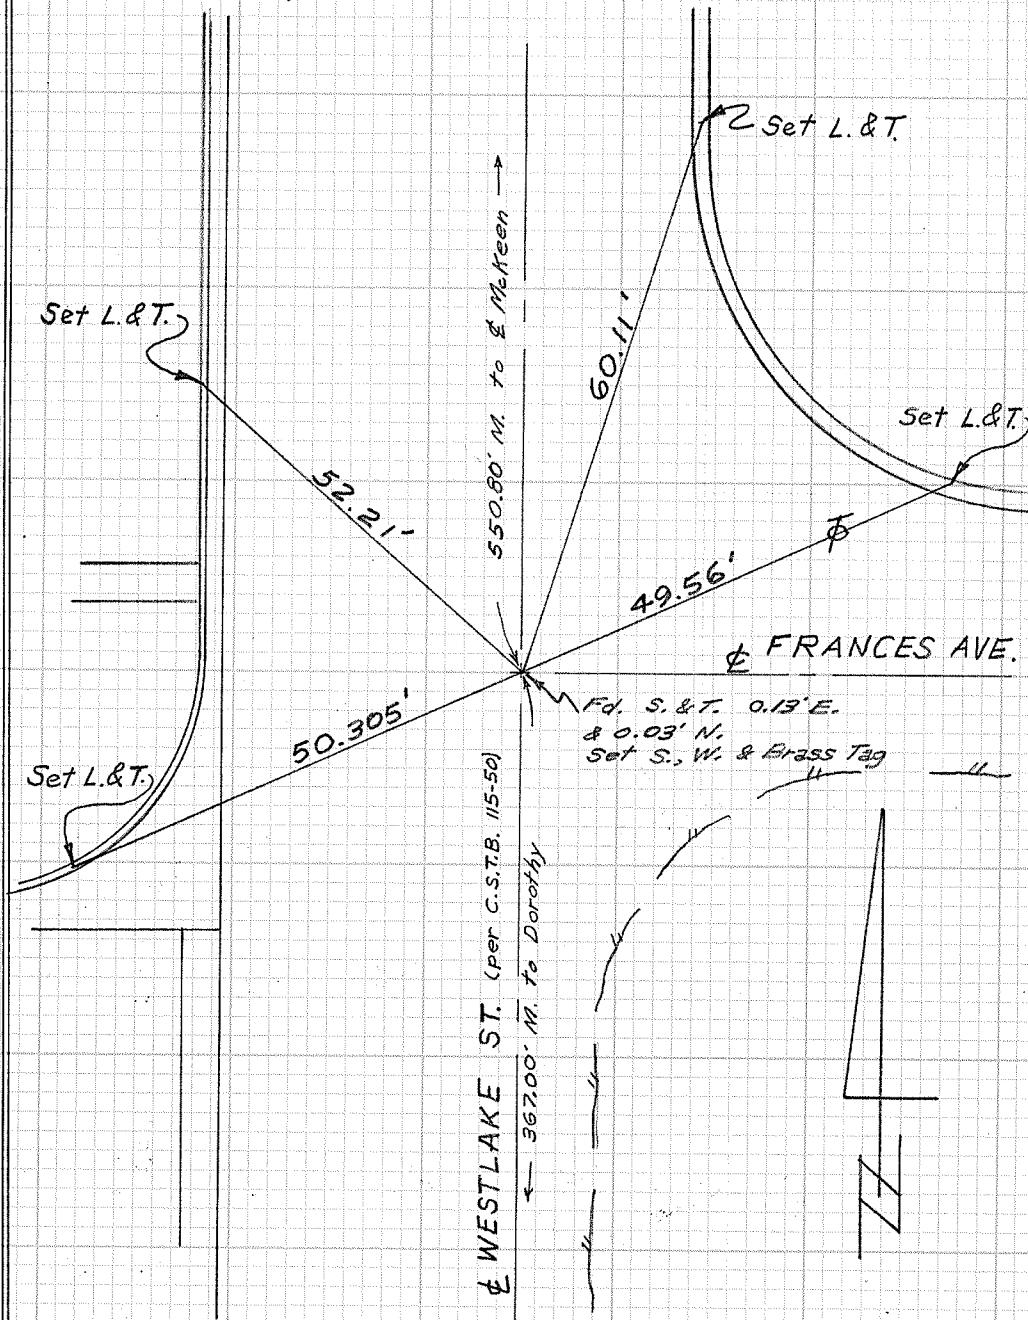


CITY OF GARDEN GROVE, CALIFORNIA

SURVEY OF Westlake & Frances T.B. NO. 3 PAGE 69A
 SURVEY BY Prickett & Party TRACT NO.
 DATE August 14, 1981

STA MESA - STOCK NO. 411

SURVEYORS SERVICE COMPANY


DO NOT EXTEND NOTES THIS SIDE OF LINE

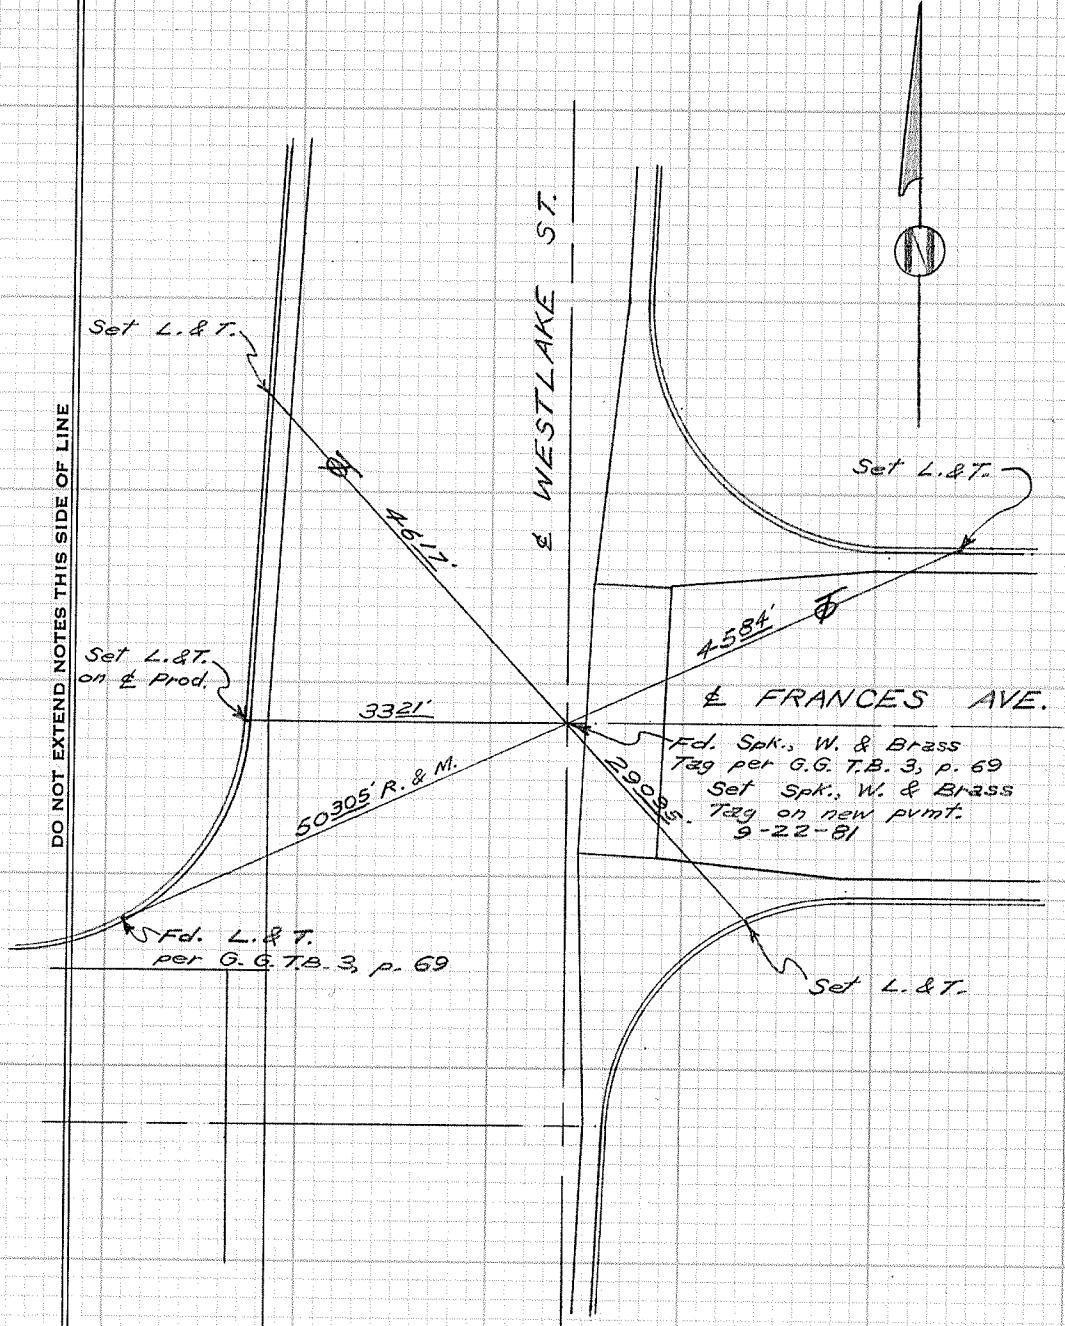

CITY OF GARDEN GROVE, CALIFORNIA

SURVEY OF Westlake & Paloma T B NO. 3 PAGE 70
 SURVEY BY Prickett & Party TRACT NO.
 DATE March 6, 1976

DO NOT EXTEND NOTES THIS SIDE OF LINE

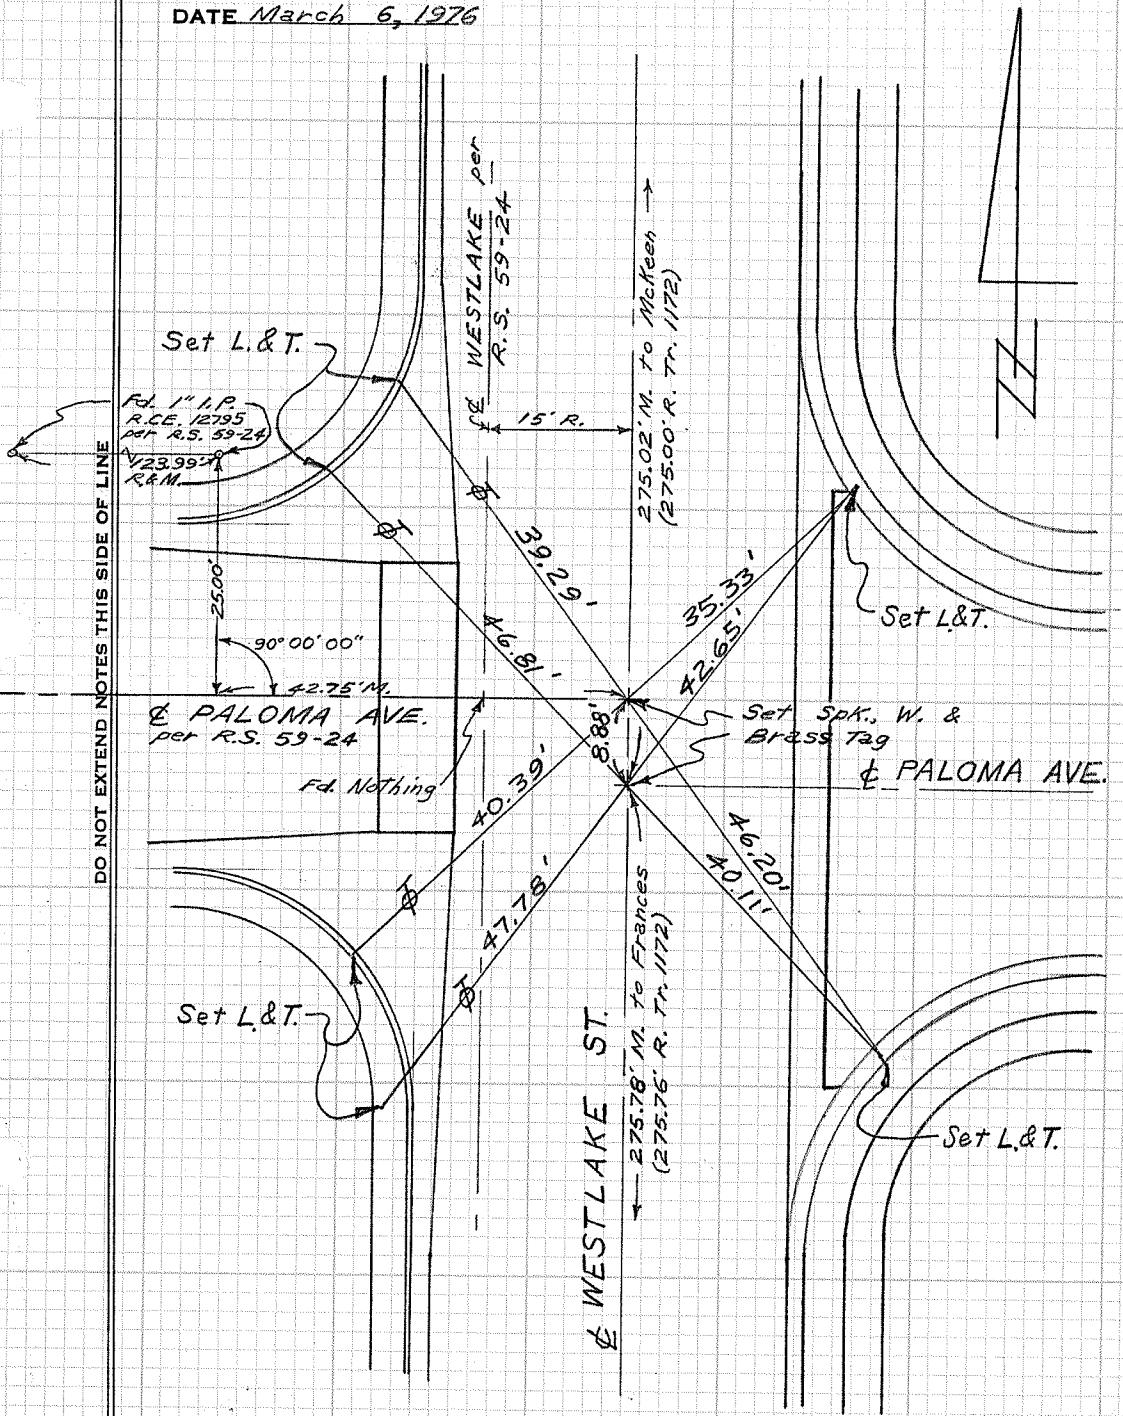


CITY OF GARDEN GROVE, CALIFORNIA

SURVEY OF Westlake & Walnut TB NO. 3 PAGE 71

SURVEY BY Prickett & Party TRACT NO.

DATE March 3, 1976

DO NOT EXTEND NOTES THIS SIDE OF LINE

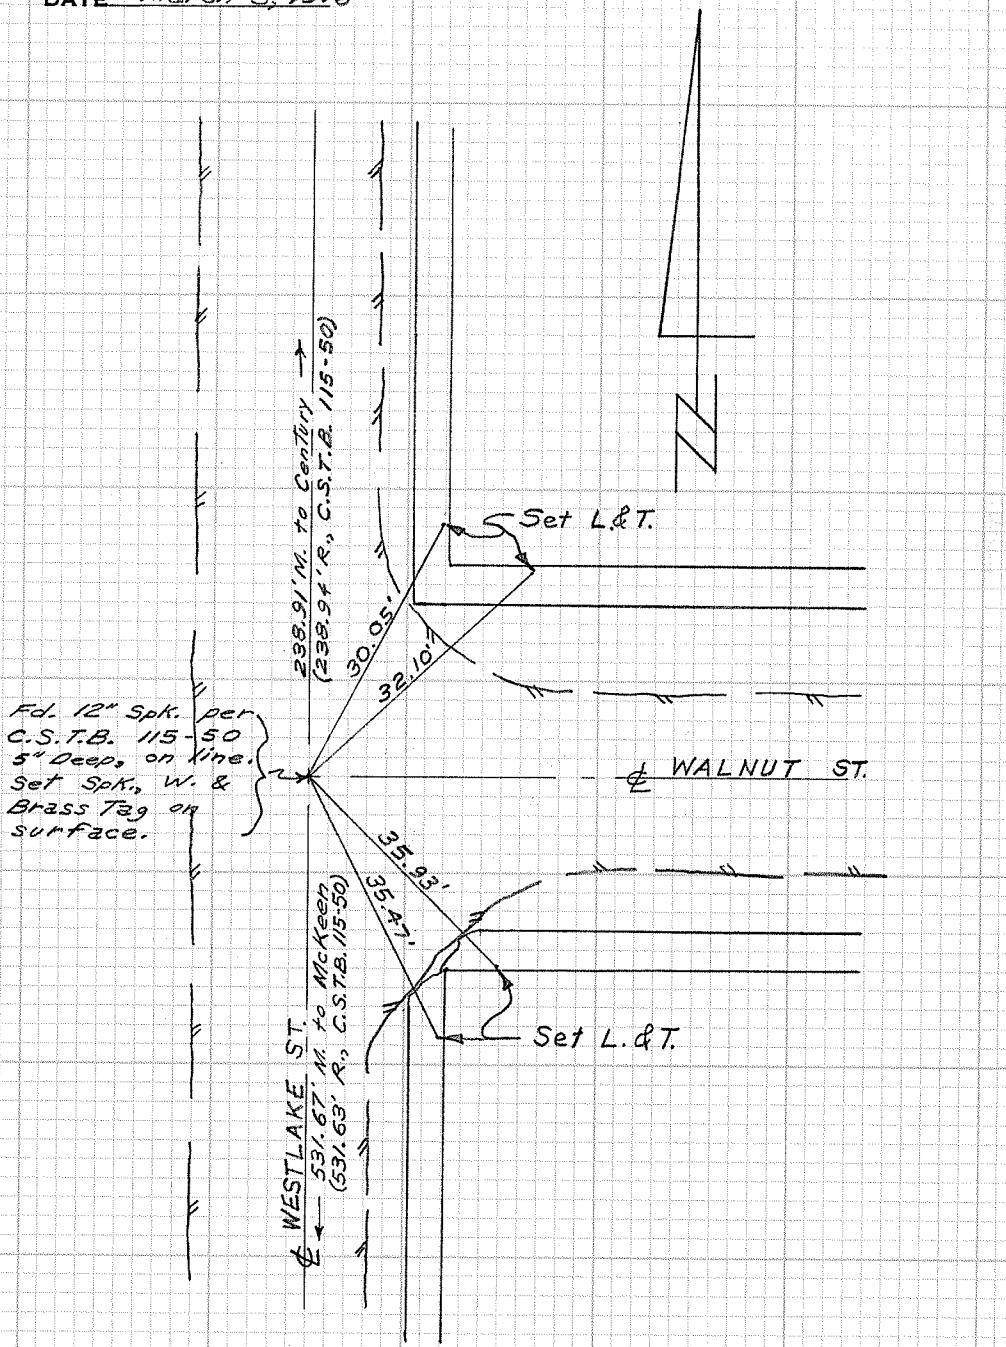


CITY OF GARDEN GROVE, CALIFORNIA

SURVEY OF Westlake & Walnut T.B. NO. 3 PAGE 71A
 SURVEY BY Prickett & Party TRACT NO.
 DATE June 28, 1983

STA MESA - STOCK NO. 411

SURVEYORS SERVICE COMPANY

DO NOT EXTEND NOTES THIS SIDE OF LINE

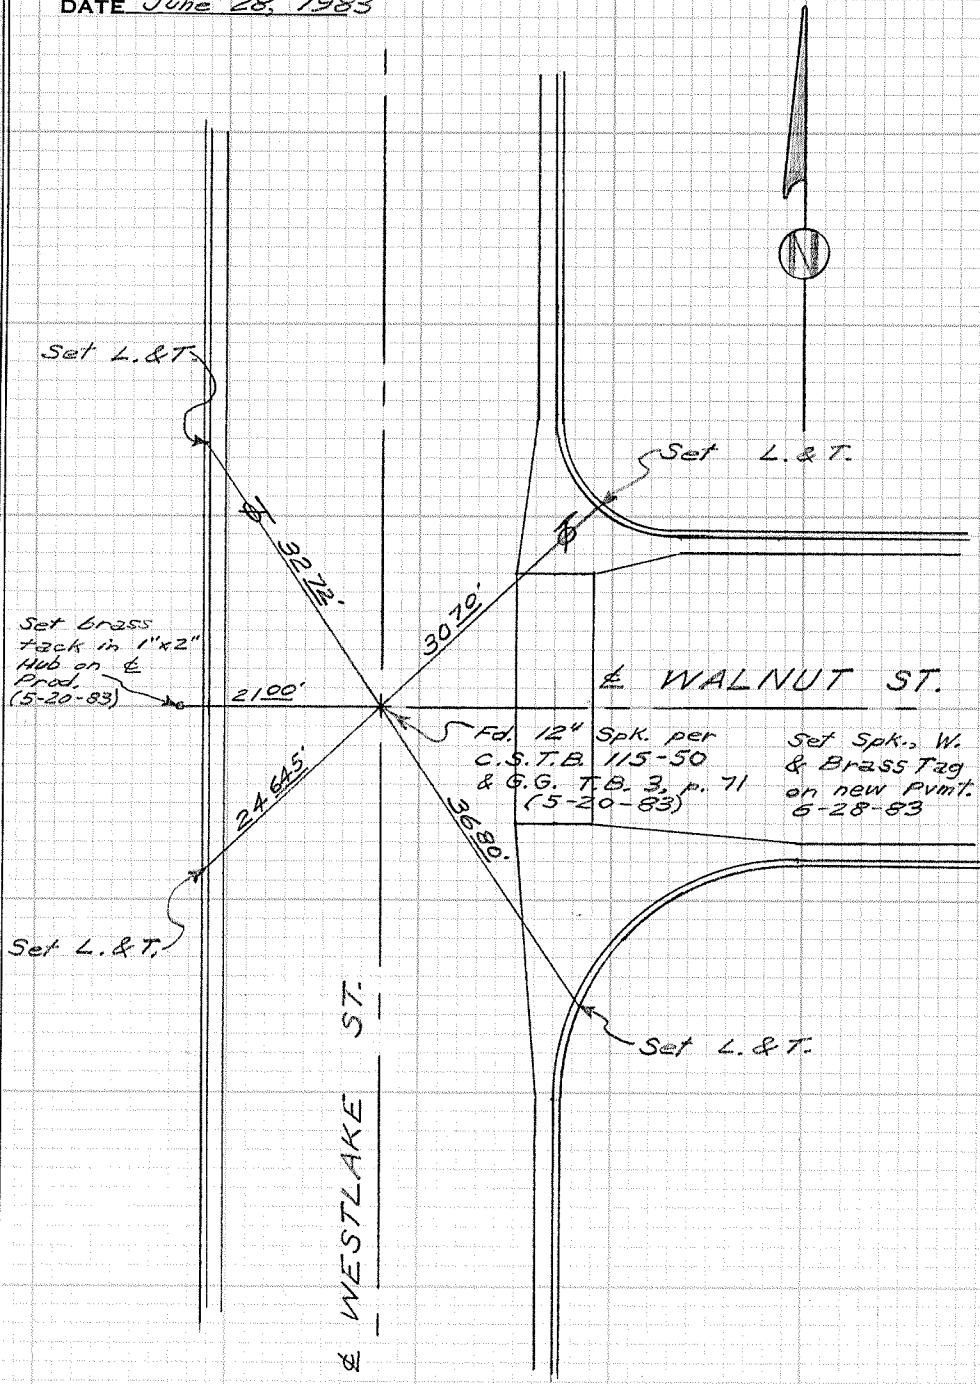


CITY OF GARDEN GROVE, CALIFORNIA

SURVEY OF Woodbury @ B.C., P.R.C. & E.C. T B NO. 3 PAGE 72
SURVEY BY Prickett & Party TRACT NO. 1522
DATE MARCH 26, 1976

SUBSURVEYORS SERVICE COMPANY COSTA MESA - STOCK NO. 41


DO NOT EXTEND NOTES THIS SIDE OF LINE

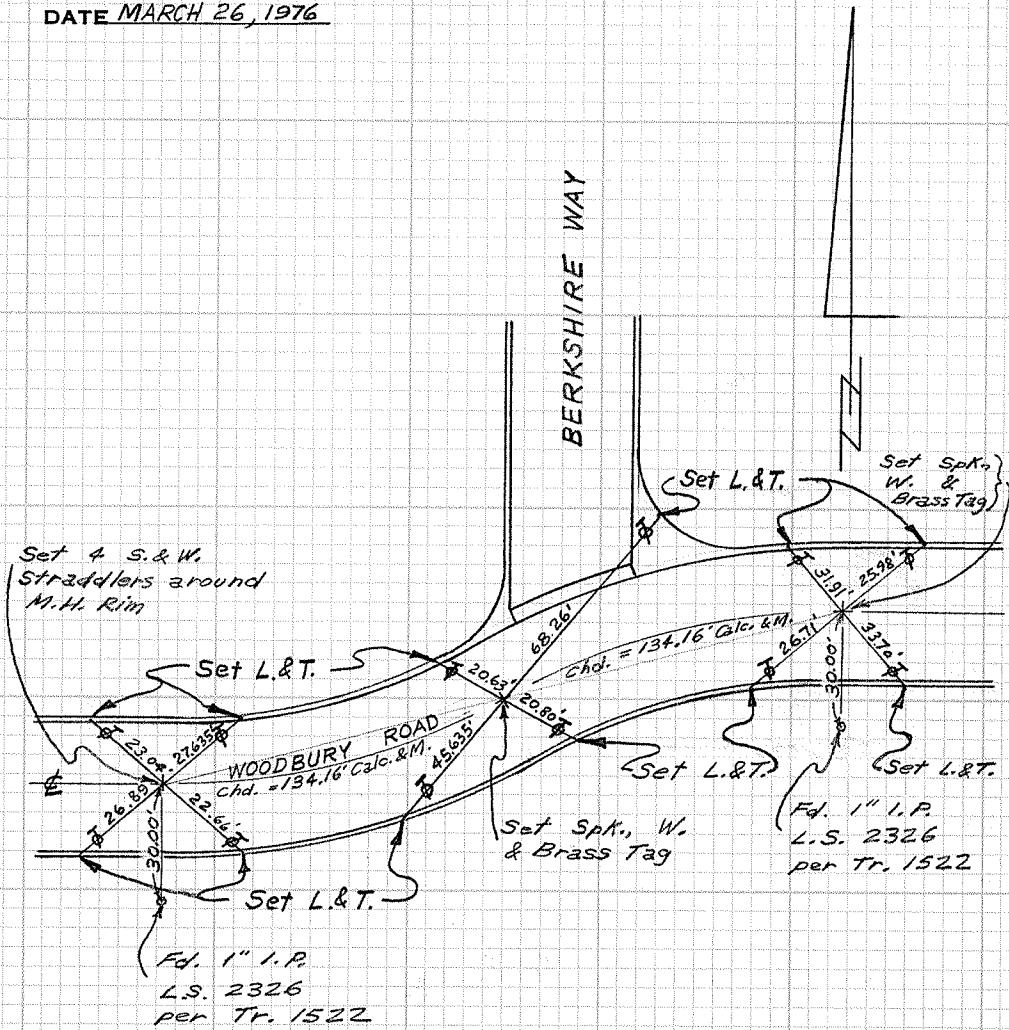

CITY OF GARDEN GROVE, CALIFORNIA

SURVEY OF Lampson & Seventh TB NO. 3 PAGE 23
SURVEY BY Prickett & Party TRACT NO.
DATE MARCH 29, 1976

DO NOT EXTEND NOTES THIS SIDE OF LINE

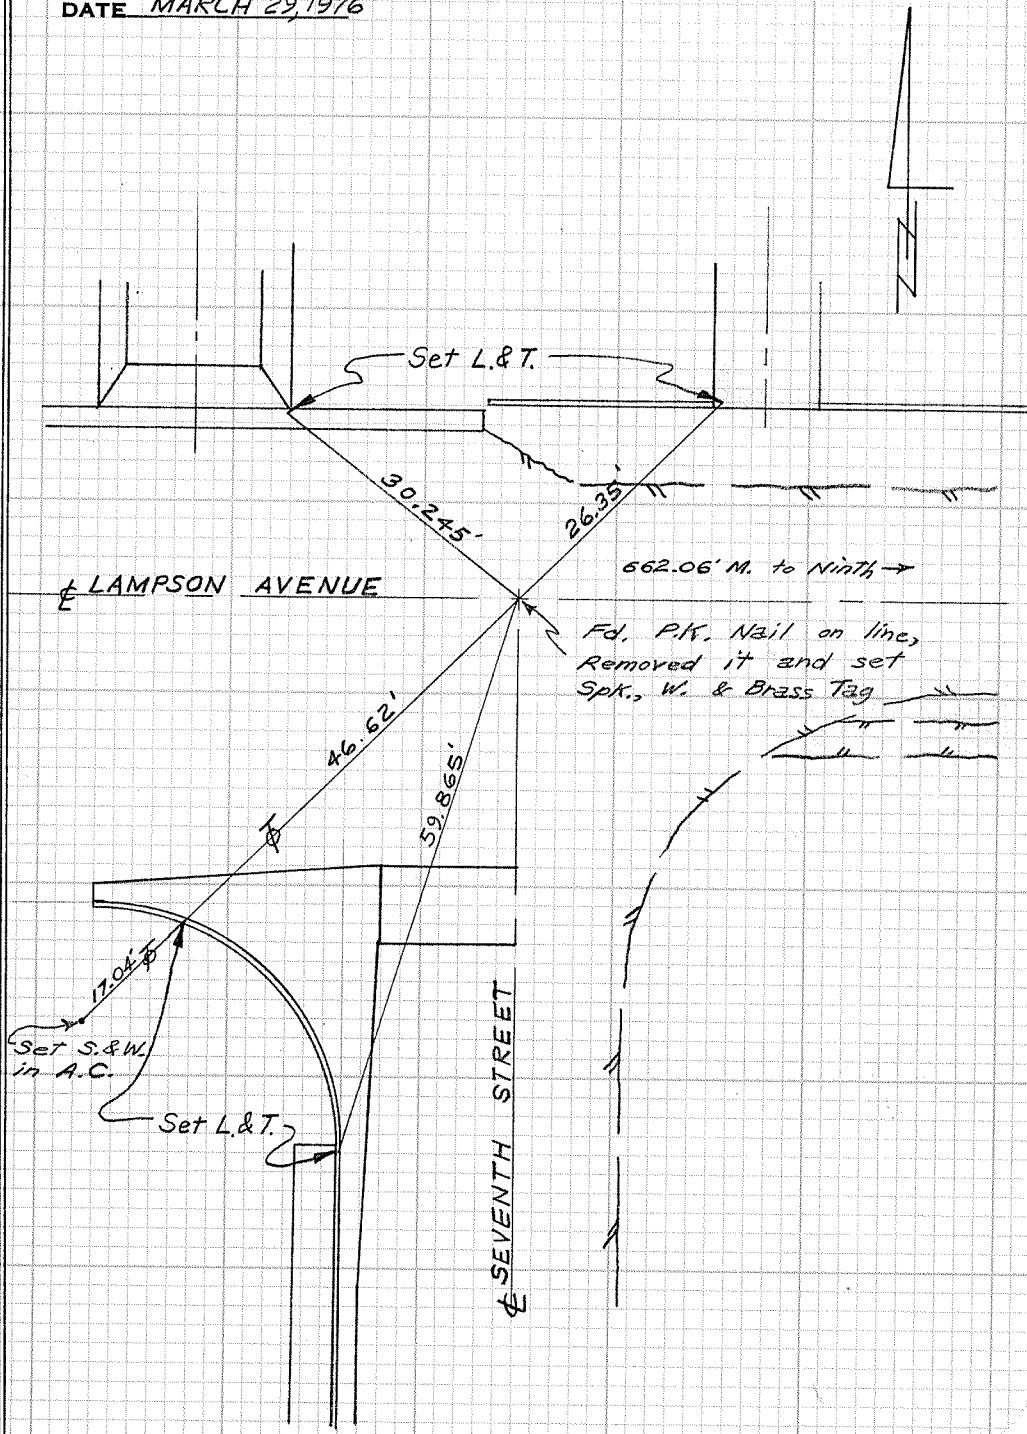

CITY OF GARDEN GROVE, CALIFORNIA

SURVEY OF Lampson & Seventh T. B. NO. 3 PAGE 73A


SURVEY BY Prickett & Party TRACT NO.

DATE April 9, 1980

STA MESA - STOCK NO. 411

SURVEYORS SERVICE COMPANY

DO NOT EXTEND NOTES THIS SIDE OF LINE

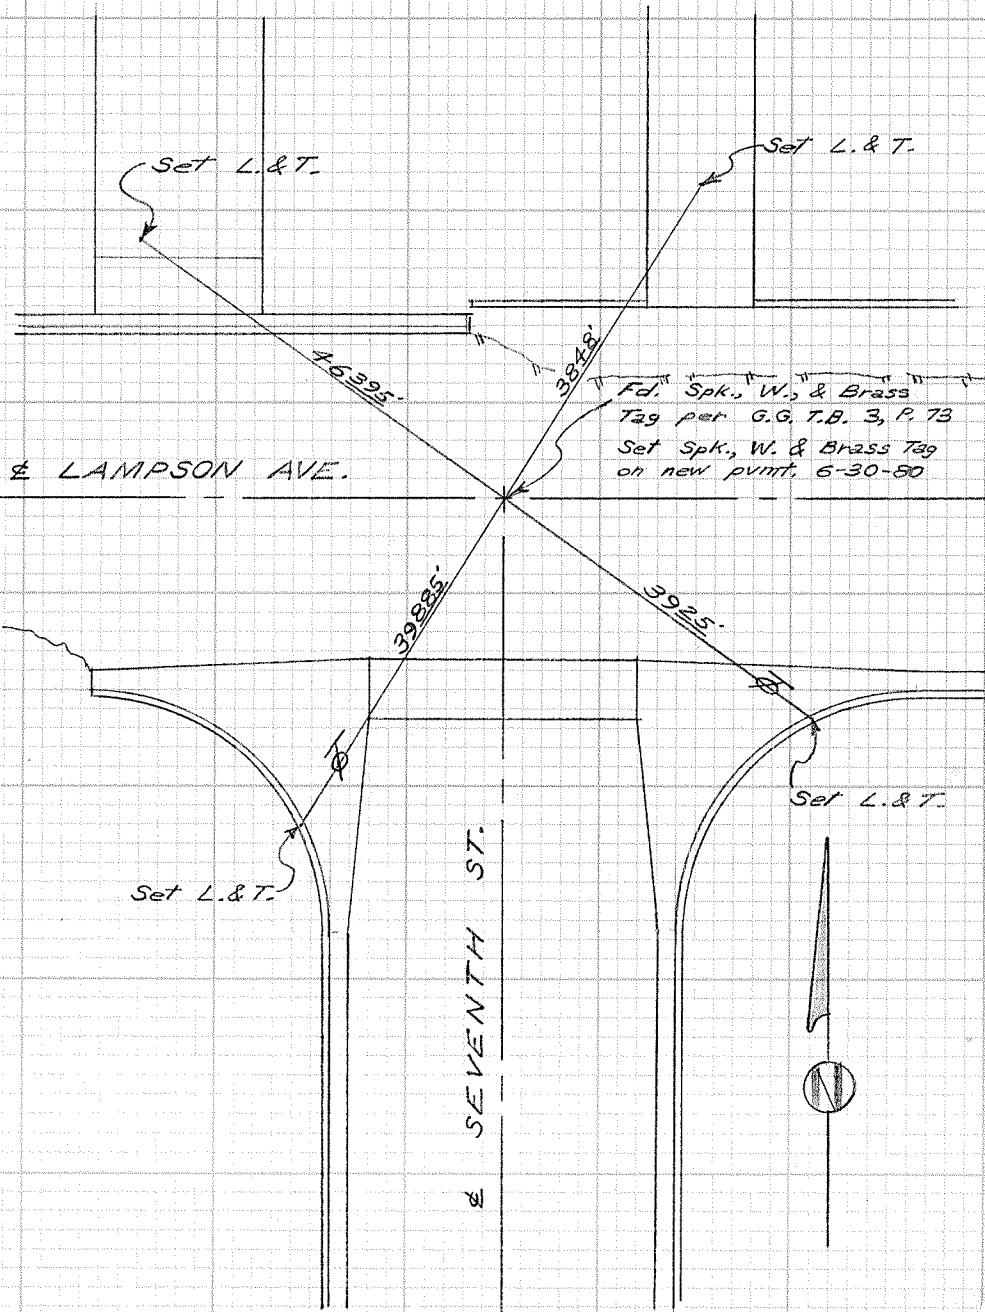

CITY OF GARDEN GROVE, CALIFORNIA

SURVEY OF Brookhurst & 11TH ST. T B NO. 3 PAGE 74

SURVEY BY Prickett & Party TRACT NO.

DATE March 22, 1977

DO NOT EXTEND NOTES THIS SIDE OF LINE

Set L.&T.
11-18-77

NE 11TH ST.

Set L.&T.

Set L.&T.
11-18-77

70.055
60.55'

81.11'

Set Lg. P.K.
& Brass Tag,
5-5-93

E BROOKHURST ST. ↗

Fd. Bolt per
(O.C.S. A/5-10,
P. 361
(Set split, w.)
& Brass tag)
11-18-77
53.91'
59.315' ♂

Set L.&T.
11-18-77


Set Chis.
"+" on S.W.
on E Prod.

Set L.&T.
11-18-77

CITY OF GARDEN GROVE, CALIFORNIA

SURVEY OF BROOKHURST & JENNICH T B NO 3 PAGE 75
SURVEY BY PRICKETT & PARTY TRACT NO 4252
DATE 3-21-77

DO NOT EXTEND NOTES THIS SIDE OF LINE

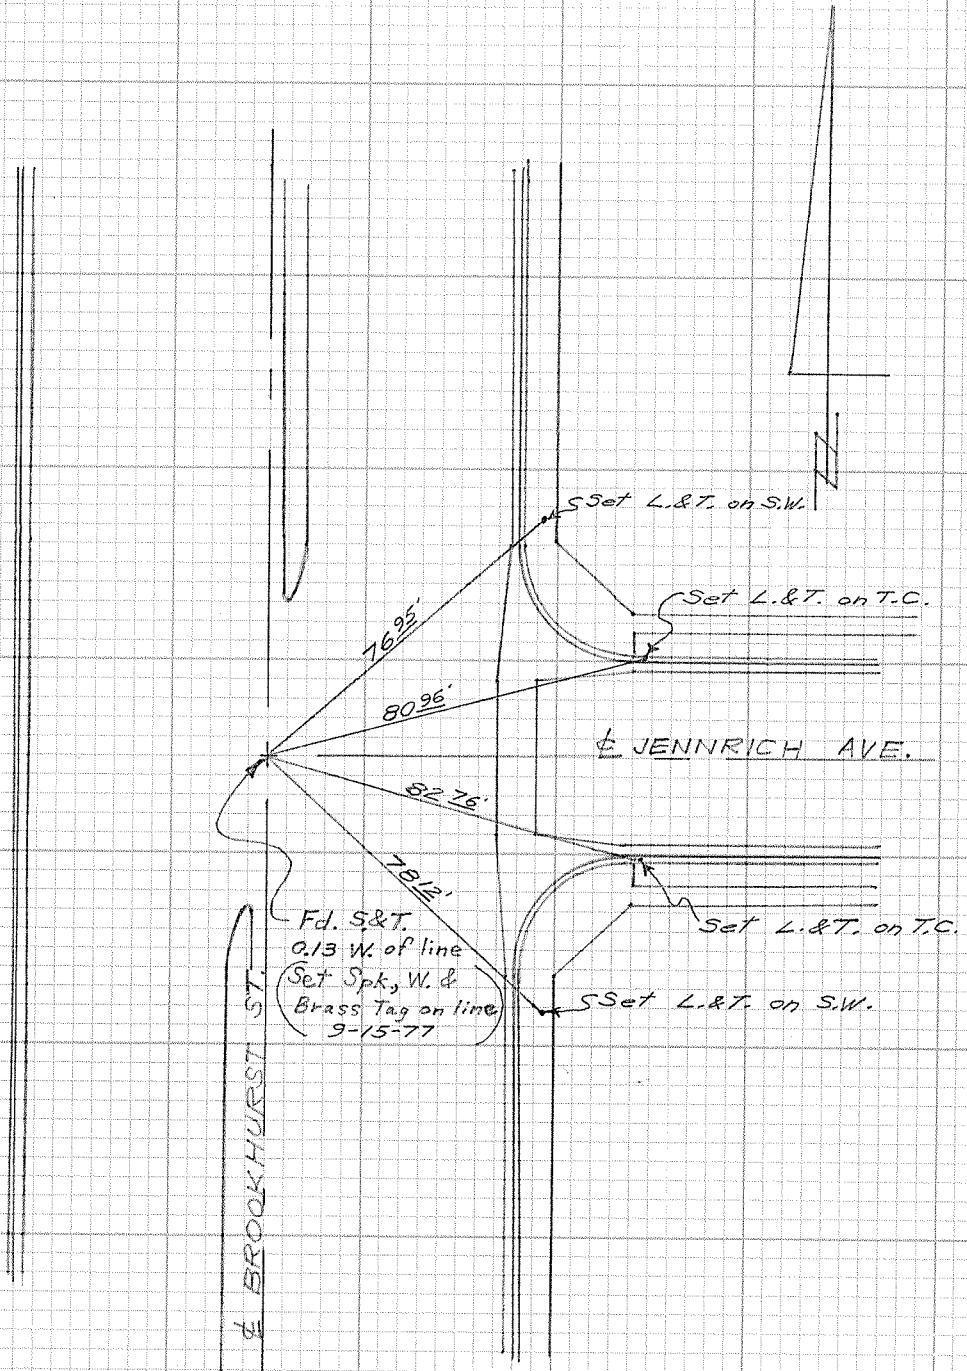


CITY OF GARDEN GROVE, CALIFORNIA

SURVEY OF Brookhurst St. & Jennrich Ave. T.B. NO. 3 PAGE 75A
SURVEY BY Prickett & Party TRACT NO. 4252
DATE March 9, 1993

SURVEYORS SERVICE COMPANY: TA MESA - STOCK NO. 411

DO NOT EXTEND NOTES THIS SIDE OF LINE

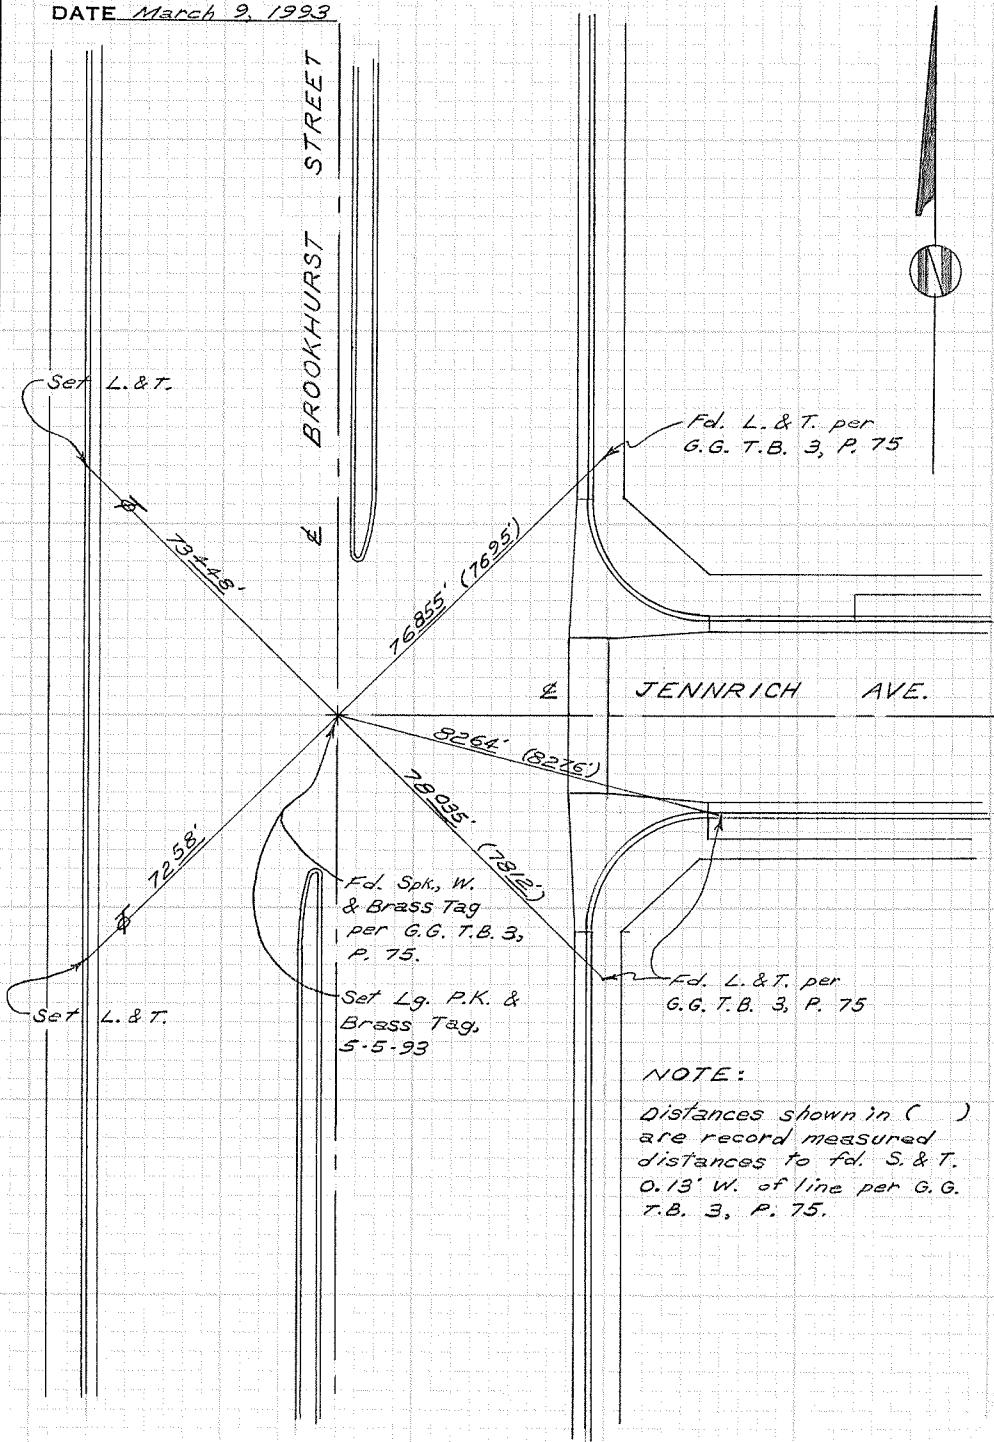

NOTE:

distances shown in ()
are record measured
distances to fd. S. & T.
0.13' W. of line per G.G.
T.B. 3, P. 75.


CITY OF GARDEN GROVE, CALIFORNIA

SURVEY OF Brookhurst St. & 13th St. T B NO. 3 PAGE 76

SURVEY BY Prickett & Party **TRACT NO.**

DATE March 21, 1977


DO NOT EXTEND NOTES THIS SIDE OF LINE

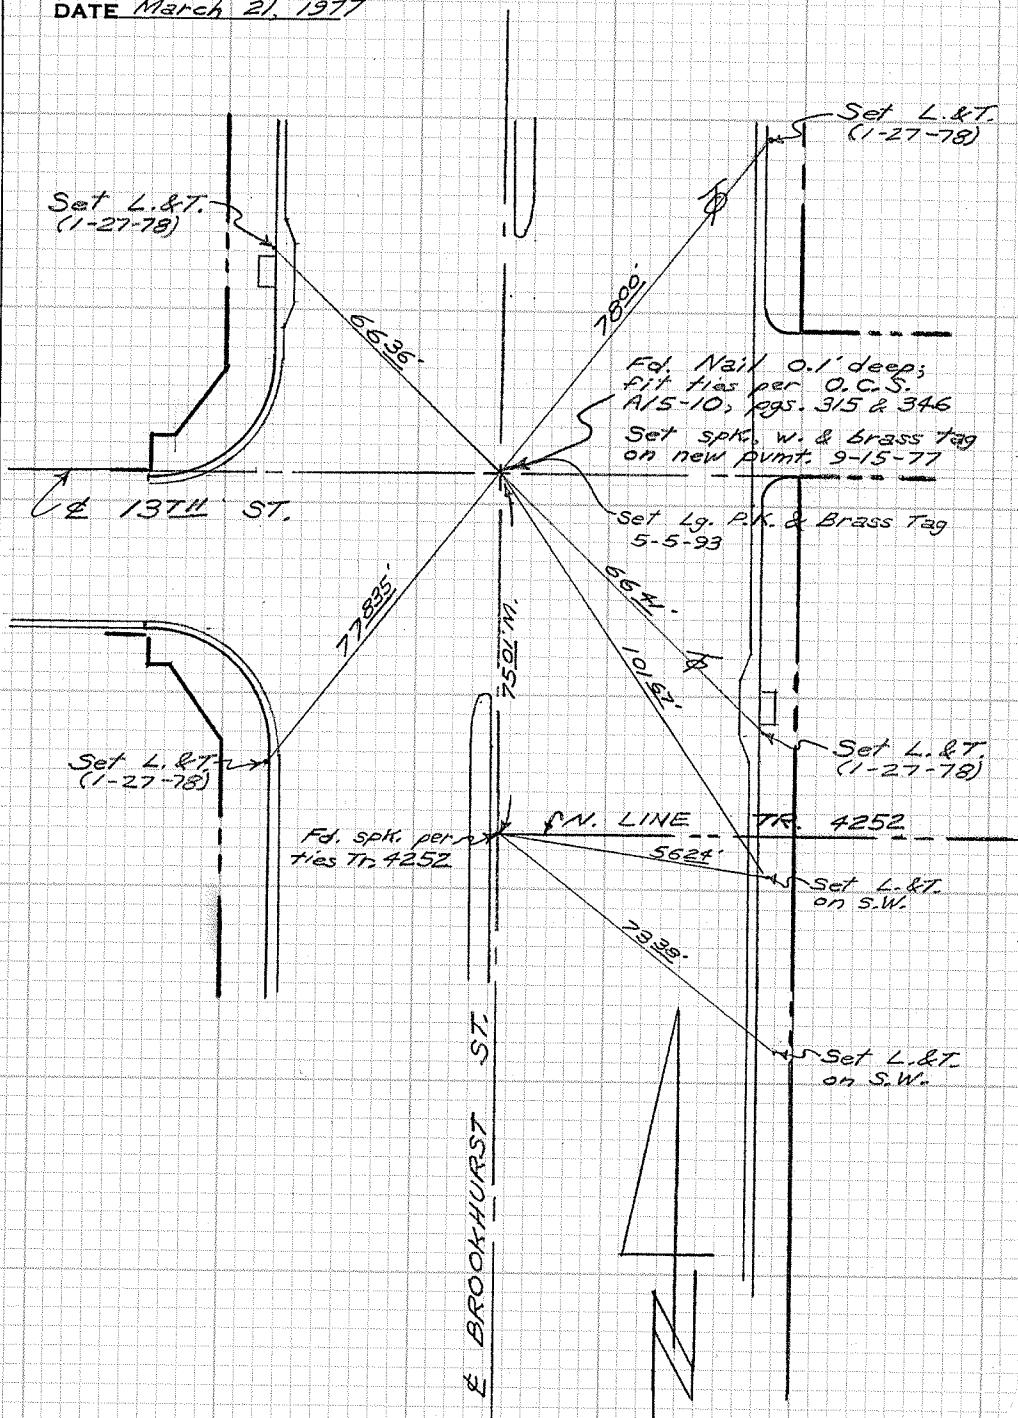

CITY OF GARDEN GROVE, CALIFORNIA

SURVEY OF Brookhurst & Reading TB NO. 3 PAGE 77
SURVEY BY Prickett & Party TRACT NO.
DATE March 22, 1977

DO NOT EXTEND NOTES THIS SIDE OF LINE

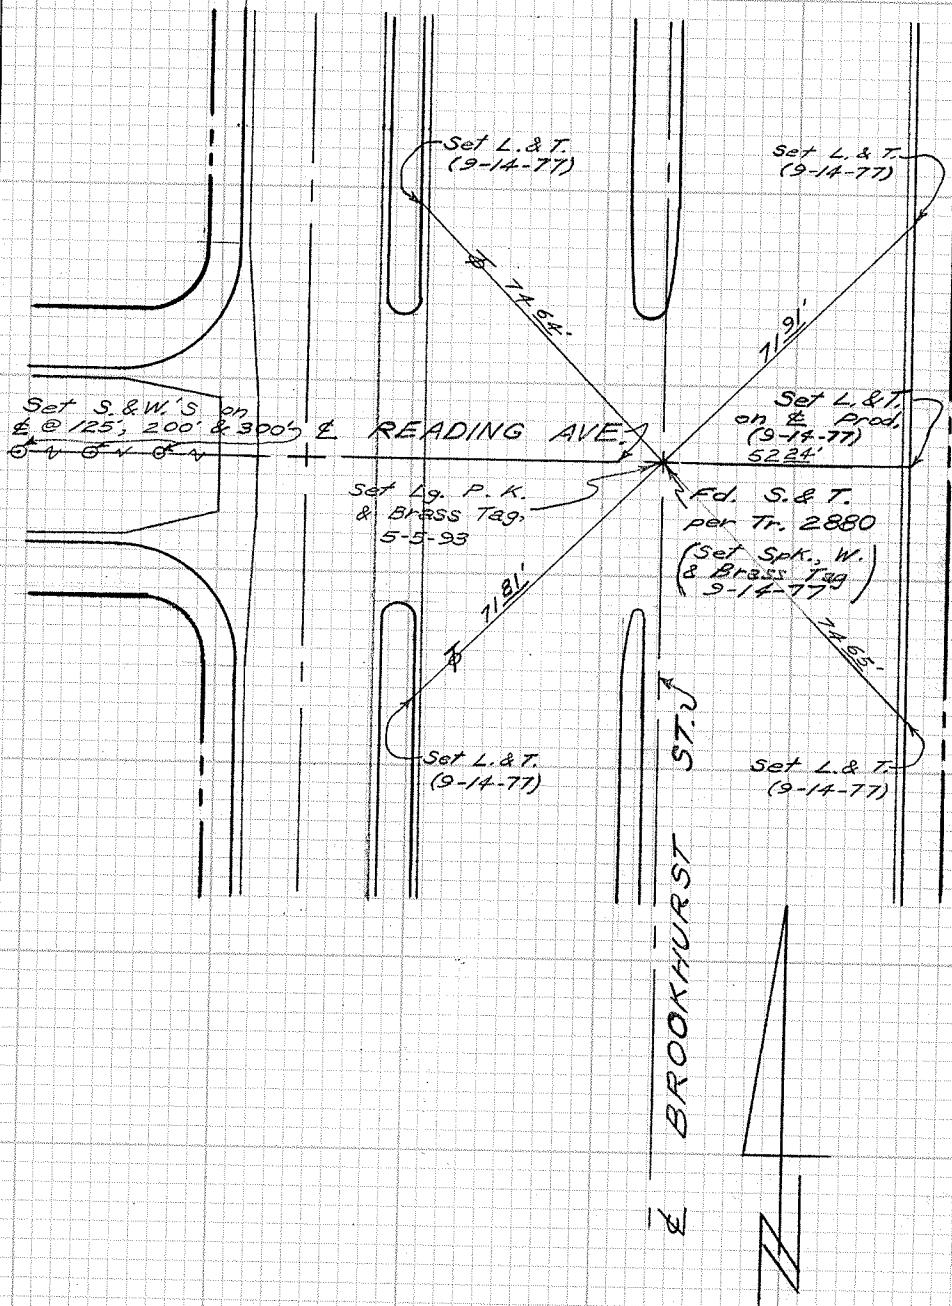


CITY OF GARDEN GROVE, CALIFORNIA

SURVEY OF Brookhurst & 15TH ST. TB NO. 3 PAGE 78
SURVEY BY Prickett & Party TRACT NO.
DATE March 21, 1977

SURVEYORS SERVICE COMPANY
COSTA MESA - STOCK NO. 411

DO NOT EXTEND NOTES THIS SIDE OF LINE

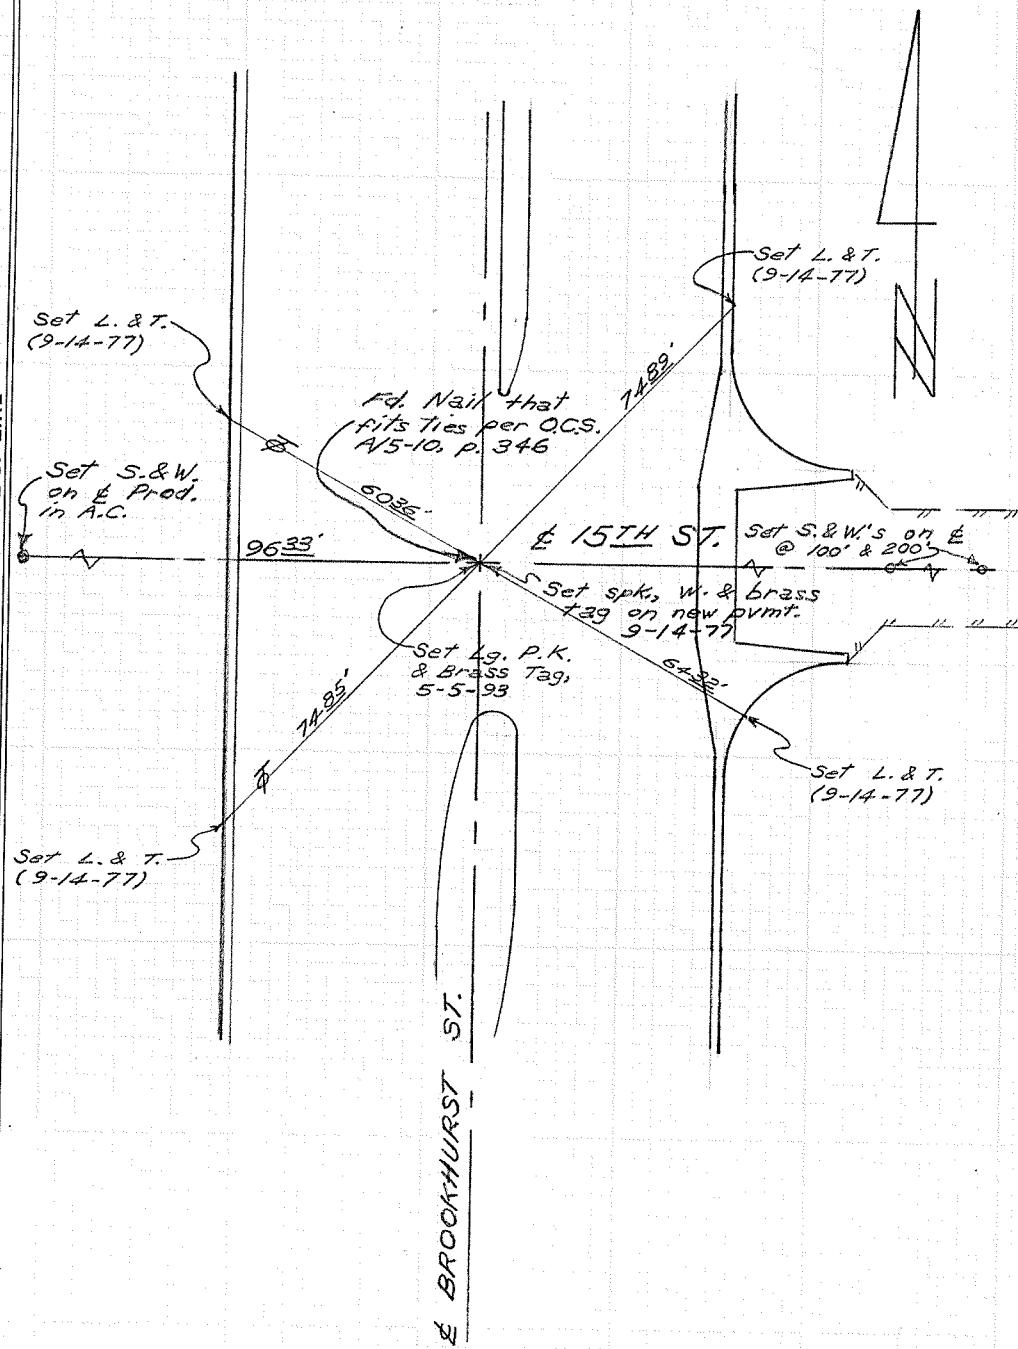

CITY OF GARDEN GROVE, CALIFORNIA

Brookhurst St. & Angie Pt.
 SURVEY OF 350 ft. North of Chapman T.B. NO. 3 PAGE 79
 SURVEY BY Prickett & Party TRACT NO.
 DATE May 7, 1976

STA MESA - STOCK NO. 411

SURVEYORS SERVICE COMPANY

DO NOT EXTEND NOTES THIS SIDE OF LINE

Set S. & W.
in A.C.
Set L. & T.
10-21-77

6200'
5225'
90° 00' 00"

E BROOKHURST ST. P
CONSTRUCTION E

Set S. & W.
Set City of G.G.
Std. well Monument
9-15-77

3500'

Fd. City of G.G.
Std. well Mon. per
G.G. T.B. I, p. 45

E CHAPMAN AVE.

N

CITY OF GARDEN GROVE, CALIFORNIA

SURVEY OF Brookhurst St. & Melody Park Dr. T. B. NO. 3 PAGE 80


SURVEY BY Prickett & Party TRACT NO.

DATE JULY 6, 1977

STA MESA - STOCK NO. 411

SURVEYORS SERVICE COMPANY

DO NOT EXTEND NOTES THIS SIDE OF LINE

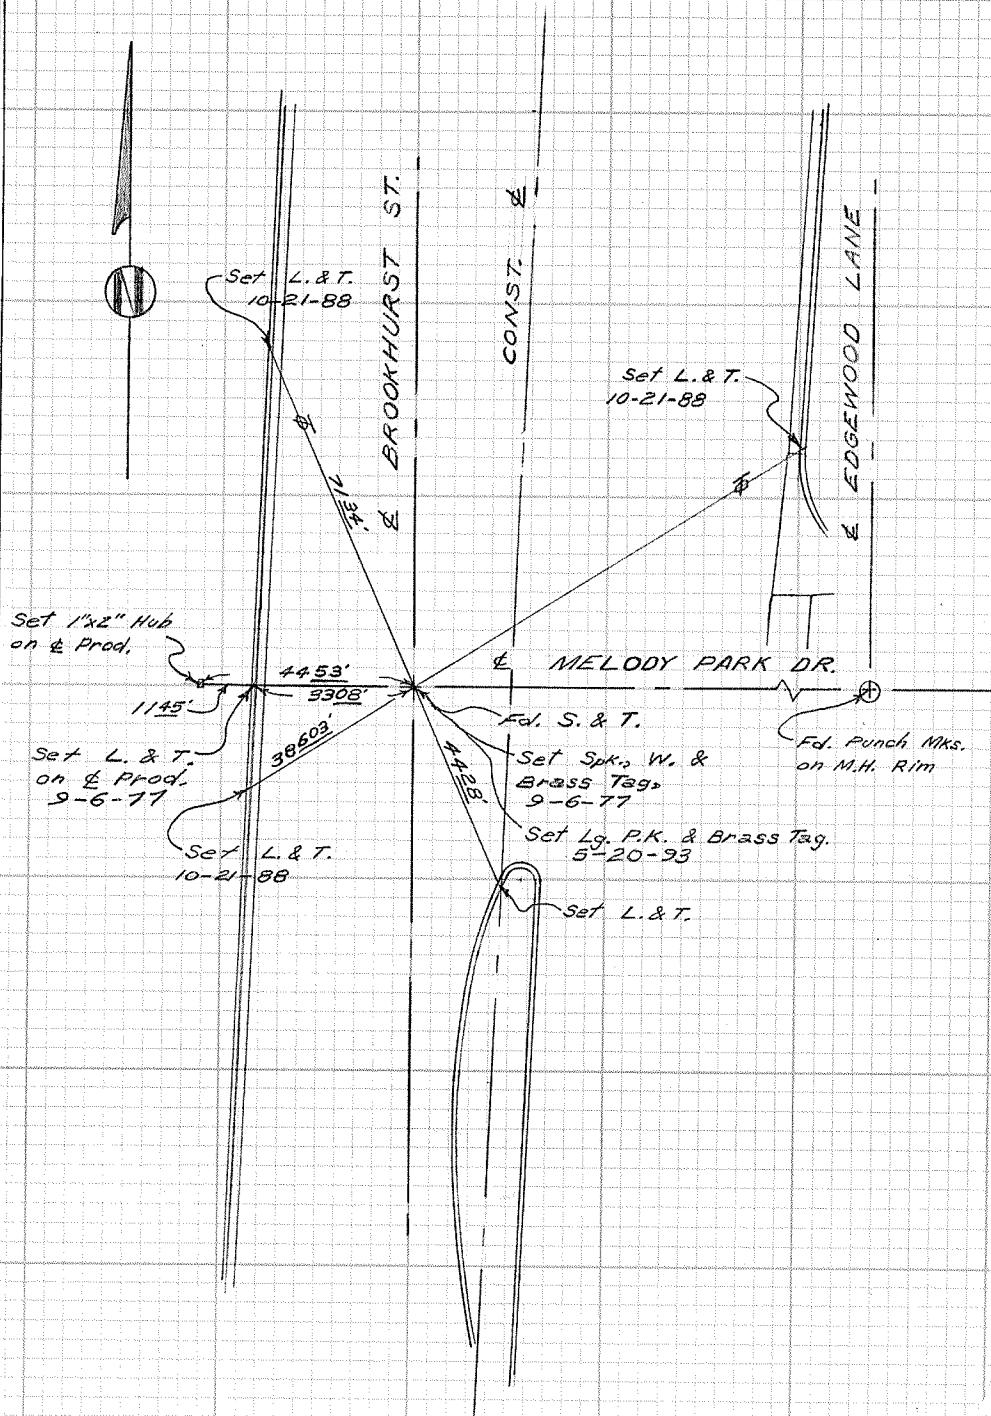


CITY OF GARDEN GROVE, CALIFORNIA

SURVEY OF Brookhurst & Hummingbird T.B. NO. 3 PAGE 81
 SURVEY BY Prickett & Party TRACT NO. 1798
 DATE June 7, 1977

SURVEYORS SERVICE COMPANY STA MESA - STOCK NO. 411

DO NOT EXTEND NOTES THIS SIDE OF LINE

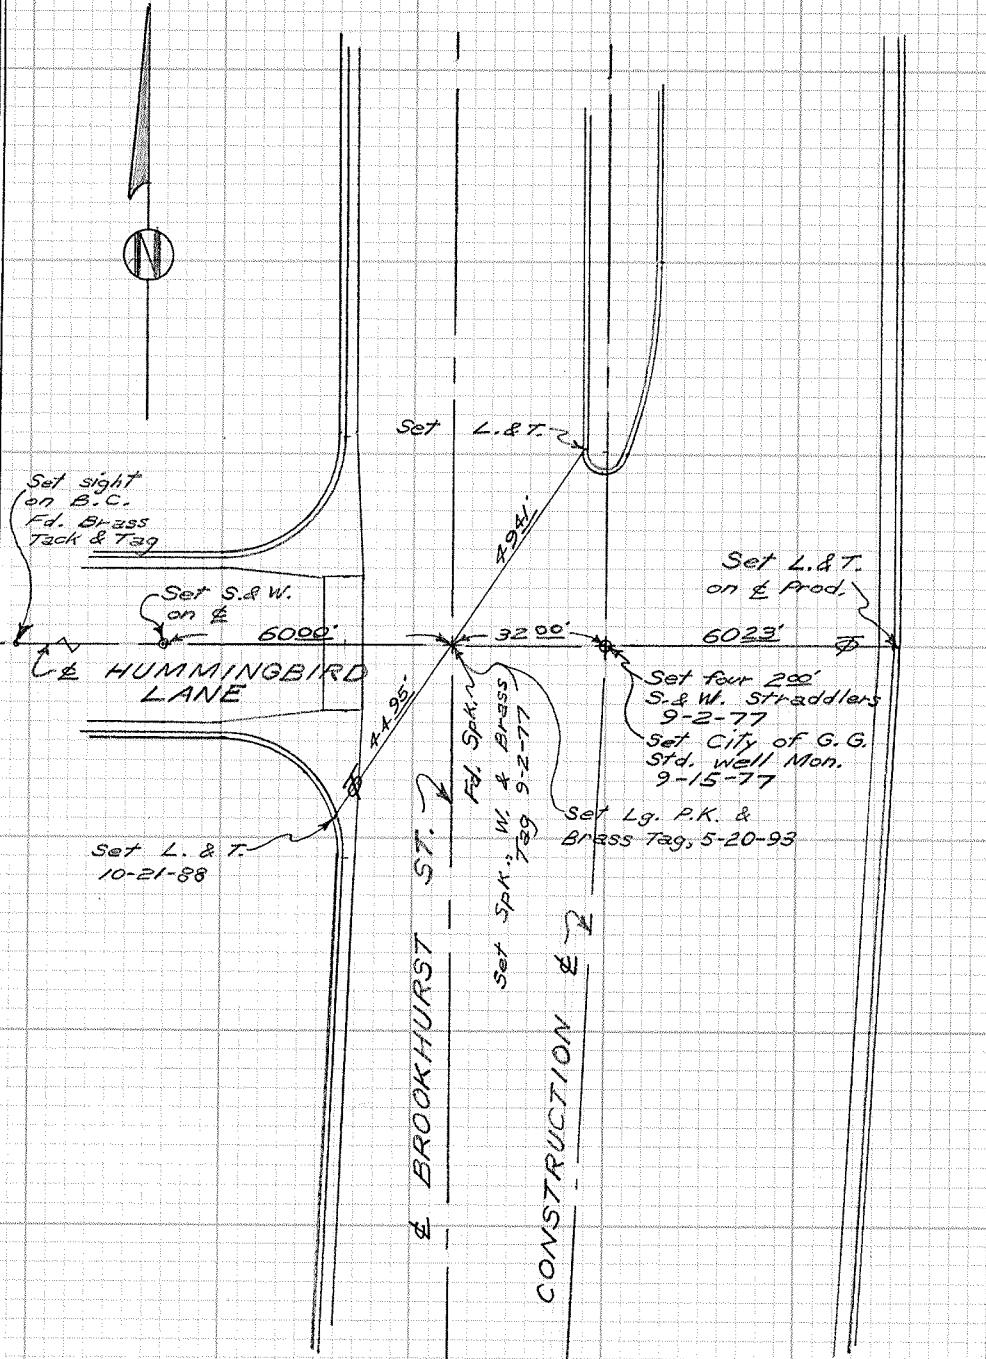


& FLAMINGO DR.

M. Nails & Copper Tag, RE 7/91

DO NOT EXTEND NOTES THIS SIDE OF LINE

CITY OF GARDEN GROVE, CALIFORNIA
 Brookhurst St. @ Skylark Ln.
 SURVEY OF & McMichael — Roselee Dr. T B NO. 3 PAGE 82
 SURVEY BY Prickett & Party TRACT NO.
 DATE July 1, 1977

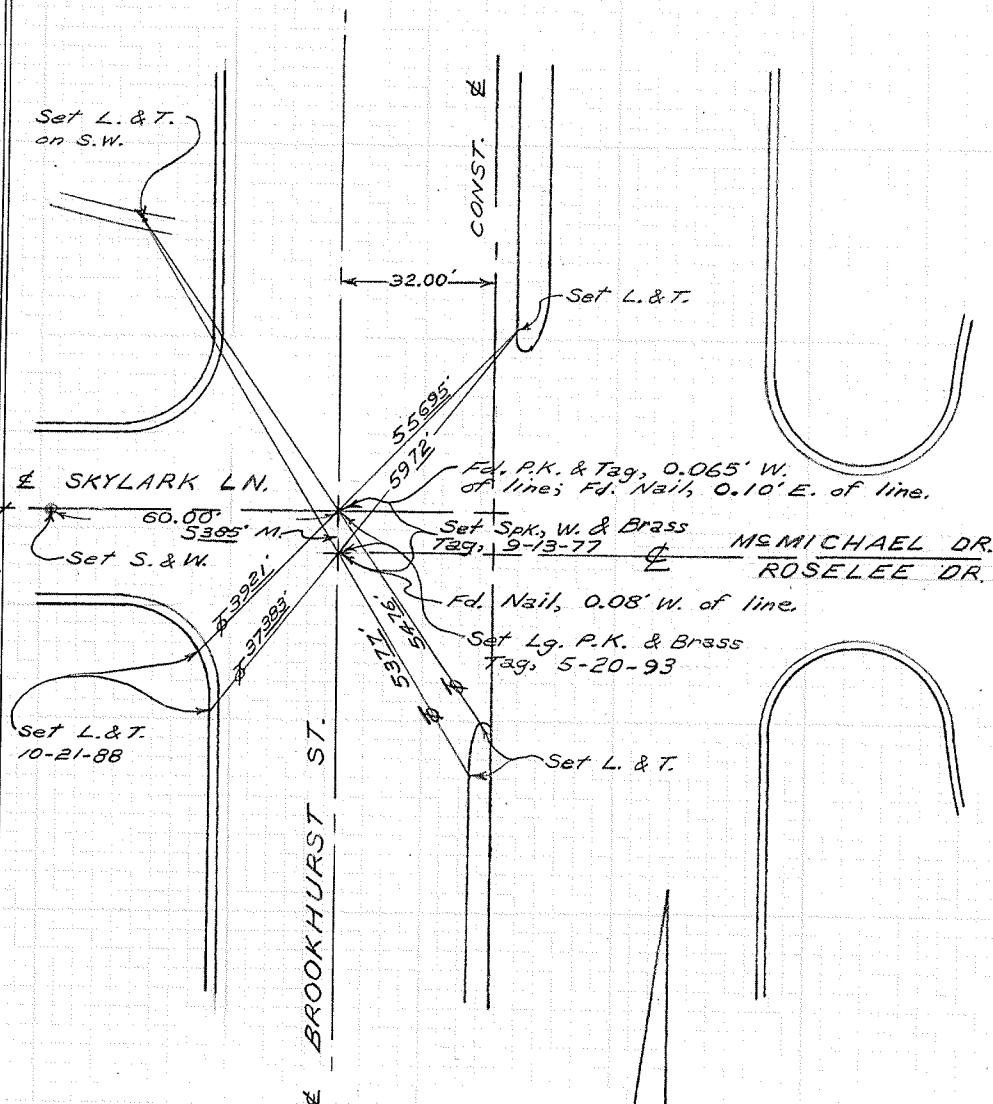


CITY OF GARDEN GROVE, CALIFORNIA

SURVEY OF Brookhurst St. & Hill Rd. T.B. NO. 3 PAGE 83
SURVEY BY Pritchett & Party TRACT NO.
DATE June 25, 1977

SURVEYORS SERVICE COMPANY - STA MESA - STOCK NO. 411

DO NOT EXTEND NOTES THIS SIDE OF LINE

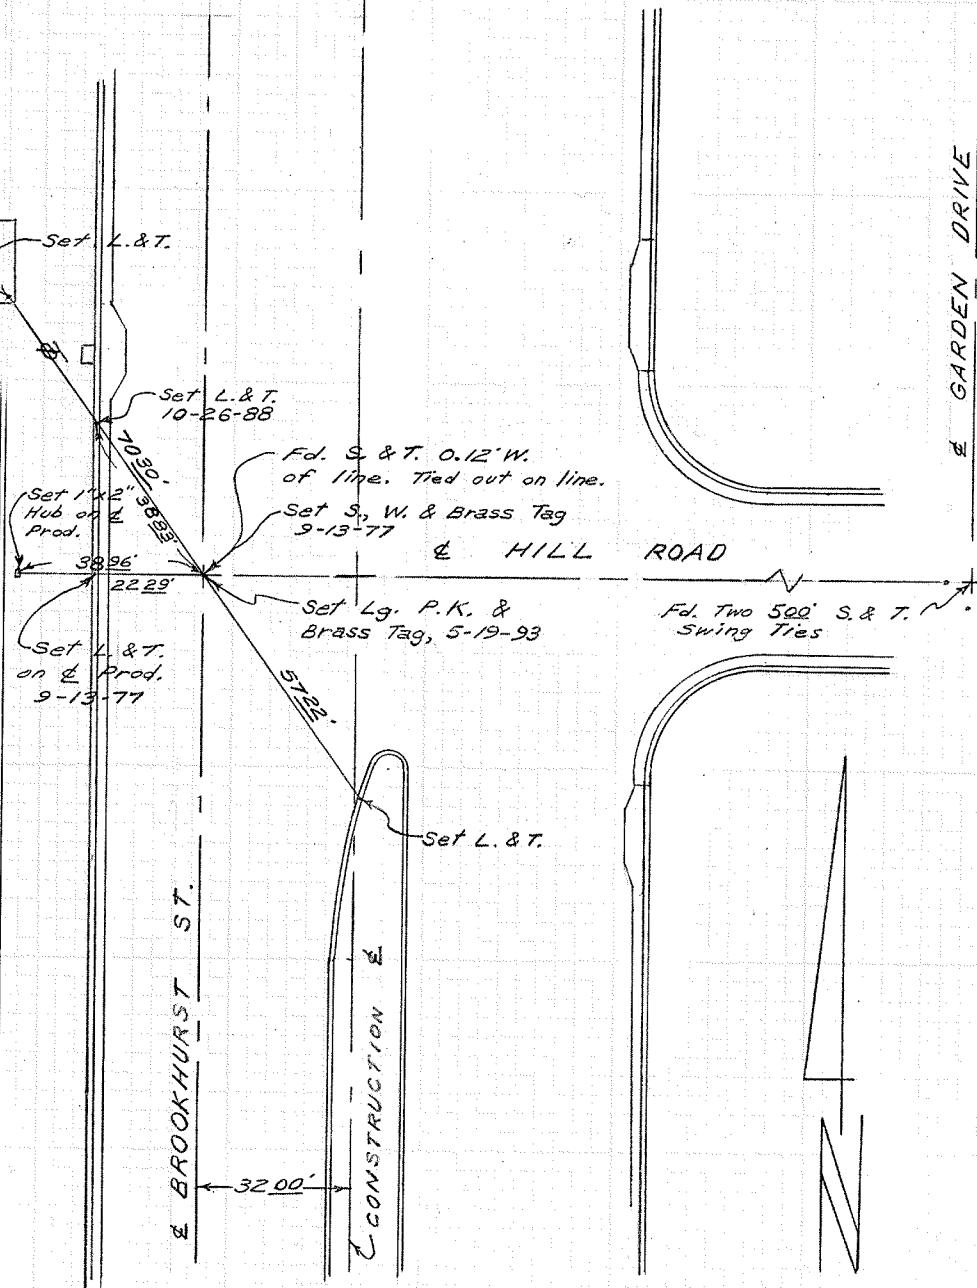

CITY OF GARDEN GROVE, CALIFORNIA

SURVEY OF Brookhurst St. & Royal Palm Blvd. T B NO. 3 PAGE 84
SURVEY BY Prickett & Party TRACT NO.
DATE JULY 1, 1977

11

SURVEYORS SERVICE COMPANY

OSTA MESA - STOCK NO. 411

E LEONHARDT CIRCLE

Fd. Chs. Atts: on M.H. Rim

DO NOT EXTEND NOTES THIS SIDE OF LINE

Set L. & T.
10-20-88

Set S. & W. on E
75.00'

E ROYAL PALM BLVD.

Set L. & T.
6-25-77

E BROOKHURST ST.

Set L. & T.
10-20-88

Set Lg. P.K. &
Brass Tag,
5-9-93

Fd. Nail 0.05' E. of
line. Tied out on line.

Set Spk. W. & Brass Tag, 9-19-77
9250'

Set L. & T.
on E Prod.

1859'


1859'

1859'

1859'

CONSTRUCTION

3200'

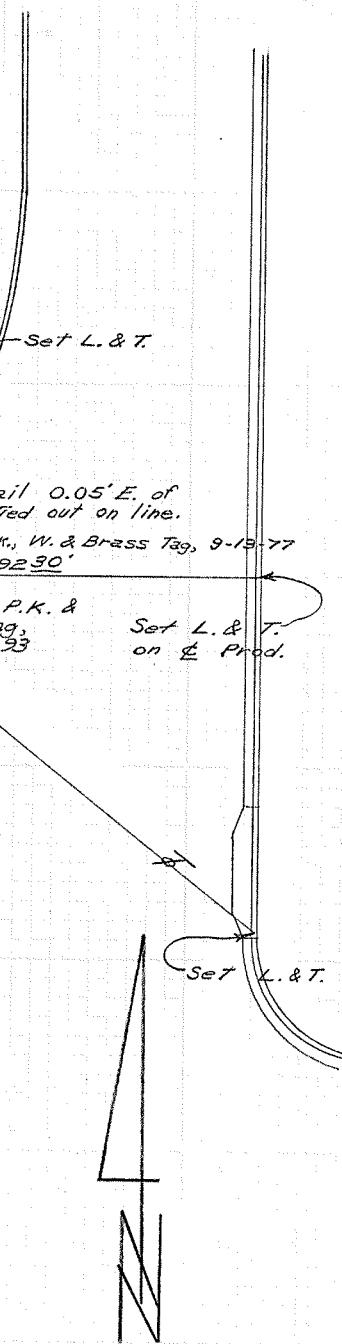

CITY OF GARDEN GROVE, CALIFORNIA

SURVEY OF Brookhurst St. & Roads End Dr. T B NO. 3 PAGE 85SURVEY BY Prickett & Party TRACT NO. _____DATE June 25, 1977

DO NOT EXTEND NOTES THIS SIDE OF LINE

SET L. & T.
ON E PROD.
10-20-55

22295'

2721'

Set Lg. P.K. & Brass Tag,
5-19-93

Fd. P.K.

Set Spk., W. & Brass Tag
9-19-77

SET L. & T.

BROOKHURST ST.

CONSTRUCTION

3200'

E ROADS END DRIVE

SET L. & T.

W.

Brass Tag

9-19-77

CITY OF GARDEN GROVE, CALIFORNIA

SURVEY OF Brookhurst St. & Geraldine Rd. T B NO 3 PAGE 86

SURVEY BY Prickett & Party TRACT NO.

DATE June 25, 1977

SURVEYORS SERVICE COMPANY STA MESA - STOCK NO. 411

DO NOT EXTEND NOTES THIS SIDE OF LINE

Set L. & T.
on E Prod.
10-20-88

2228'

Set L. & P.K. & Brass Tag
5-19-93

Fwd P.K.

Set S. W. & BRASS TAG

9-2-77

64755'

Set L. & T.

E BROOKHURST ST.

CONSTRUCTION E

3200'



Set L. & T.

E GERALDINE RD.

CITY OF GARDEN GROVE, CALIFORNIA


Brookhurst St. @ Joyzelle Dr.
SURVEY OF 3rd Parliament Ave. T B NO. 3 PAGE 87
SURVEY BY Prickett & Party TRACT NO.
DATE June 25, 1977

STA MESA - STOCK NO: 411

SURVEYORS SERVICE COMPANY.

50. P.M.'S ON M.H. RIM BISCAYNE CT.

DO NOT EXTEND NOTES THIS SIDE OF LINE

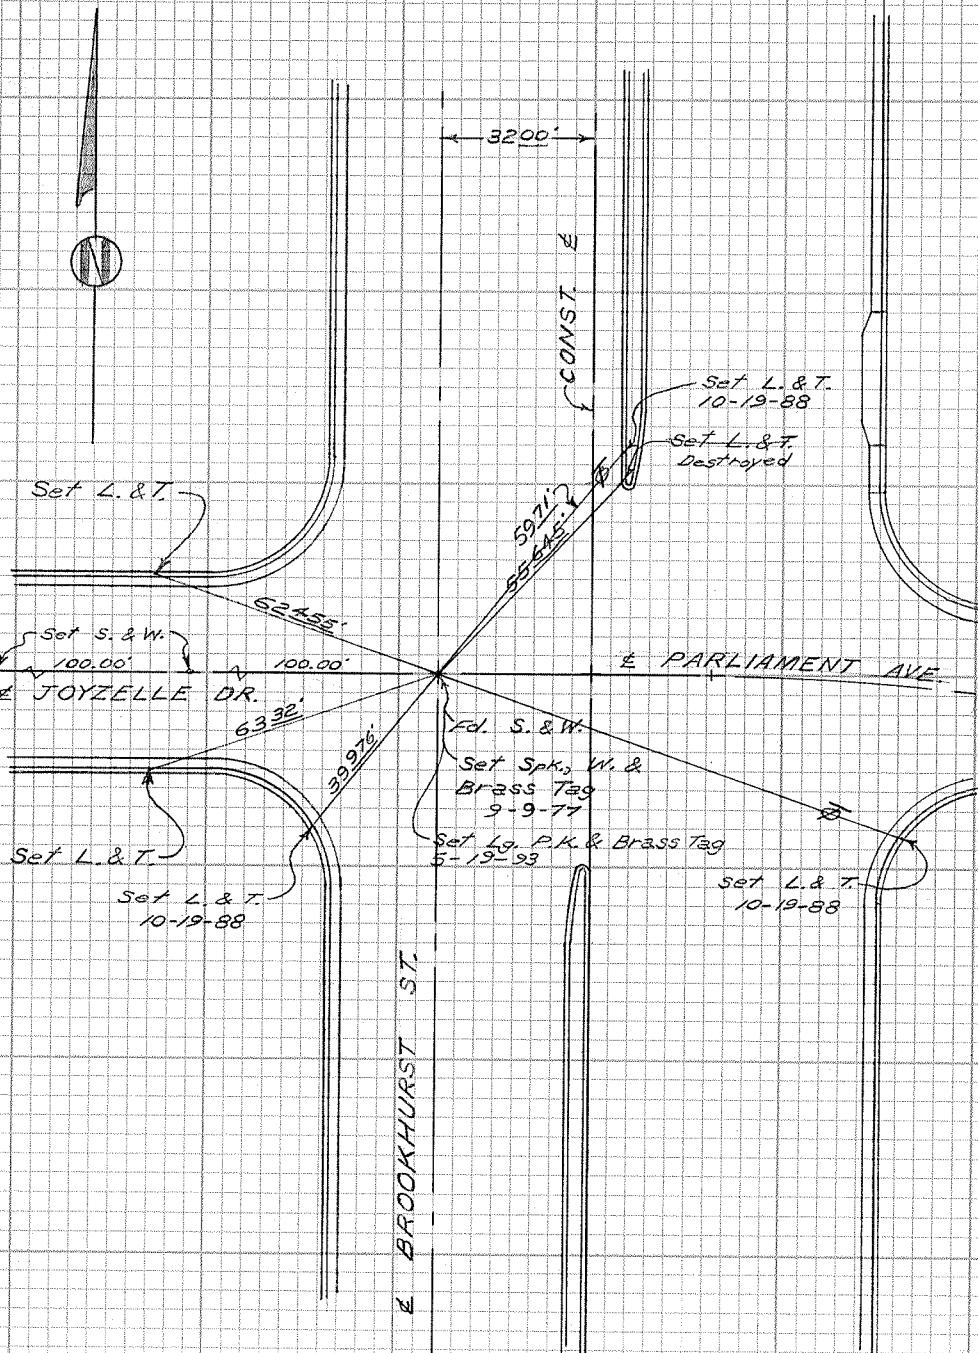


CITY OF GARDEN GROVE, CALIFORNIA

SURVEY OF Brookhurst & Dewey (W.) T B NO. 3 PAGE 89
SURVEY BY Prickett & Party TRACT NO.
DATE June 7, 1977

STA MESA - STOCK NO. 411

SURVEYORS SERVICE COMPANY

DO NOT EXTEND NOTES THIS SIDE OF LINE

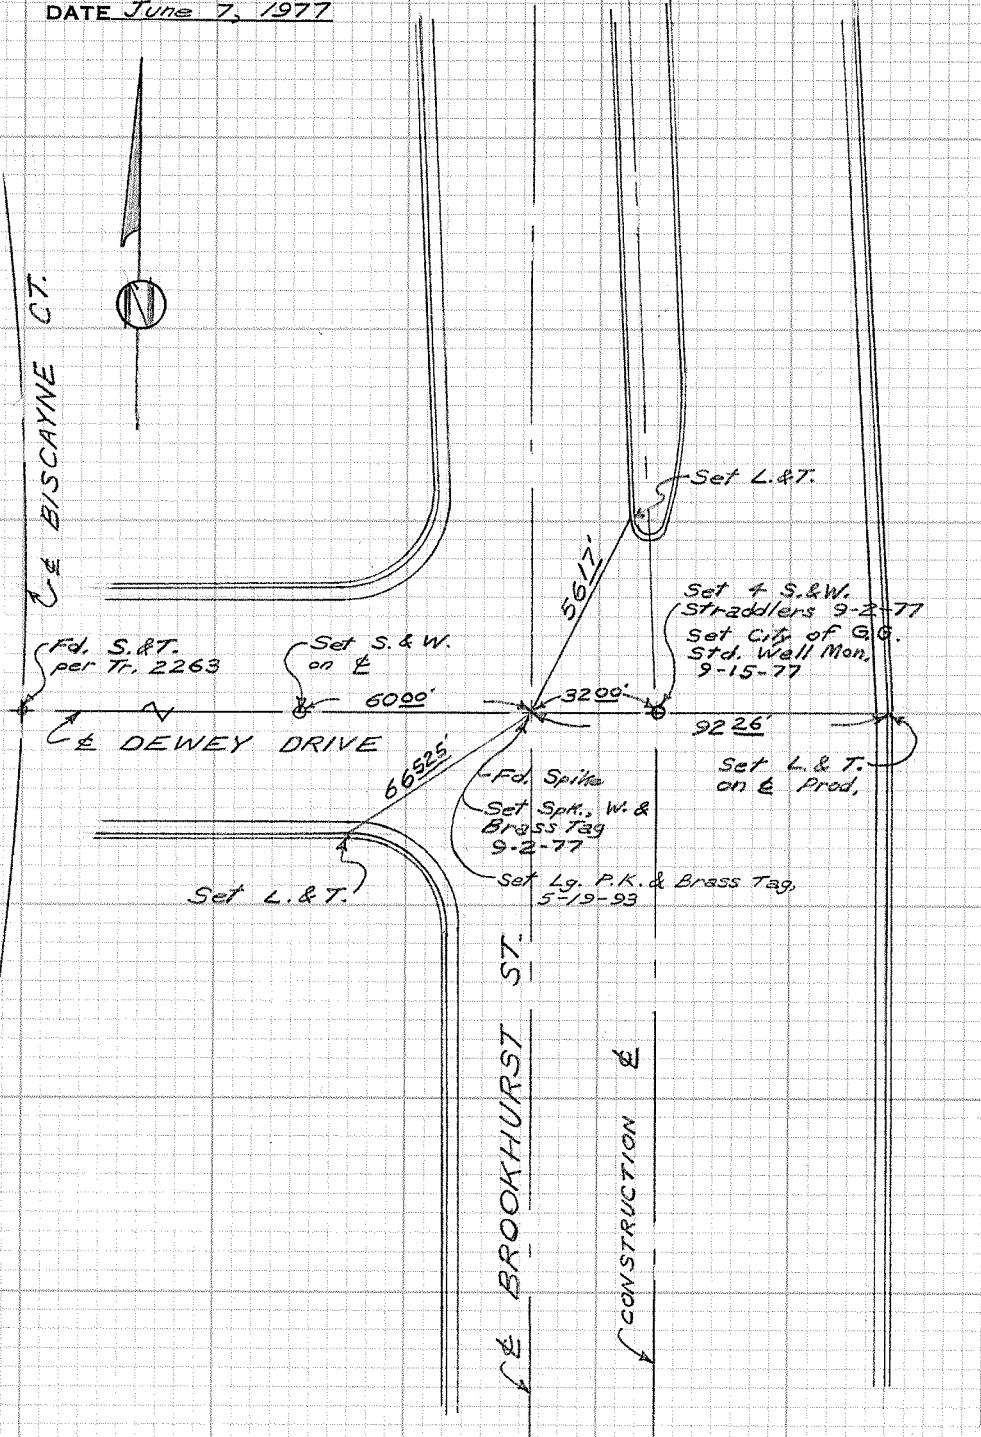


CITY OF GARDEN GROVE, CALIFORNIA

SURVEY OF Brookhurst St. & Dewey (E.) T B NO. 3 PAGE 90
SURVEY BY Prickett & Party TRACT NO.
DATE June 7, 1977

SURVEYORS SERVICE COMPANY - COSTA MESA - STOCK NO. 411

DO NOT EXTEND NOTES THIS SIDE OF LINE

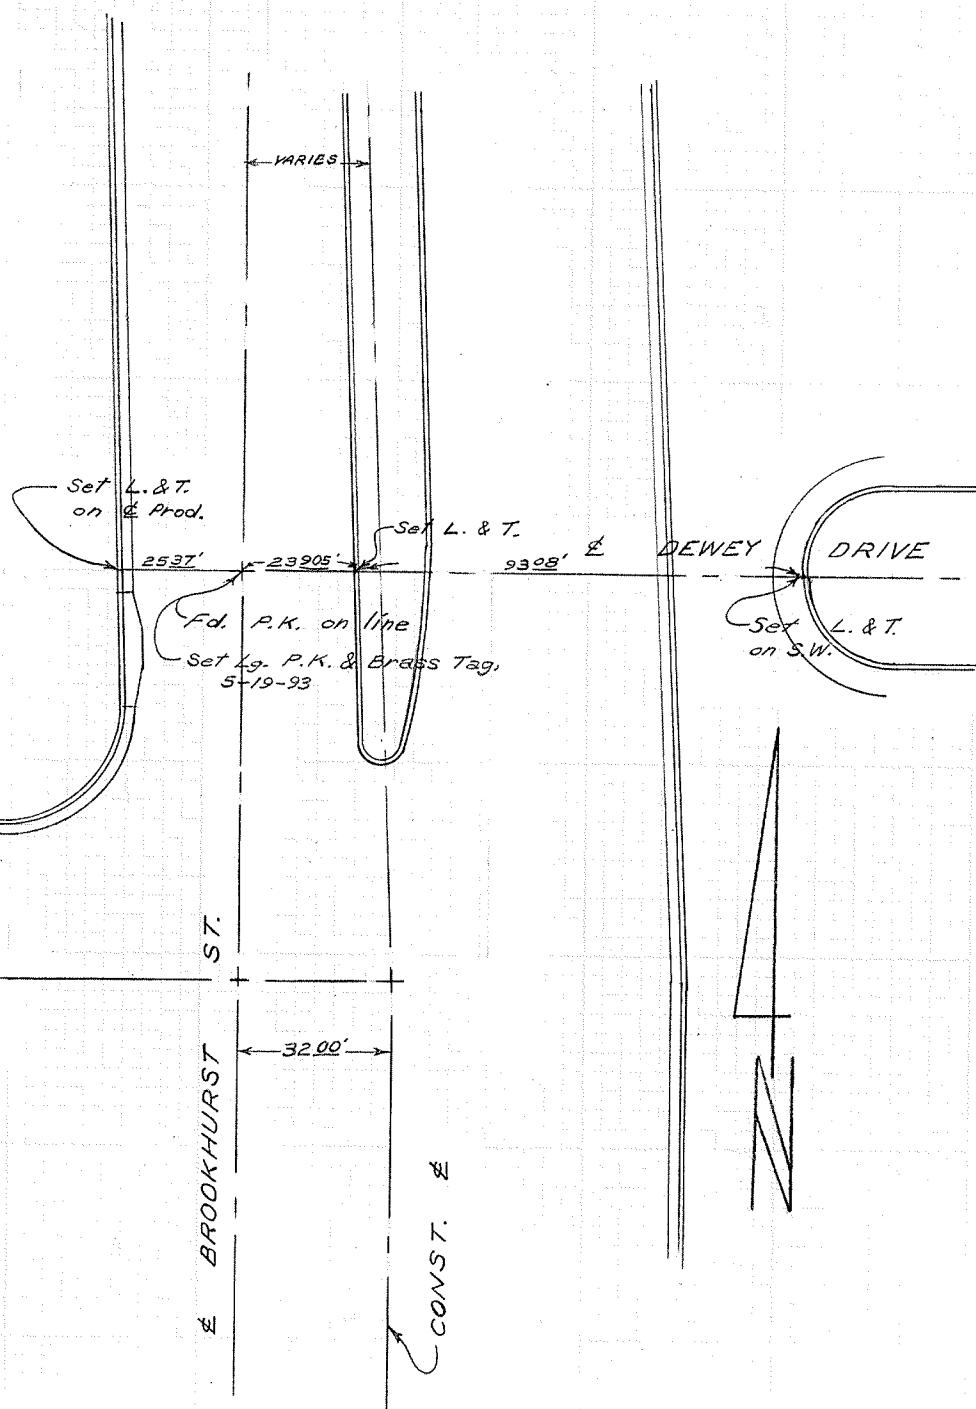

CITY OF GARDEN GROVE, CALIFORNIA

SURVEY OF Brookhurst St. & Aldgate Ave. T B NO. 3 PAGE 91


SURVEY BY Prickett & Party TRACT NO.

DATE June 8, 1977

DO NOT EXTEND NOTES THIS SIDE OF LINE

OSTA MESA - STOCK NO. 411

SURVEYORS SERVICE COMPANY

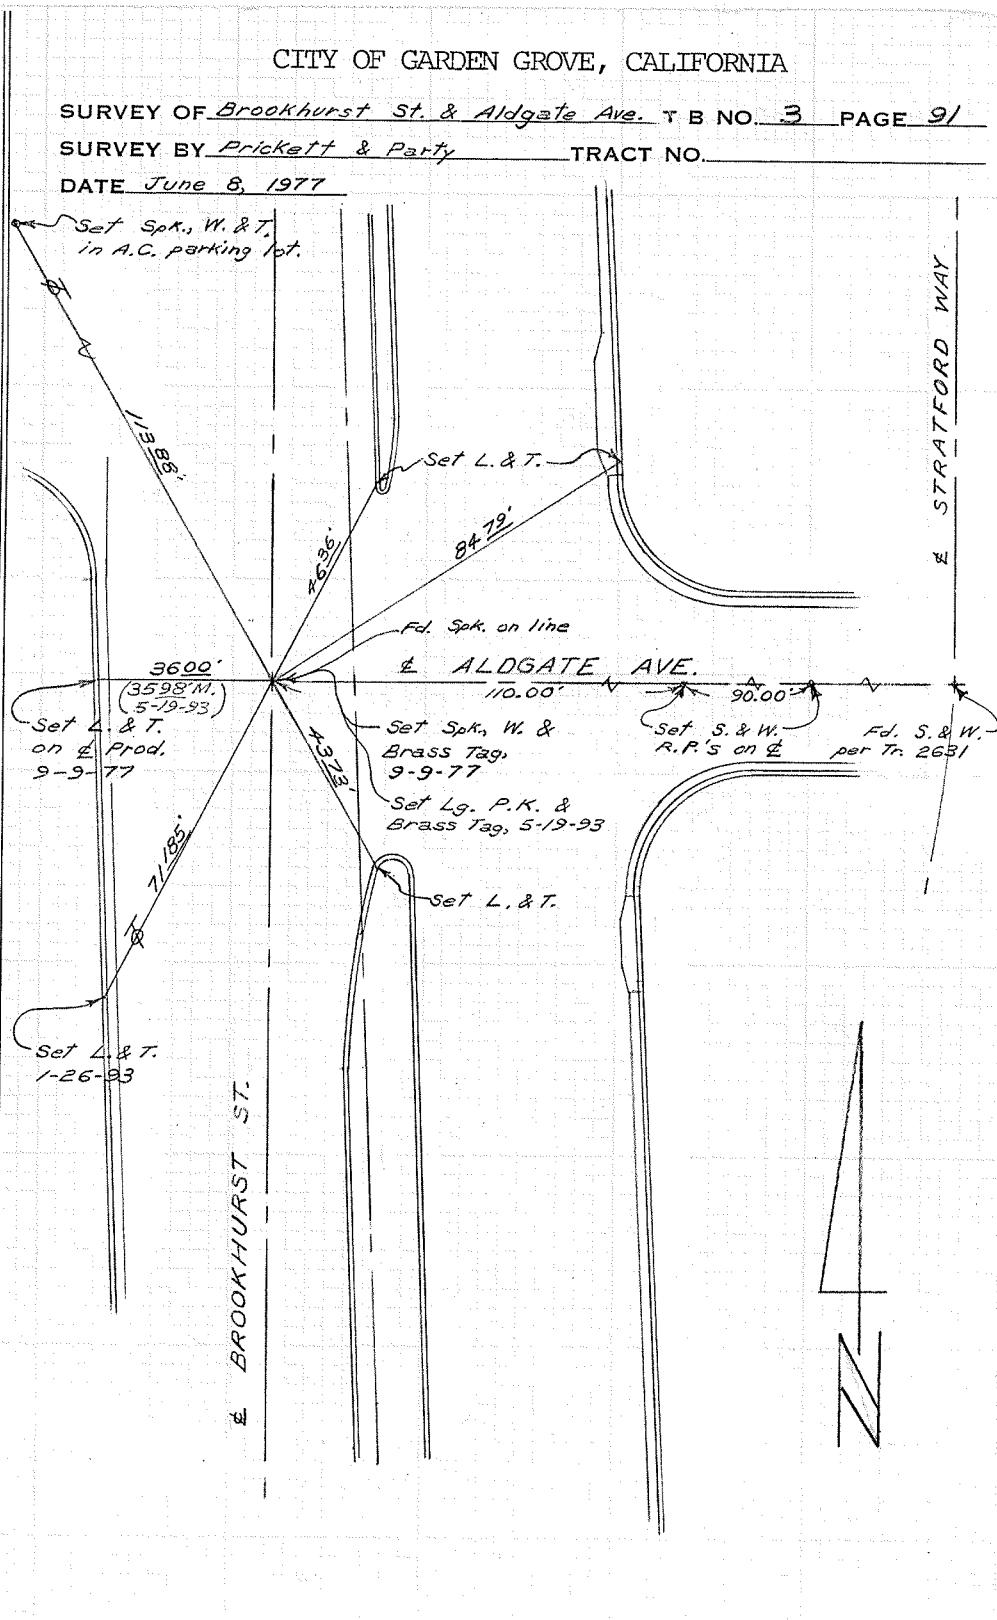


CITY OF GARDEN GROVE, CALIFORNIA

Brookhurst St. & Angle Pt.
 SURVEY OF 920 ft. South of Katella T B NO. 3 PAGE 92
 SURVEY BY Prickett & Party TRACT NO.
 DATE Oct. 22, 1977

STA MESA - STOCK NO. 411

SURVEYORS SERVICE COMPANY

DO NOT EXTEND NOTES THIS SIDE OF LINE

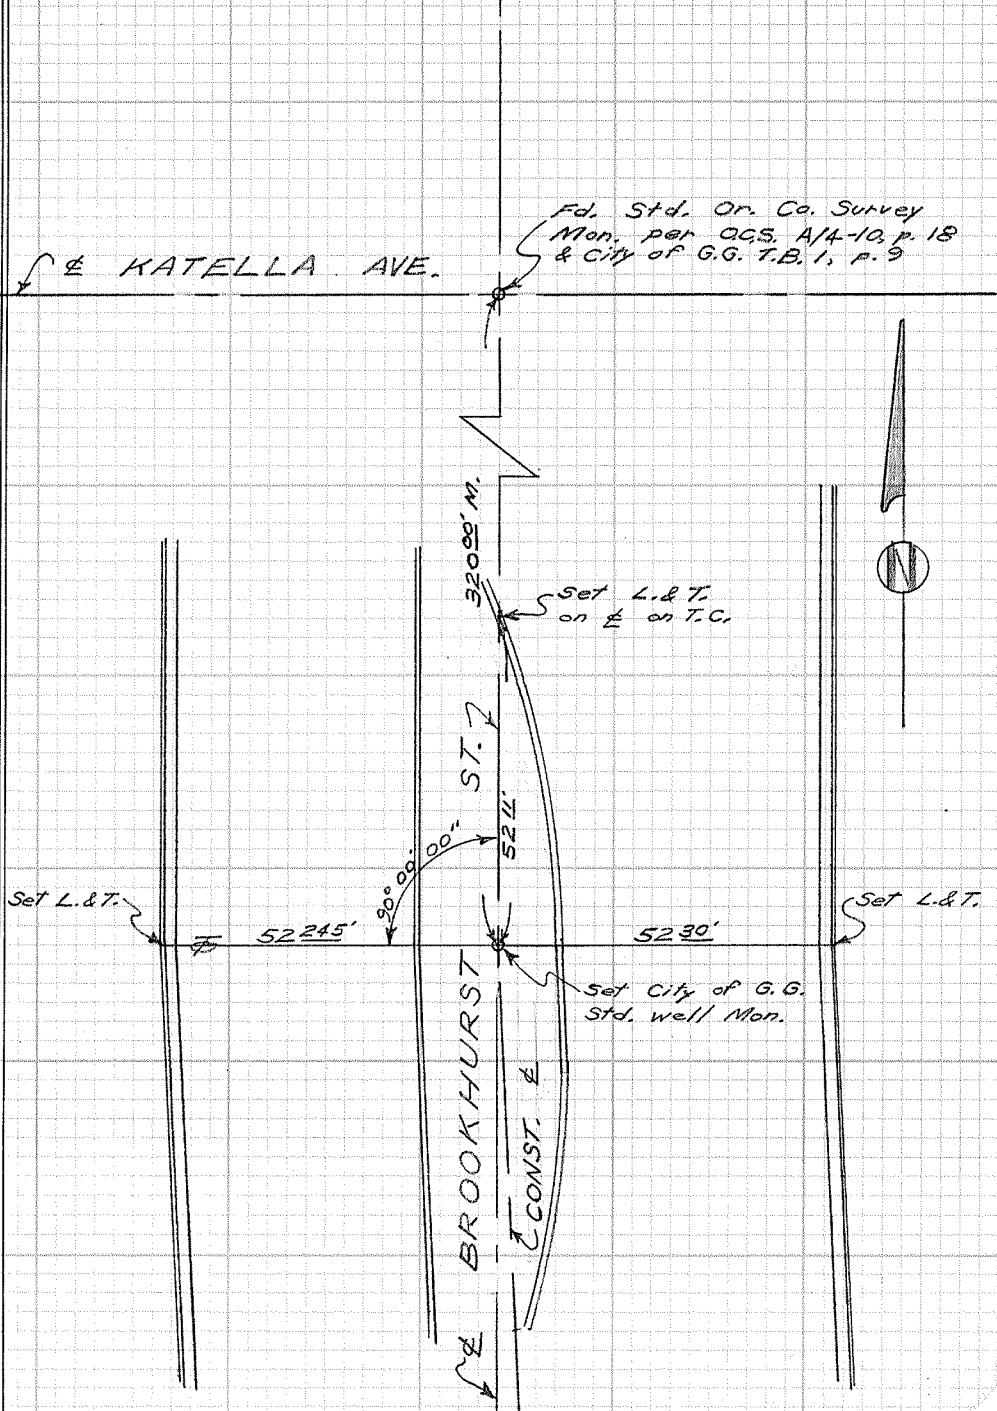


CITY OF GARDEN GROVE, CALIFORNIA

SURVEY OF Garden Grove Blvd. & Westlake T. B NO. 3 PAGE 93
SURVEY BY Prickett & Party TRACT NO.
DATE Oct. 22, 1977

SURVEYORS SERVICE COMPANY STA MESA - STOCK NO. 411

DO NOT EXTEND NOTES THIS SIDE OF LINE

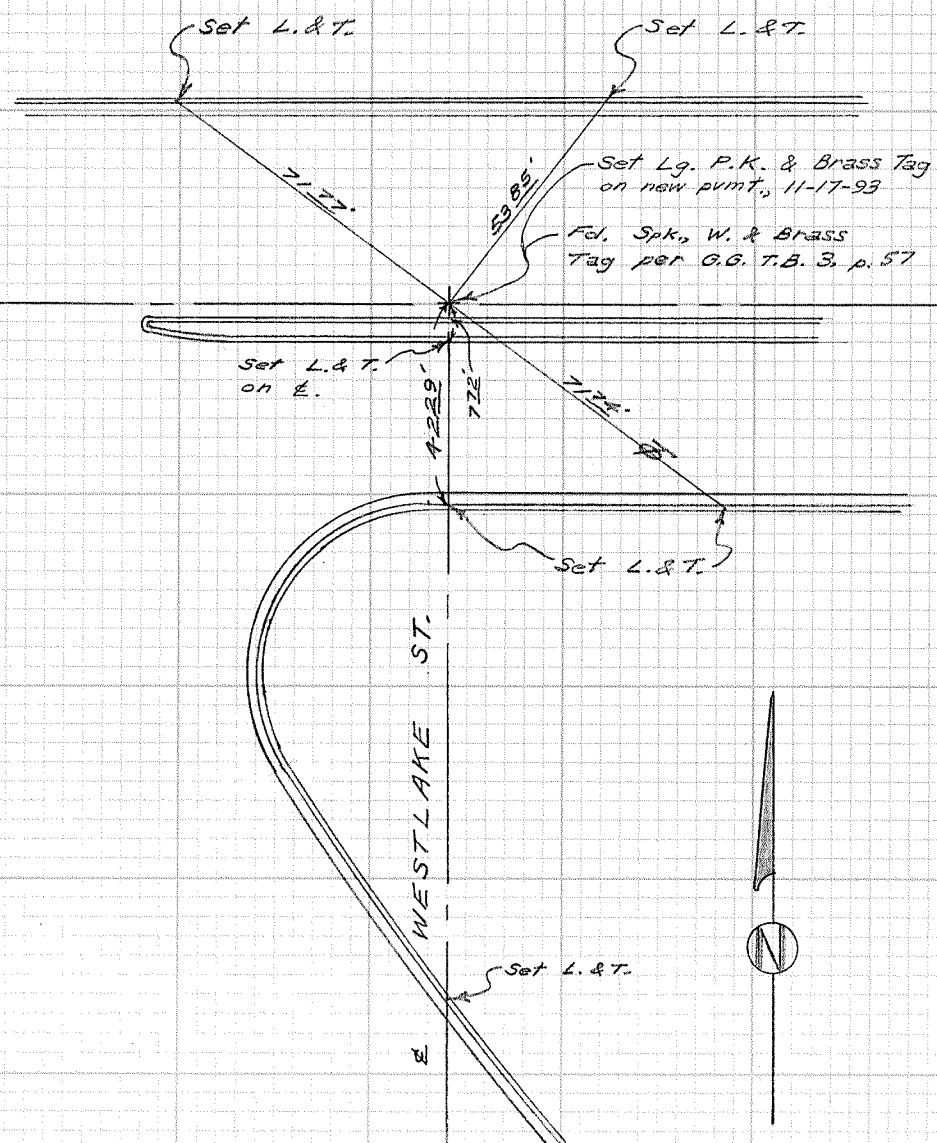

CITY OF GARDEN GROVE, CALIFORNIA

SURVEY OF Garden Grove Blvd & Walnut Ave. T B NO. 3 PAGE 95

SURVEY BY Prickett & Party TRACT NO.


DATE June 18, 1977

411

SURVEYORS SERVICE COMPANY

STA MESA - STOCK NO. 411

DO NOT EXTEND NOTES THIS SIDE OF LINE

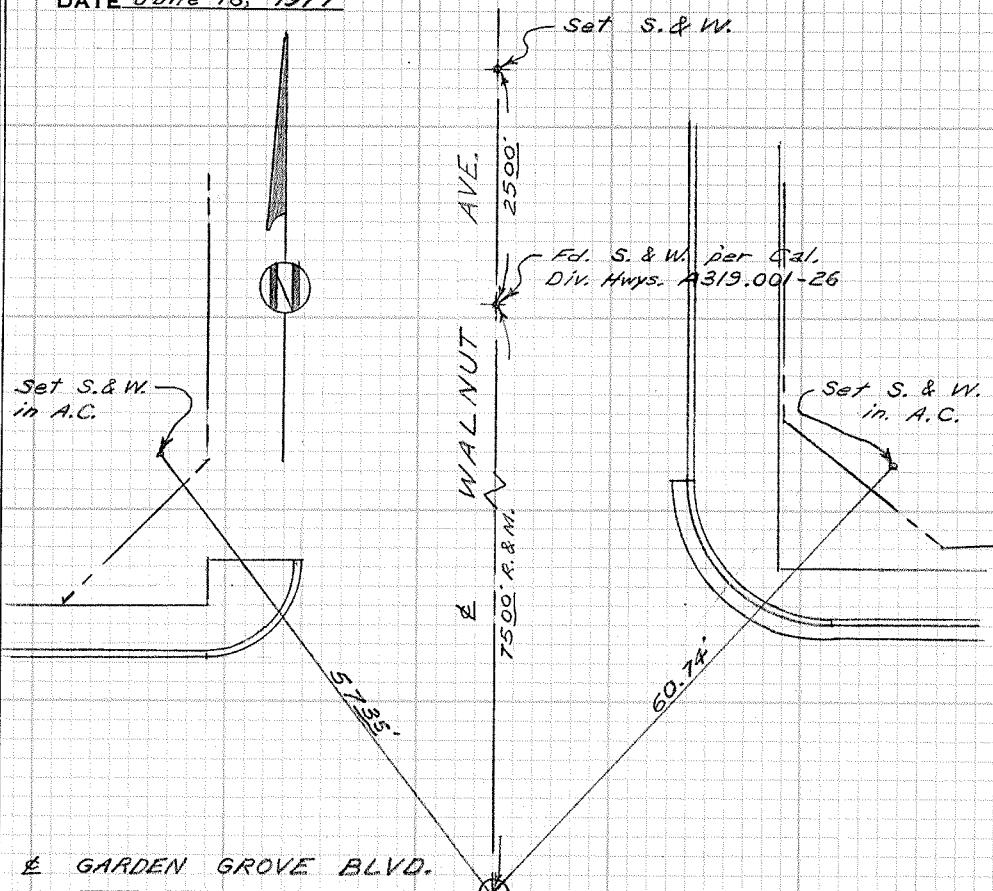

CITY OF GARDEN GROVE, CALIFORNIA

SURVEY OF Garden Grove Blvd. & Walnut Ave. T B NO. 3 PAGE 95A


SURVEY BY Prickett & Party TRACT NO. _____

DATE July 13, 1993

DO NOT EXTEND NOTES THIS SIDE OF LINE

TA MESA - STOCK NO. 411

SURVEYORS SERVICE COMPANY.

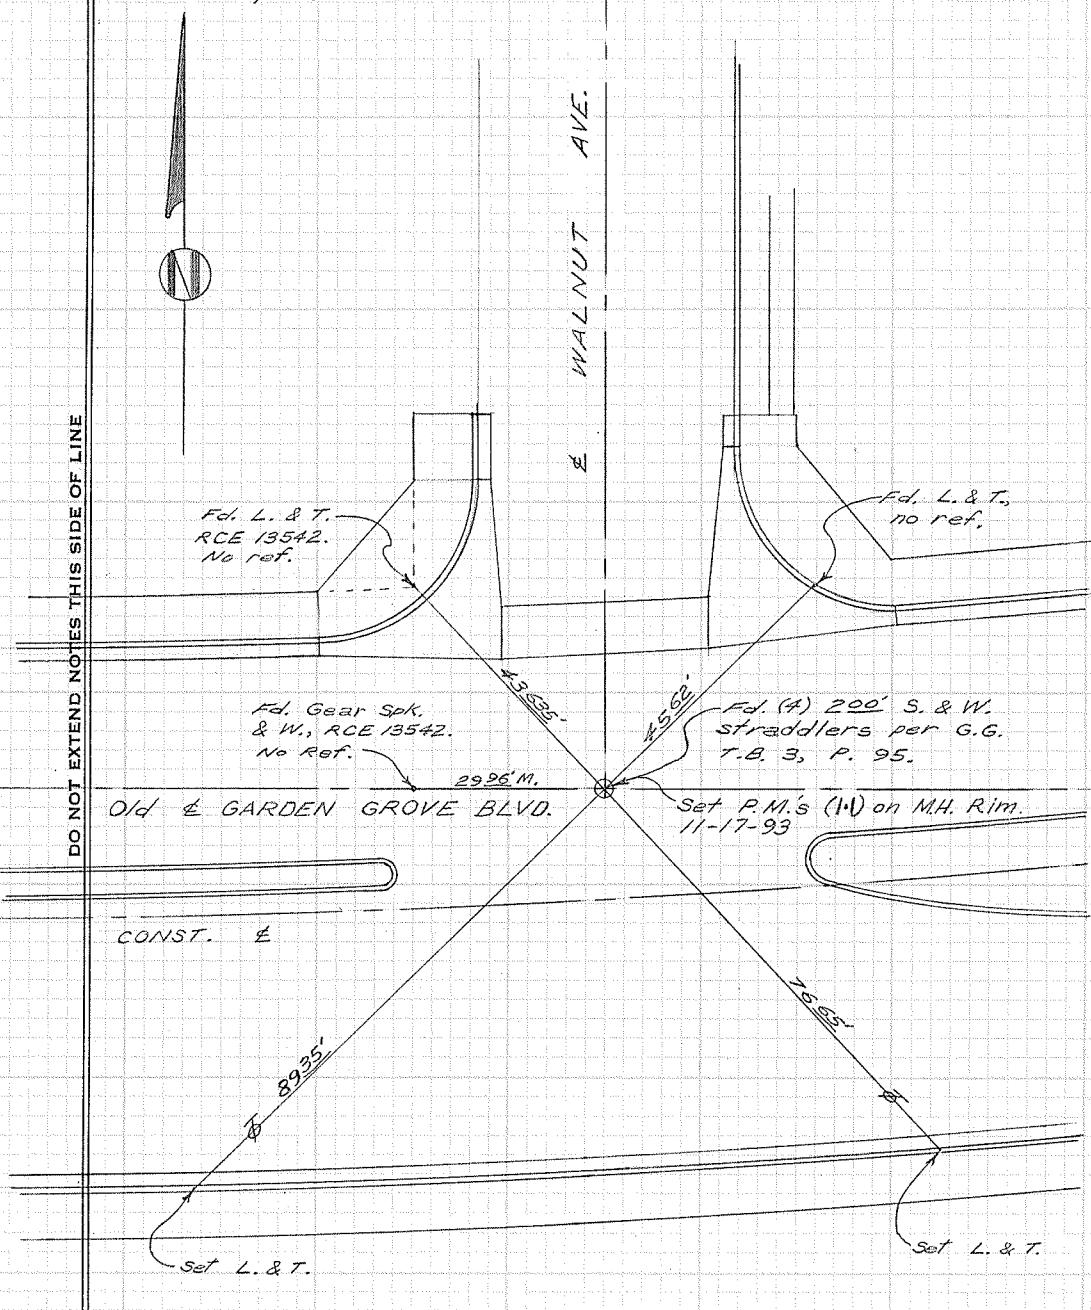


CITY OF GARDEN GROVE, CALIFORNIA

Garden Grove Blvd. & Pine St.
 SURVEY OF Garden Grove Blvd. & Lincoln St. T B NO. 3 PAGE 96
 SURVEY BY Prickett & Party TRACT NO.
 DATE June 18, 1977

SURVEYORS SERVICE COMPANY - STA MESA - STOCK NO. 411

DO NOT EXTEND NOTES THIS SIDE OF LINE

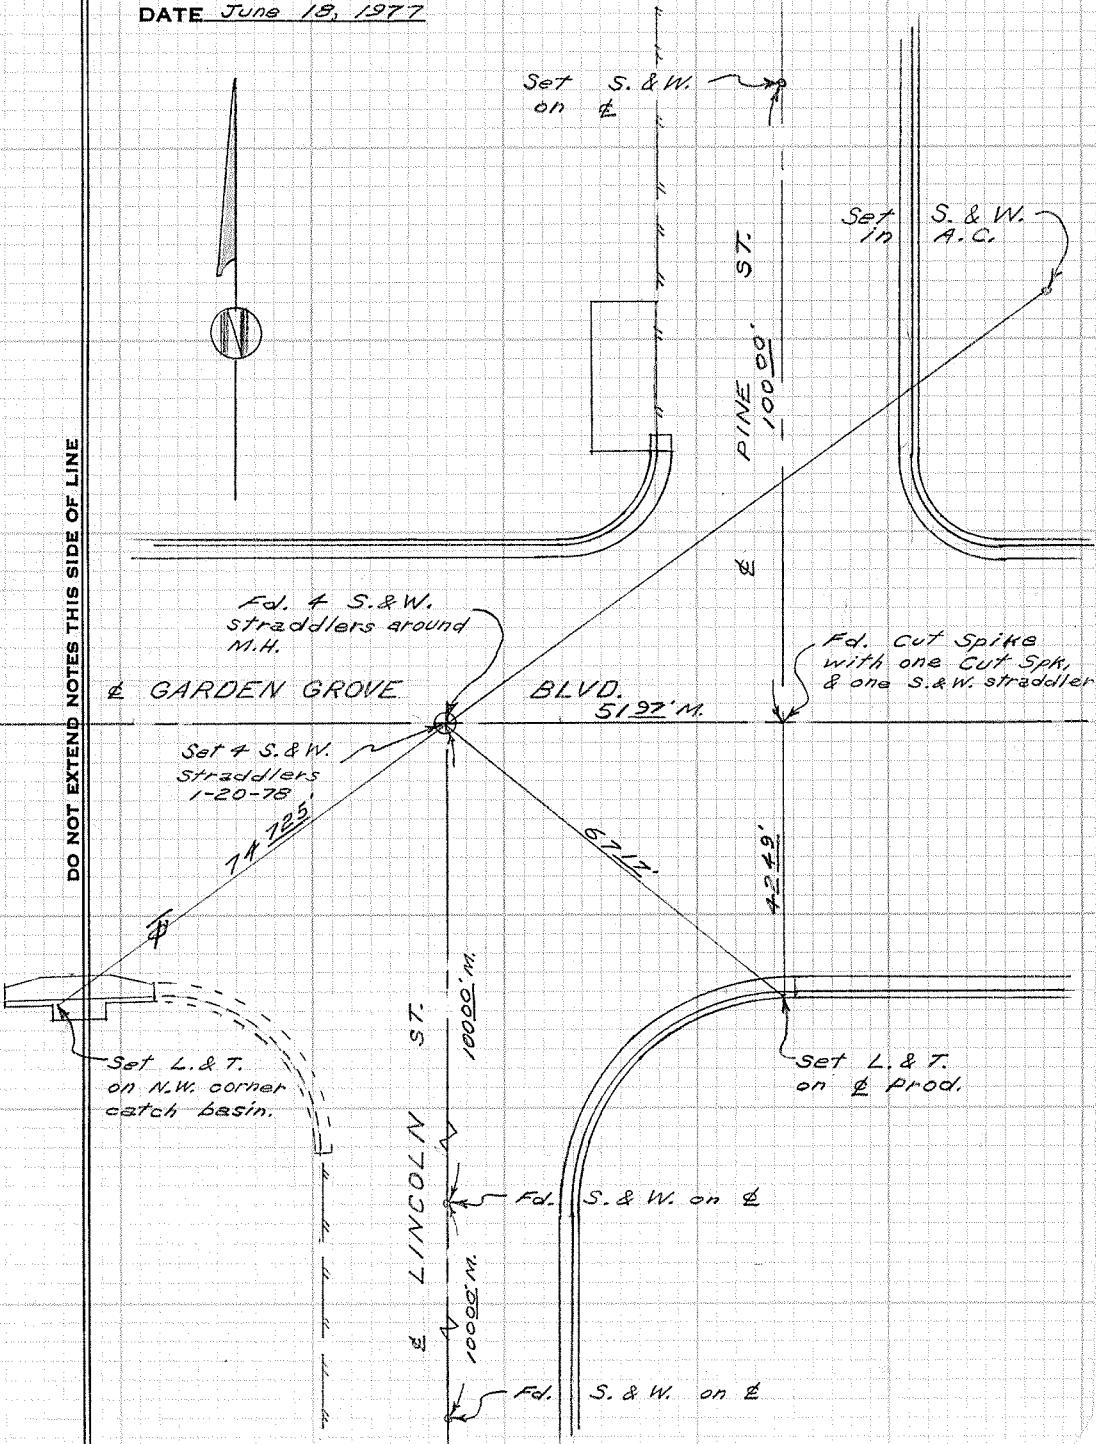

CITY OF GARDEN GROVE, CALIFORNIA

Garden Grove Blvd. & Pine St.
SURVEY OF Garden Grove Blvd. & Lincoln St. T B NO. 3 PAGE 96A


SURVEY BY Prickett & Party TRACT NO.

DATE JULY 12, 1993

TRACT NO.

DO NOT EXTEND NOTES THIS SIDE OF LINE

TA MESA SURVEYORS SERVICE COMPANY STOCK NO. 411

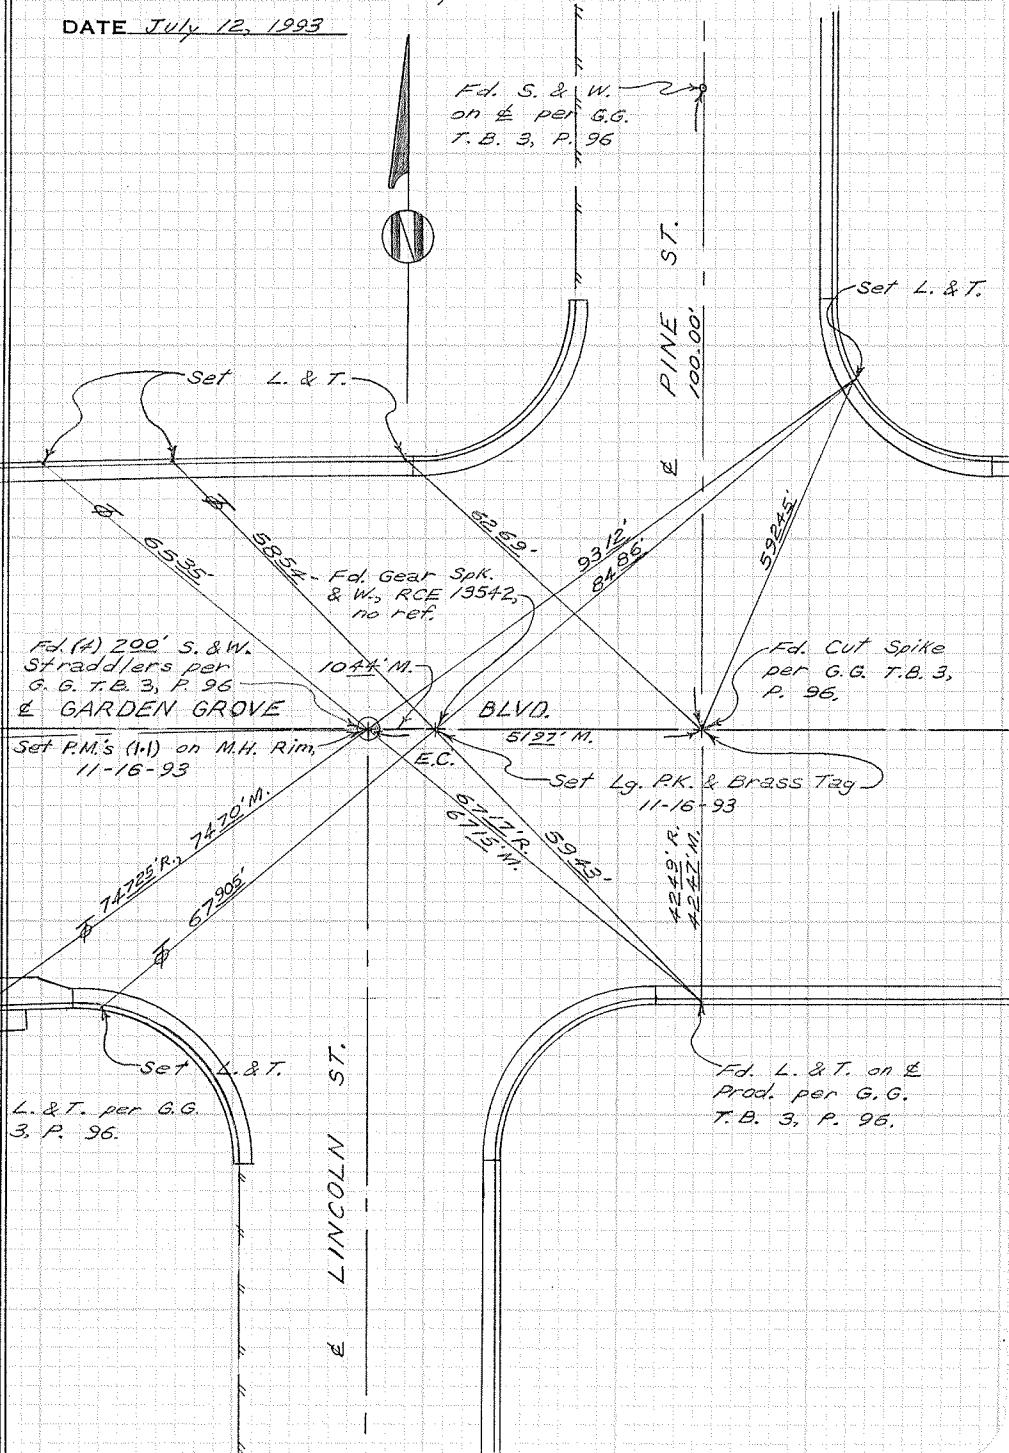


CITY OF GARDEN GROVE, CALIFORNIA

X at Orangewood & Rancho Line
SURVEY OF _____ T B NO. 3 PAGE 97
SURVEY BY Prickett & Party TRACT NO. _____
DATE July 3, 1978

DO NOT EXTEND NOTES THIS SIDE OF LINE

SURVEYORS SERVICE COMPANY - STA MESA - STOCK NO. 411

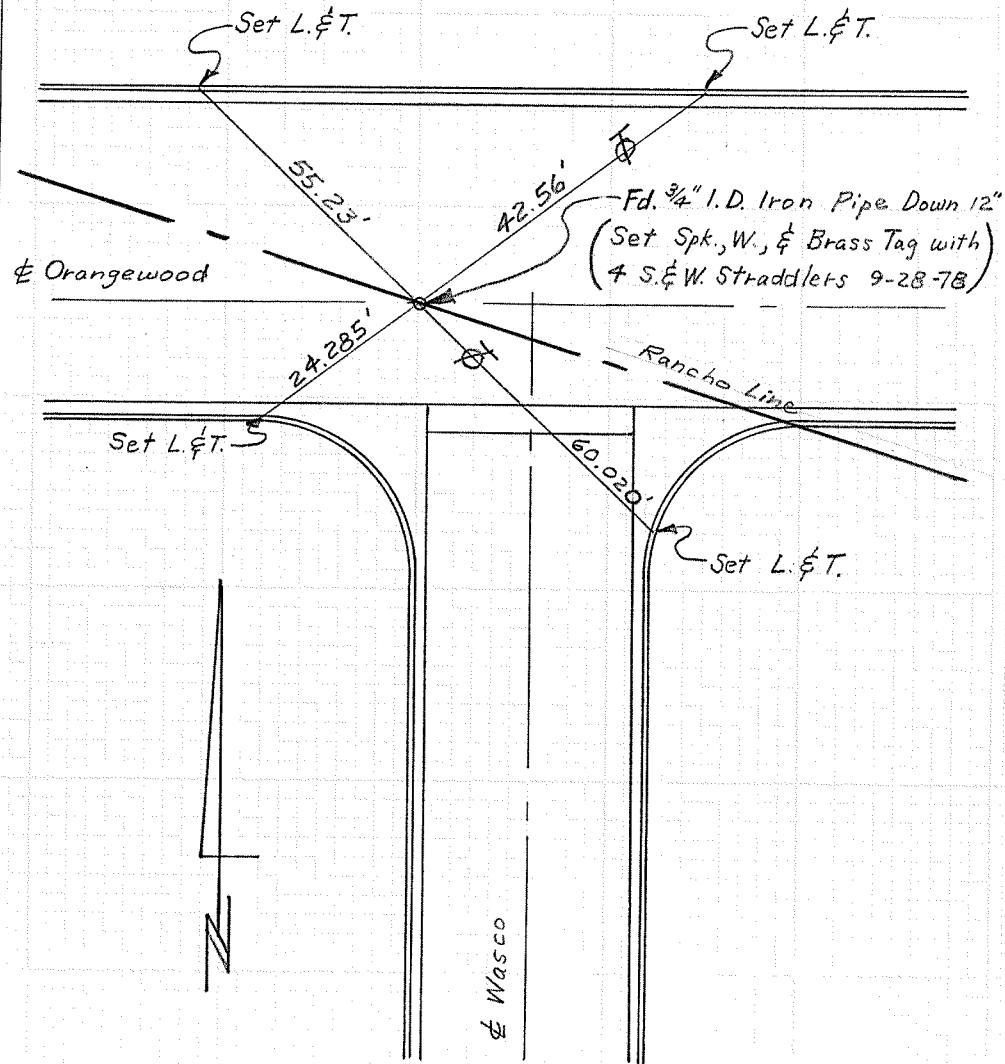


CITY OF GARDEN GROVE, CALIFORNIA

SURVEY OF Orangewood & Mac St. T B NO. 3 PAGE 98

SURVEY BY Prickett & Party TRACT NO.

DATE July 3, 1978

DO NOT EXTEND NOTES THIS SIDE OF LINE

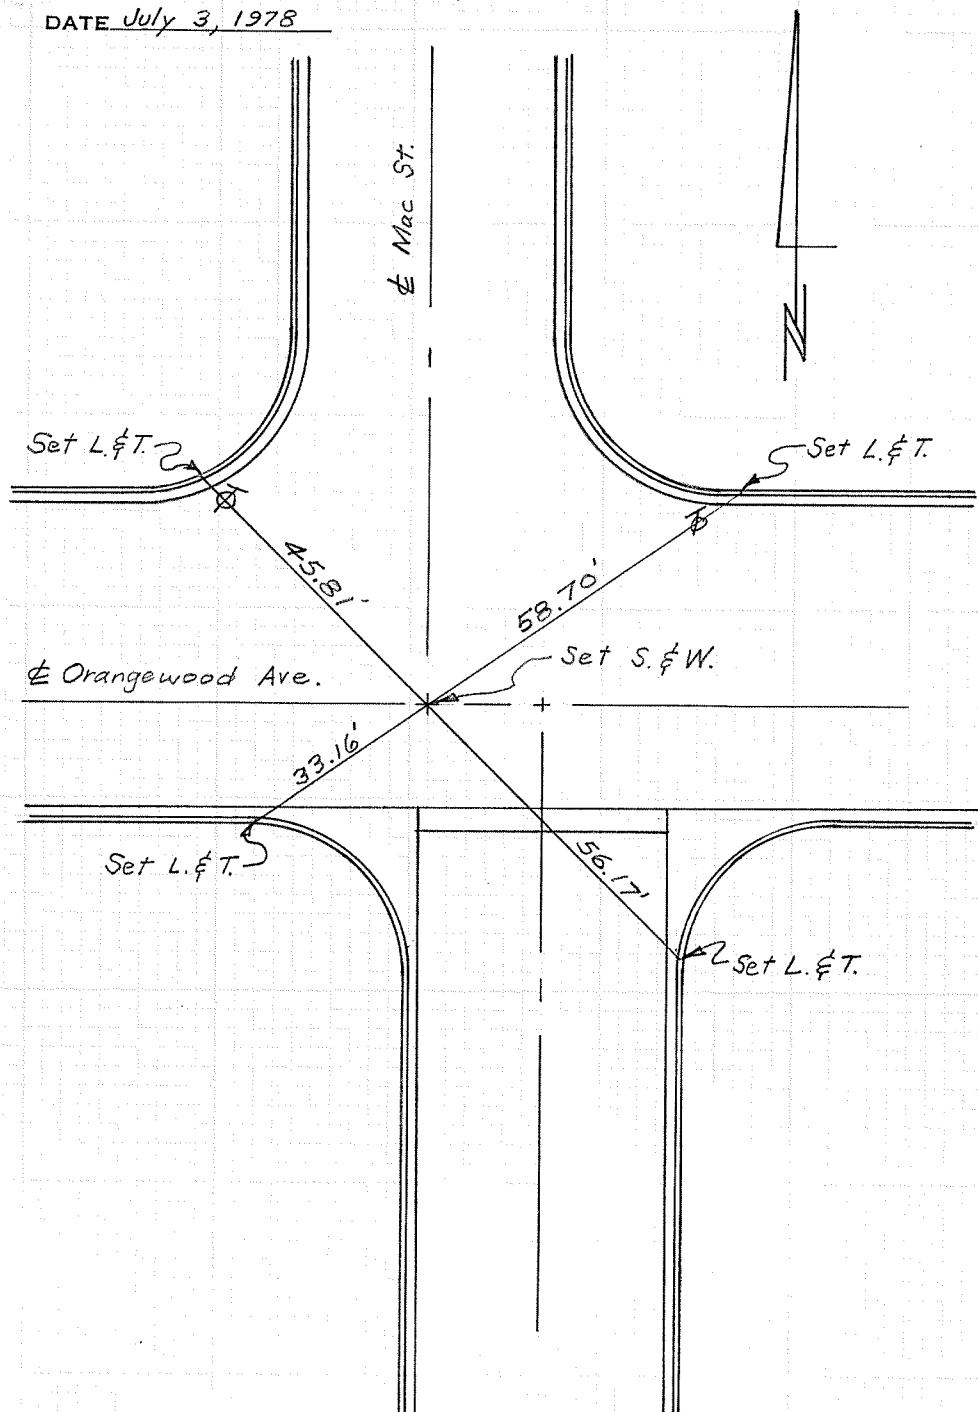

CITY OF GARDEN GROVE, CALIFORNIA

SURVEY OF Orangewood & R.R.


T B NO. 3 PAGE 99

SURVEY BY Prickett & Party

TRACT NO.

DATE July 6, 1978

DO NOT EXTEND NOTES THIS SIDE OF LINE

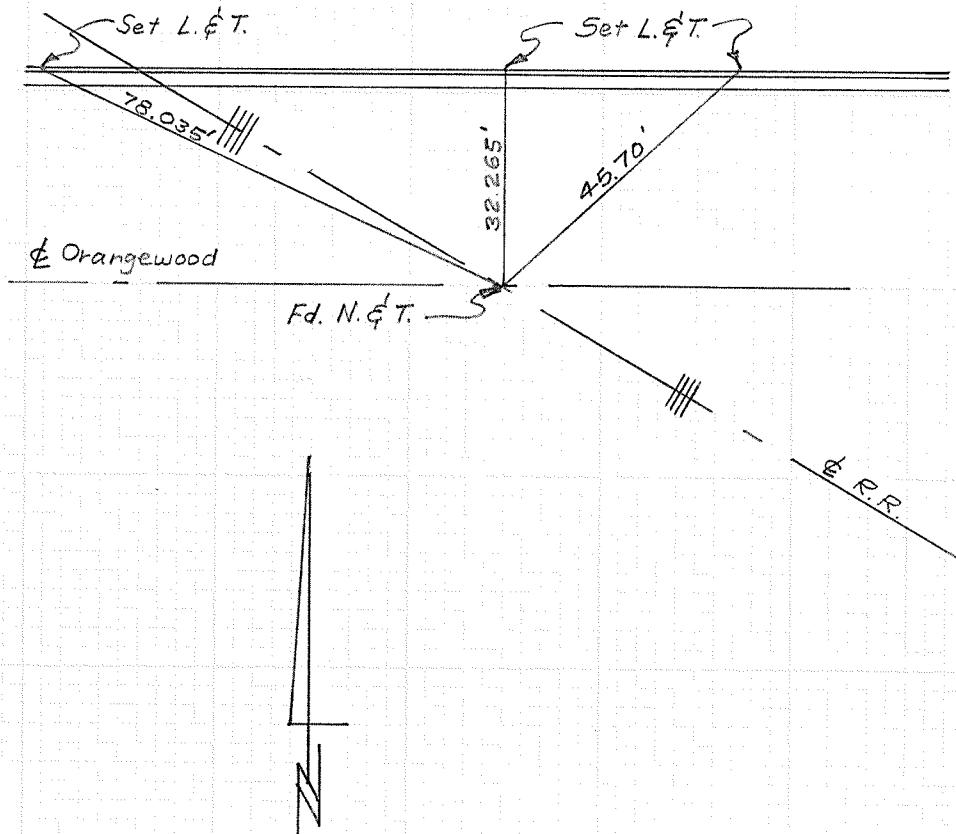

CITY OF GARDEN GROVE, CALIFORNIA

SURVEY OF Flower St. & Dakota Ave. T B NO. 3 PAGE 100

SURVEY BY Prickett & Party TRACT NO.

DATE Sept. 27, 1978

DO NOT EXTEND NOTES THIS SIDE OF LINE

Set S & W
on \$ 50.00'

E DAKOTA AVE.

Fd. Notches on M.H.
Rim per C.S.T.B. 135-1
& 135-7

50.00'

Set S. & W.
on \$ 50.00'

Set Spk., W.
& BRASS TAG ON
new pvt.
5-2-79

E FLOWER ST.

CITY OF GARDEN GROVE, CALIFORNIA

SURVEY OF Flower St. & Russell Ave. T B NO. 3 PAGE 101

SURVEY BY Prickett & Party TRACT NO. _____

DATE Oct. 4, 1978

SURVEYORS SERVICE COMPANY STA MESA - STOCK NO. 411

DO NOT EXTEND NOTES THIS SIDE OF LINE

Set S. & W.
on E

5000'

E RUSSELL AVE.

Fol Notches on M.H.
Rim per C.S. T.B. 135-1
& 135-8, 0.05' W. of line.
(ried out on line)

Set S. & W.
on E

5000'

Set Spk., W. &
BRASS Tag on new
pmt., 5-2-79

FLOWER ST.

E

CITY OF GARDEN GROVE, CALIFORNIA

SURVEY OF Flower St. & Imperial T B NO. 3 PAGE 102

SURVEY BY Prickett & Party TRACT NO.

DATE OCT. 5, 1978

SURVEYORS SERVICE COMPANY STA MESA - STOCK NO. 411

DO NOT EXTEND NOTES THIS SIDE OF LINE

10000'

Set S.&W.
on E

E FLOWER ST.

Fd. Notches on N.H.
(Rim per C.S.T.B. 135-1
& 135-9.

E IMPERIAL AVE.

10000'

Set S.P.K. W.
& Brass Tag on
new point
5-2-79

Set S.&W.
on E

CITY OF GARDEN GROVE, CALIFORNIA

SURVEY OF Flower St. & Central T B NO. 3 PAGE 103

SURVEY BY Prickett & Party TRACT NO.

DATE Oct. 5, 1978

DO NOT EXTEND NOTES THIS SIDE OF LINE

E BROOKHURST ST.

Fd. S. & W. per
G.G.T.B. 3, p. 6

E CENTRAL AVE.
5000'

Set S.&W.
on E

E DAKOTA AVE.

E EMERSON AVE.

Fd. Notches on M.H.
S Rim per C.S.T.B. 135-2
& 135-13

E FLOWER ST.

Fd. Nothing
Set Spk., W. &
Brass Tag by
Intersection.
(Reset 5-3-79)

5000'

Set S.&W.
on E

Fd. Notches
on M.H. Rim
per C.S.T.B.
135-10

E EXPRESS ST.

CITY OF GARDEN GROVE, CALIFORNIA

SURVEY OF Flower St. & Crosby Ave. T B NO. 3 PAGE 104
SURVEY BY Prickett & Party TRACT NO.
DATE Oct. 6, 1978

SURVEYORS SERVICE COMPANY, STA MESA - STOCK NO. 411

DO NOT EXTEND NOTES THIS SIDE OF LINE

(Set S. & W.
on $\frac{1}{2}$)

10000'
CROSBY AVE.

Fol. Notches on M.H.
Rim per C.S.T.B.
135-2 & 135-11

(Set S. & W.
on $\frac{1}{2}$)

10000'
Set Spk., N. &
Brass Tag on new
pmts 5-2-79

FLOWER ST


CITY OF GARDEN GROVE, CALIFORNIA

SURVEY OF Flower St. & Larson Ave. T.B. NO. 3 PAGE 105

SURVEY BY Prickett & Party TRACT NO.

DATE Oct. 6, 1978

DO NOT EXTEND NOTES THIS SIDE OF LINE

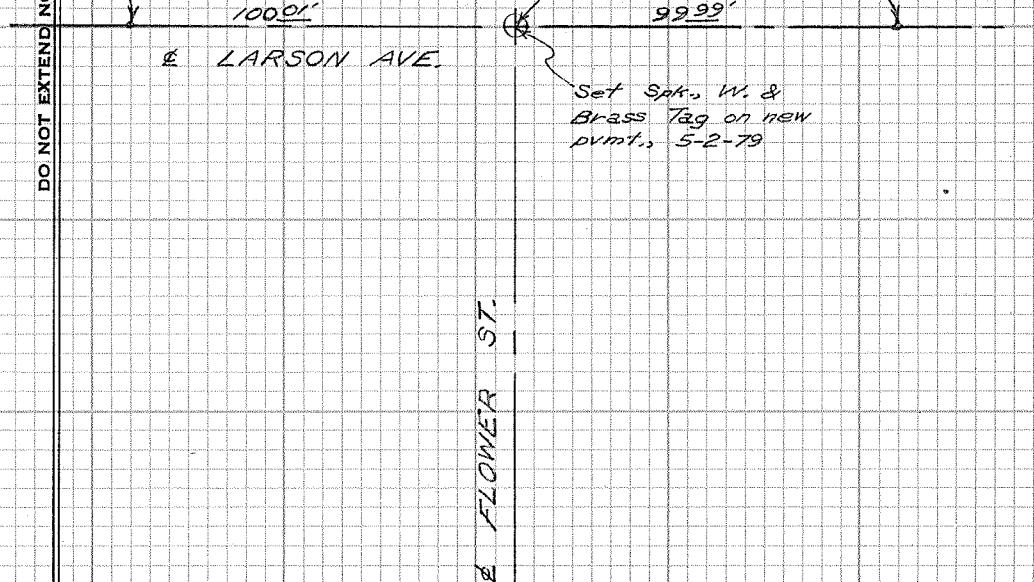

CITY OF GARDEN GROVE, CALIFORNIA

SURVEY OF Flower St. & Emerson Ave. T.B. NO. 3 PAGE 106

SURVEY BY Prickett & Party TRACT NO.

DATE Oct. 6, 1978

DO NOT EXTEND NOTES THIS SIDE OF LINE

Set S. & W.
on \angle

100.00'

EMERSON AVE.

Fd. Notches on M.H.
Rim per C.S.T.B.
135-2 & 135-13

99.90'

Set S. & W.
on \angle


Set Spk., W. &
Brass Tag on new
pvtmt., 5-2-79

FLOWER ST.

CITY OF GARDEN GROVE, CALIFORNIA

SURVEY OF Garden Grove Blvd. & Flower T.B. NO. 3 PAGE 107
SURVEY BY Prickett & Party TRACT NO.
DATE Feb. 13, 1979

DO NOT EXTEND NOTES THIS SIDE OF LINE

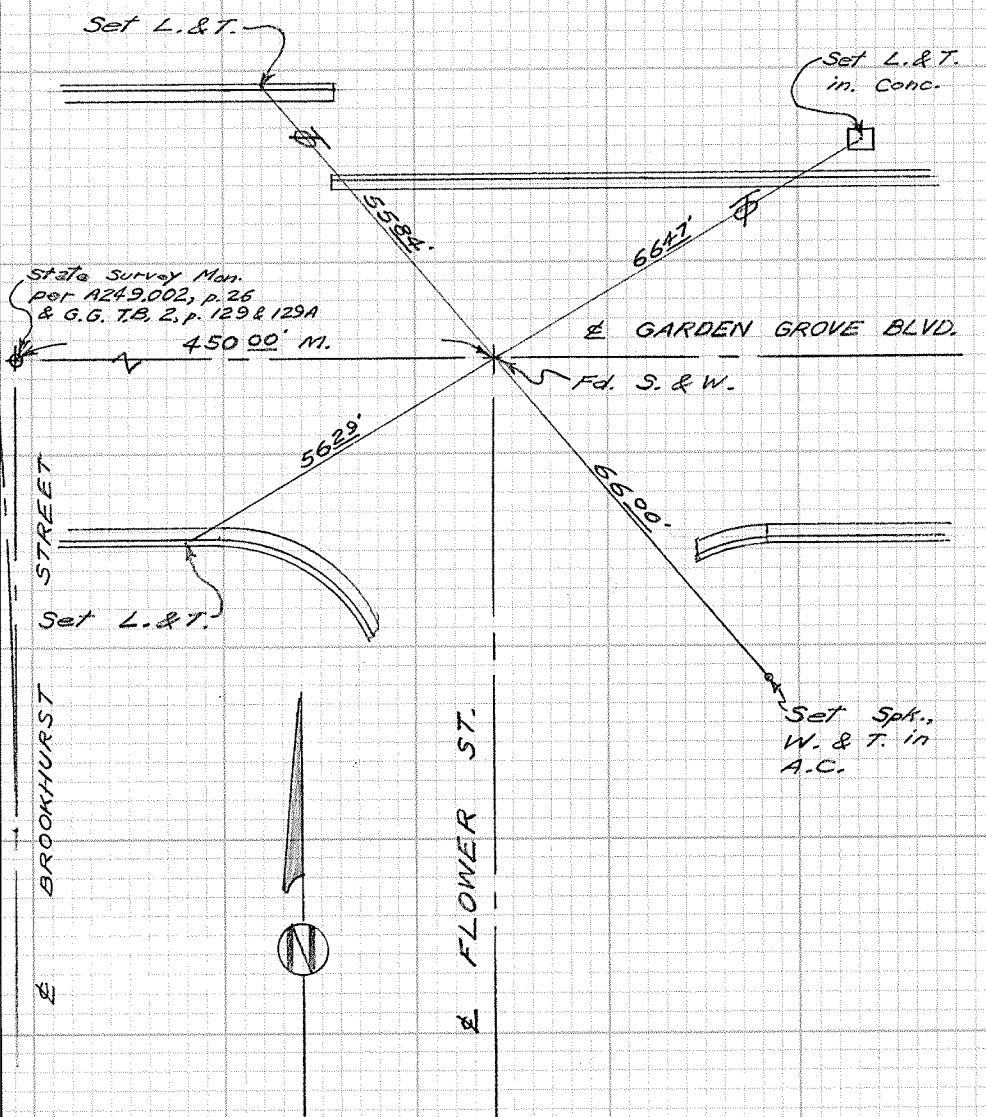


CITY OF GARDEN GROVE, CALIFORNIA

SURVEY OF Garden Grove Blvd. & Flower T B NO 3 PAGE 107A
SURVEY BY Prickett & Party TRACT NO.
DATE July 10, 1950

SURVEYORS SERVICE COMPANY STA MESA - STOCK NO. 411

DO NOT EXTEND NOTES THIS SIDE OF LINE

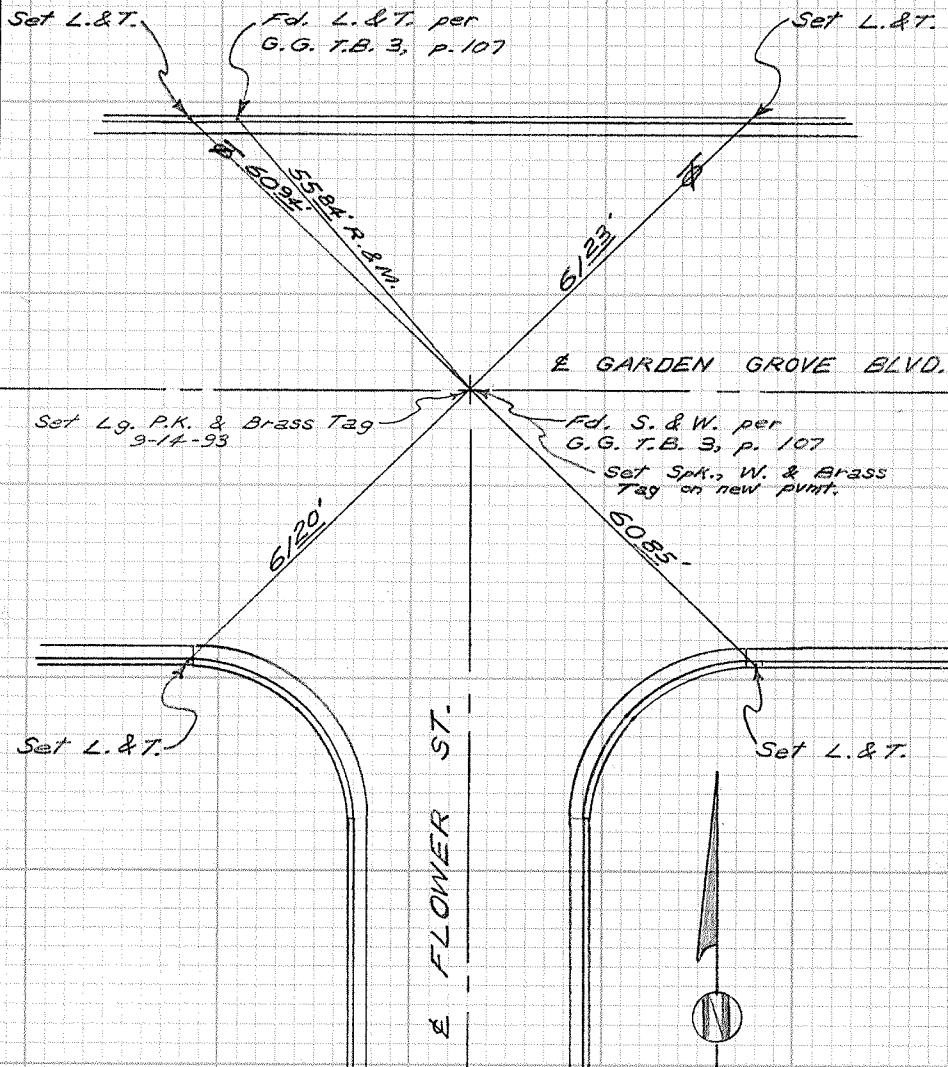


CITY OF GARDEN GROVE, CALIFORNIA

SURVEY OF S. C. on Garden Grove Bl. W. of Taft T B NO. 3 PAGE 108
SURVEY BY Prickett & Party TRACT NO.
DATE October 10, 1978

SURVEYORS SERVICE COMPANY STA MESA - STOCK NO. 411

DO NOT EXTEND NOTES THIS SIDE OF LINE

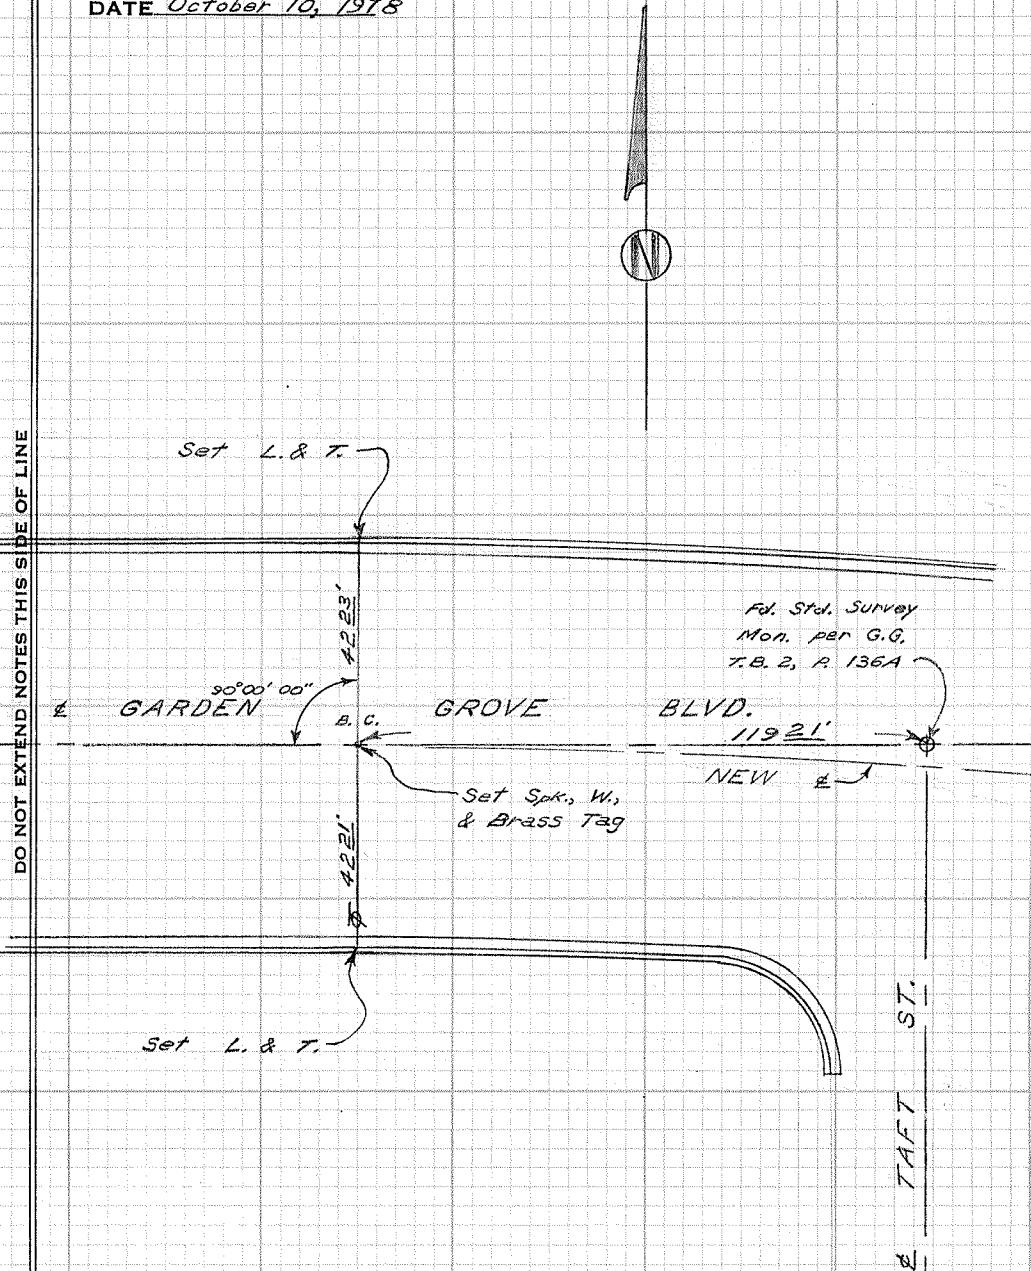


CITY OF GARDEN GROVE, CALIFORNIA

SURVEY OF B.C. on Garden Grove Blvd. West of Taffy T.B. NO. 3 PAGE 108A

SURVEY BY Prickett & Party TRACT NO.

DATE Nov. 15, 1990

DO NOT EXTEND NOTES THIS SIDE OF LINE

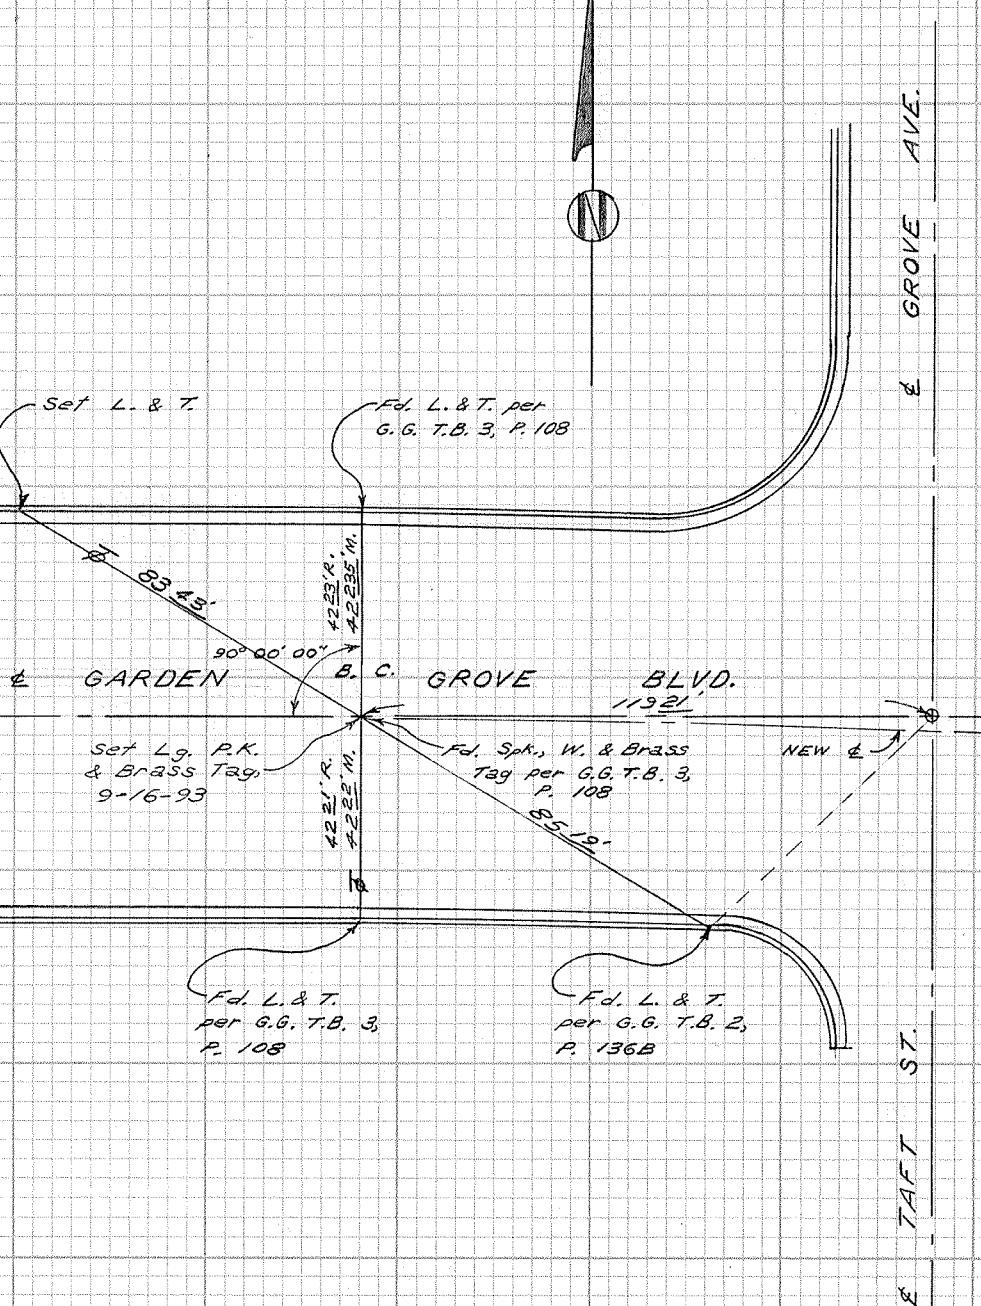


CITY OF GARDEN GROVE, CALIFORNIA

P.R.C. on Garden Grove Blvd.
SURVEY OF W. of Main St. T B NO. 3 PAGE 109
SURVEY BY Prickett & Party TRACT NO.
DATE March 30, 1979

SURVEYORS SERVICE COMPANY STA MESA STOCK NO. 411

DO NOT EXTEND NOTES THIS SIDE OF LINE

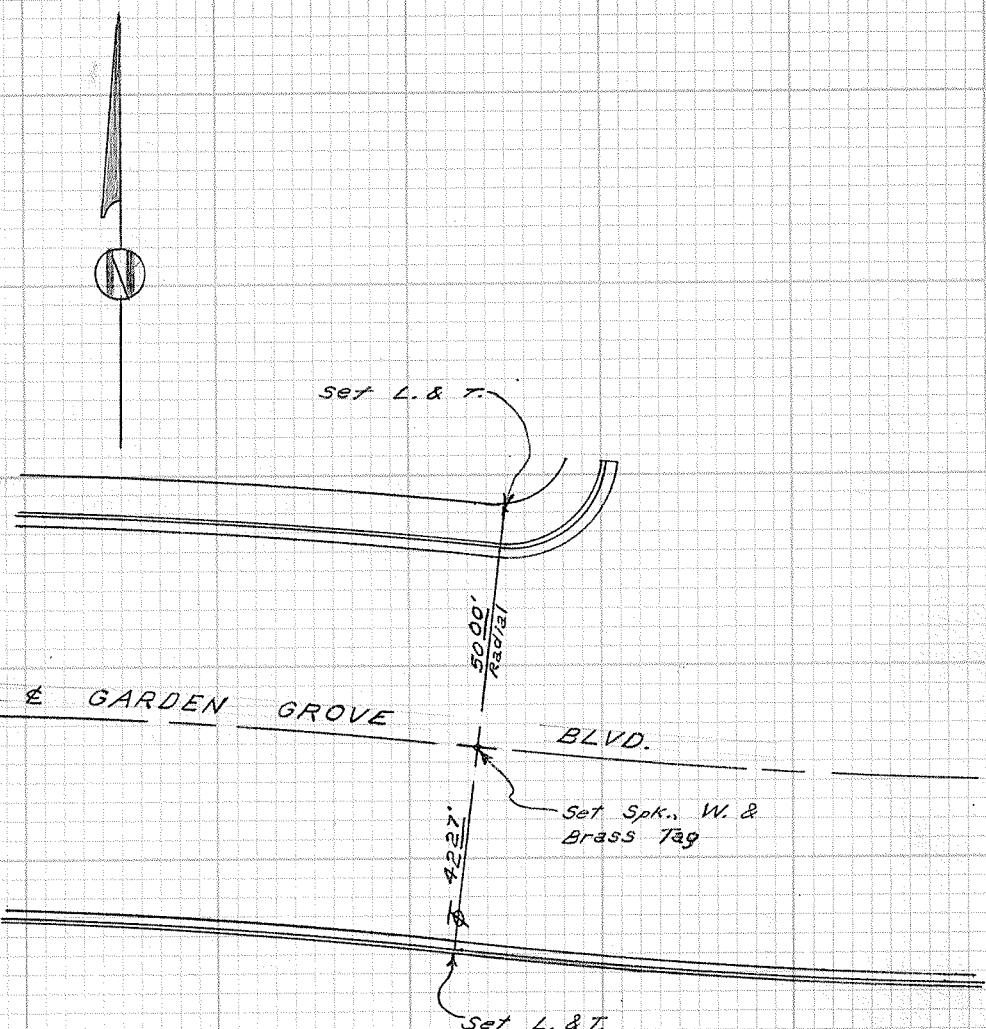

CITY OF GARDEN GROVE, CALIFORNIA

Grove Ave. & Alley W. of Main St.

P.R.C. on Garden Grove Blvd.

SURVEY OF West of Main St.

T B NO 3 PAGE 109A


PAGE 109A

SURVEY BY Prickett & Party

TRACT NO.

DATE Nov. 15, 1990

DO NOT EXTEND NOTES THIS SIDE OF LINE

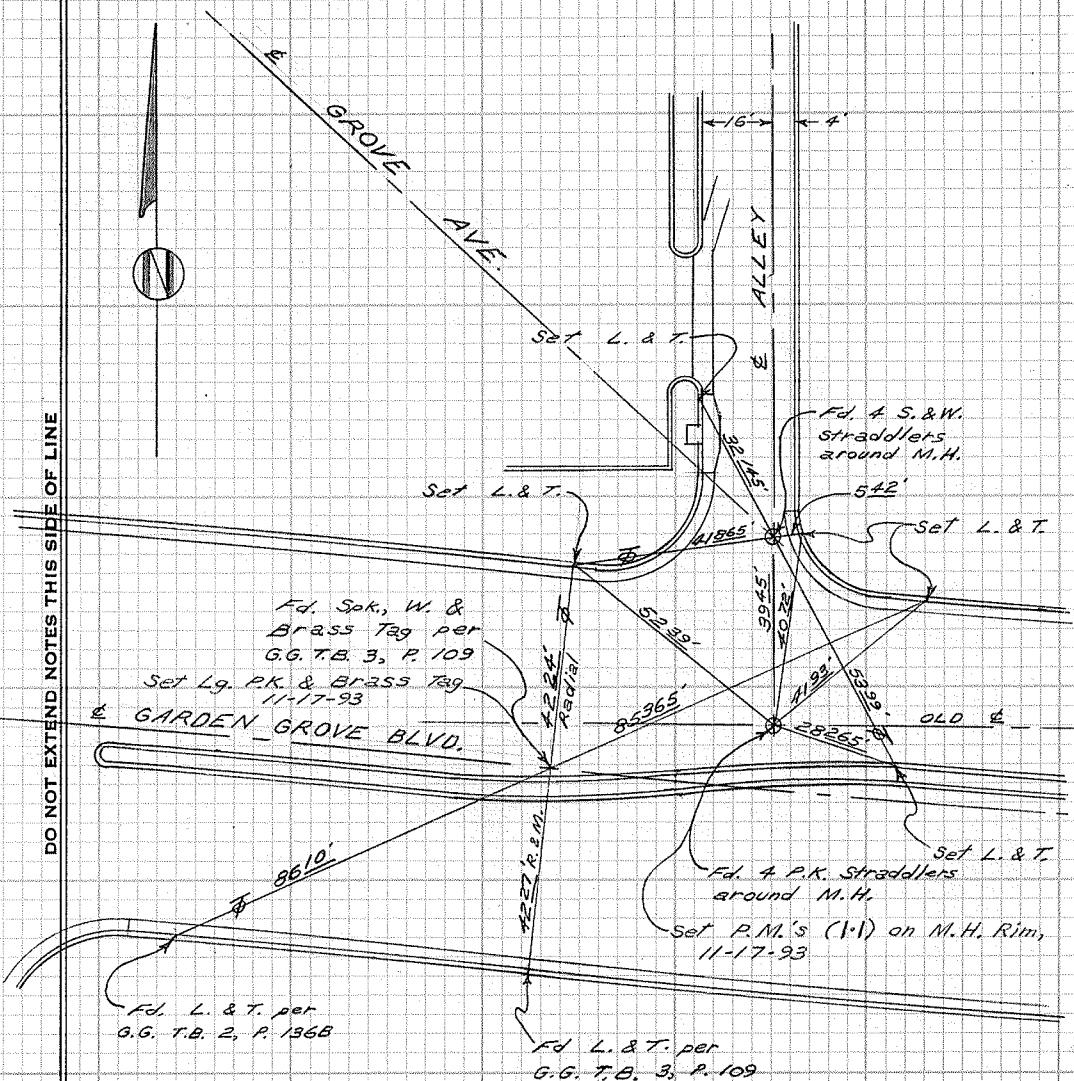

CITY OF GARDEN GROVE, CALIFORNIA

SURVEY OF Garden Grove Bl. & Yockey T B NO. 3 PAGE 114

SURVEY BY Prickett & Party TRACT NO.

DATE April 15, 1981

DO NOT EXTEND NOTES THIS SIDE OF LINE

NE GARDEN GROVE BLVD.

Set L.&T.



At 63°33'

Set L.&T.

50°66'

56°41'

63°31'

Set L.&T.

Fd. Bolt 0.10' N.
of line per A249.001
p. 53. Tied out as
found. Set spk. W.
& brass tag on new
surface on line.
4-29-81


SE YOCKEY ST.

CITY OF GARDEN GROVE, CALIFORNIA

SURVEY OF Garden Grove Blvd. & Hazel T B NO. 3 PAGE 115
SURVEY BY Prickett & Party TRACT NO.
DATE Nov 25, 1980

SURVEYORS SERVICE COMPANY STA MESA - STOCK NO. 411


DO NOT EXTEND NOTES THIS SIDE OF LINE

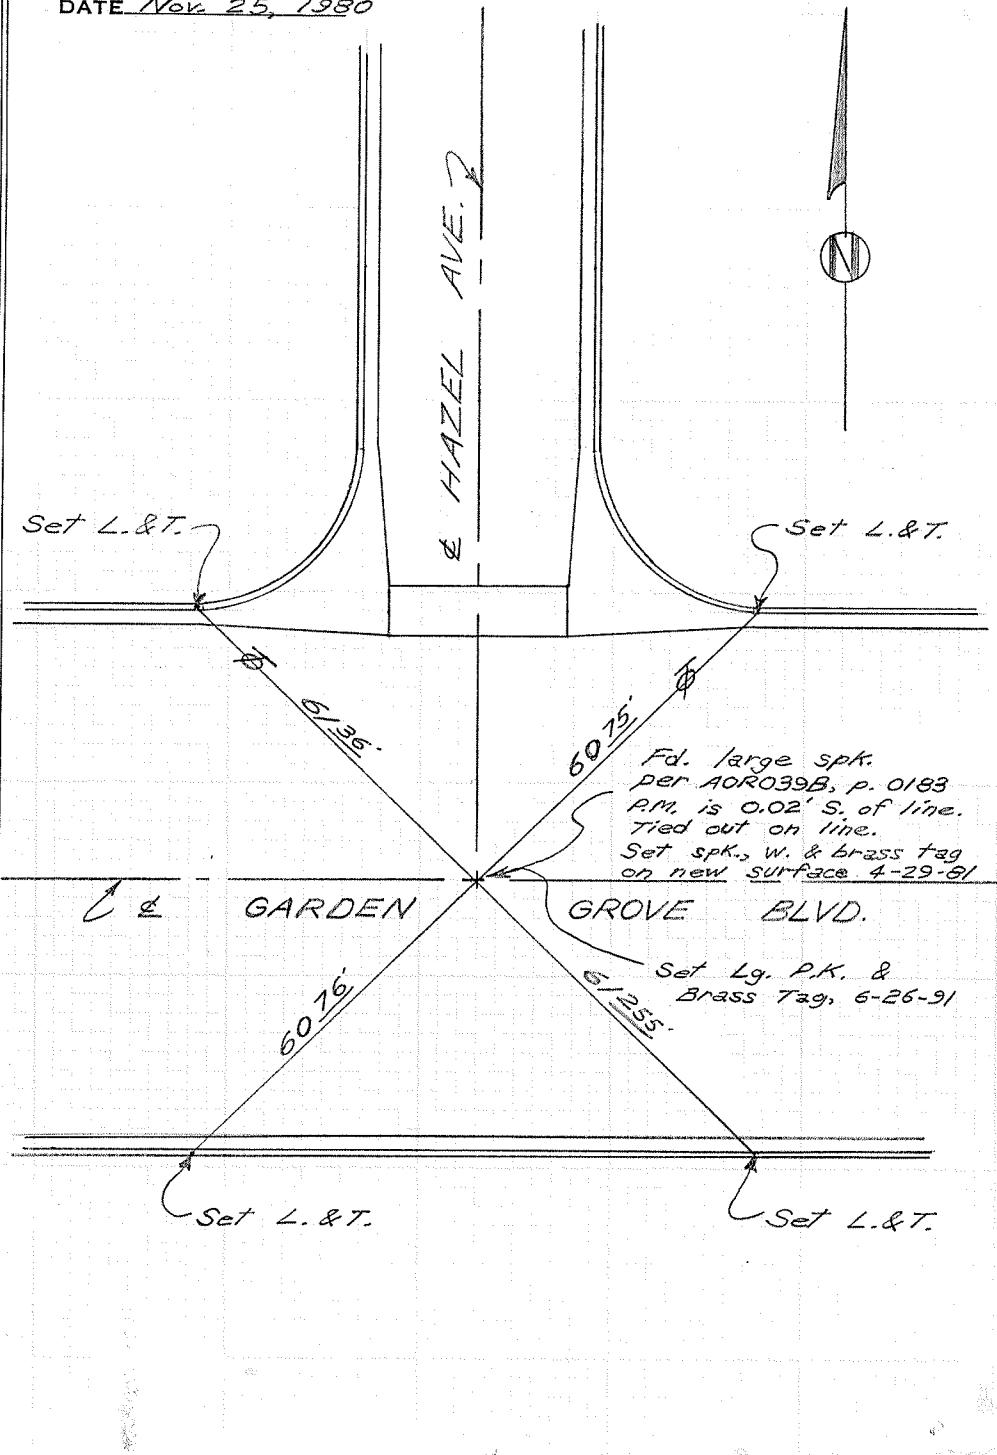

CITY OF GARDEN GROVE, CALIFORNIA

SURVEY OF Lucille & Garden Grove Blvd. TB NO. 3 PAGE 116
SURVEY BY Prickett & Party TRACT NO.
DATE Nov. 25, 1980

DO NOT EXTEND NOTES THIS SIDE OF LINE

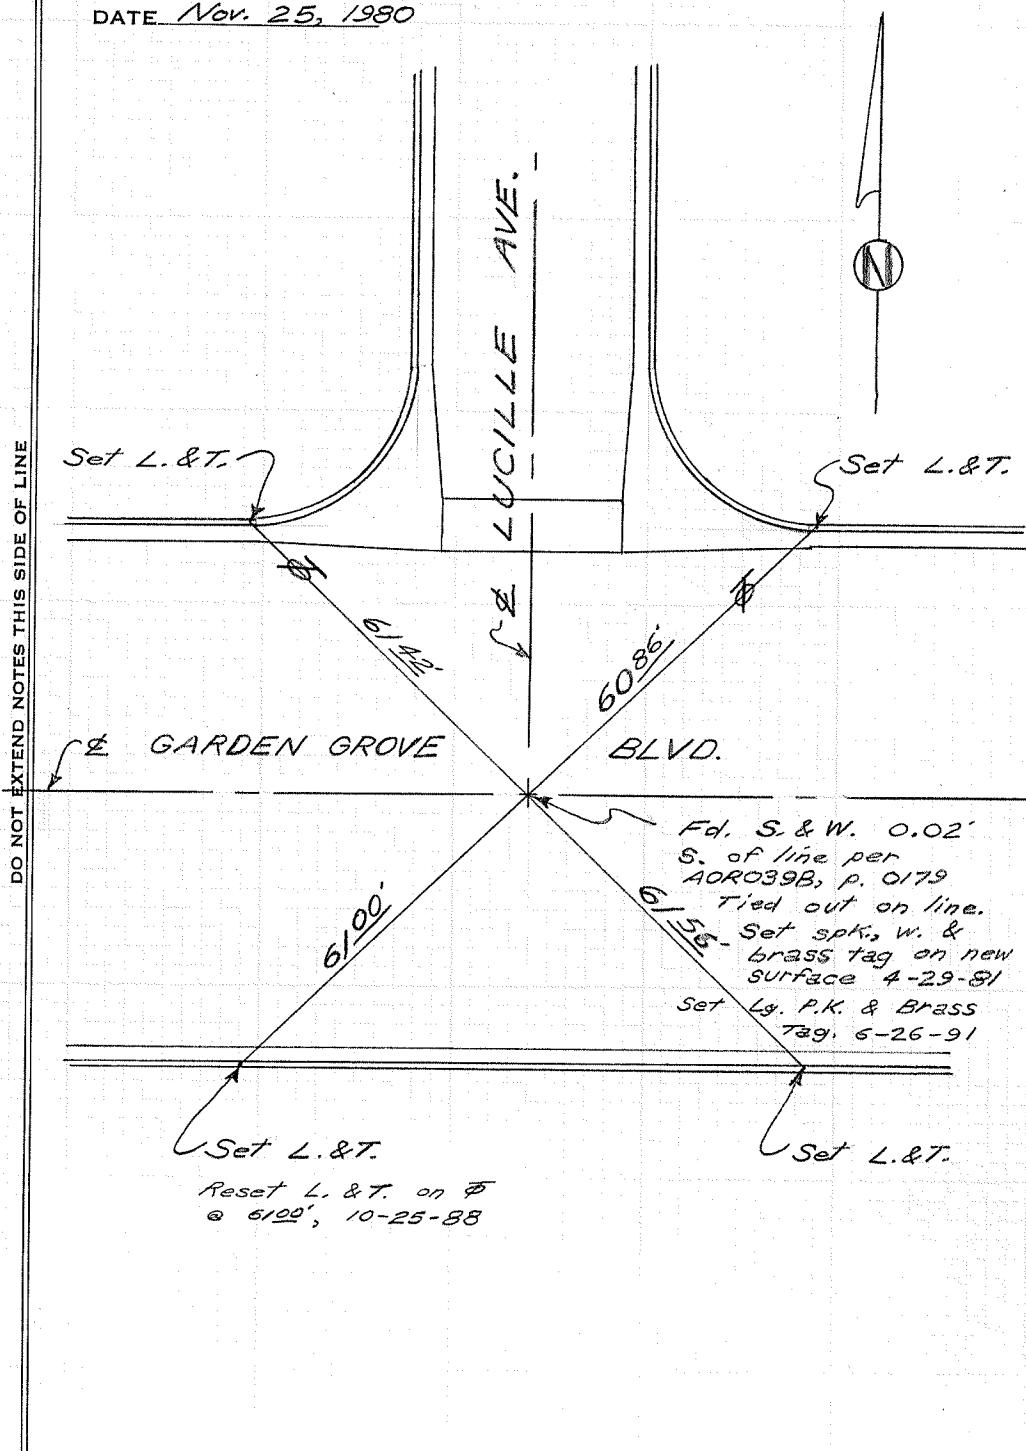


CITY OF GARDEN GROVE, CALIFORNIA

SURVEY OF Shackelford & Garden Grove B. T B NO. 3 PAGE 117
SURVEY BY Prickett & Party TRACT NO.
DATE Nov. 24, 1980

SURVEYORS SERVICE COMPANY OSTA MESA - STOCK NO. 411

DO NOT EXTEND NOTES THIS SIDE OF LINE

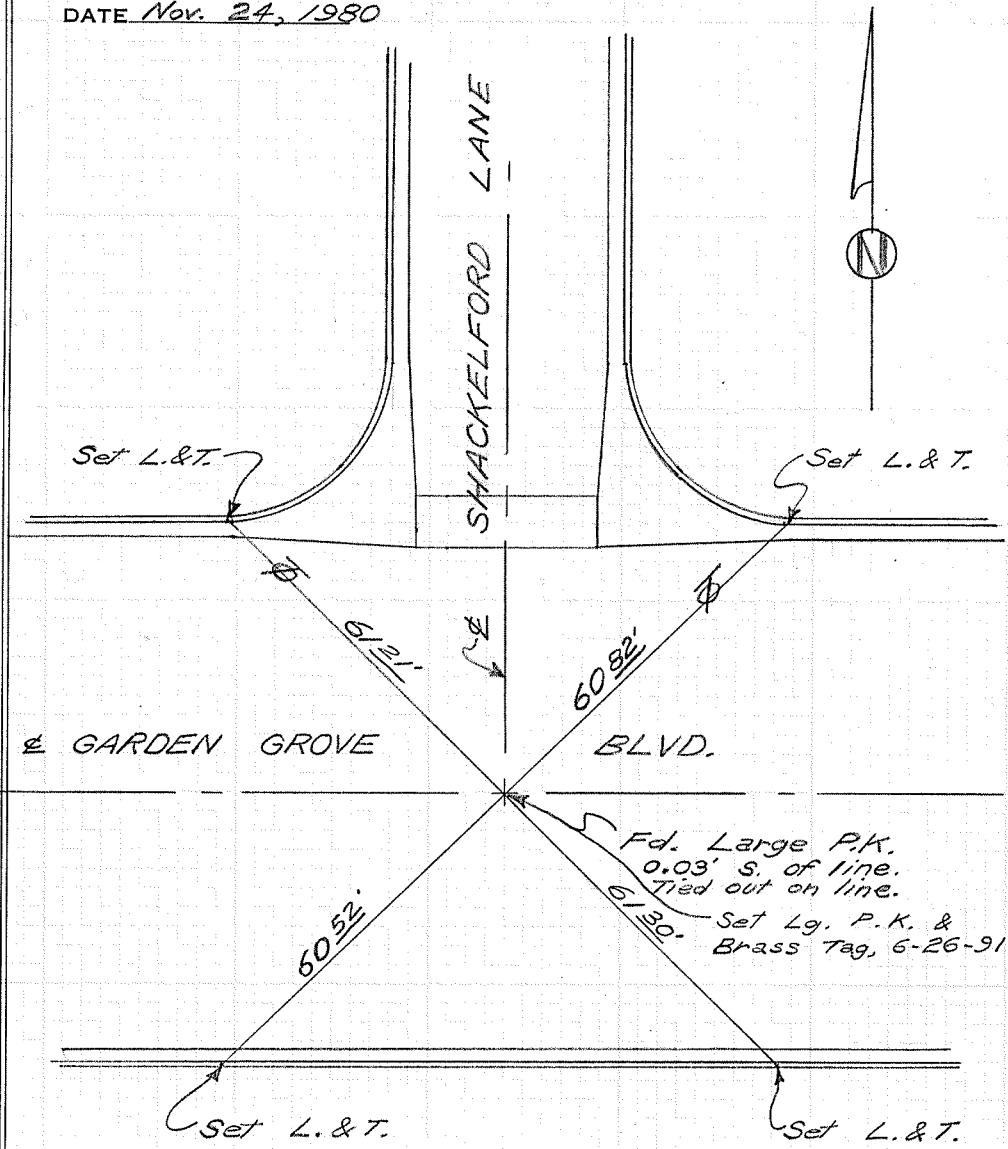

CITY OF GARDEN GROVE, CALIFORNIA


SURVEY OF Park Dr. & Main St. T B NO. 3 PAGE 118

SURVEY BY Prickett & Party TRACT NO.

DATE Sept. 26, 1979

SURVEYORS SERVICE COMPANY DSTA MESA - STOCK NO. 411

DO NOT EXTEND NOTES THIS SIDE OF LINE

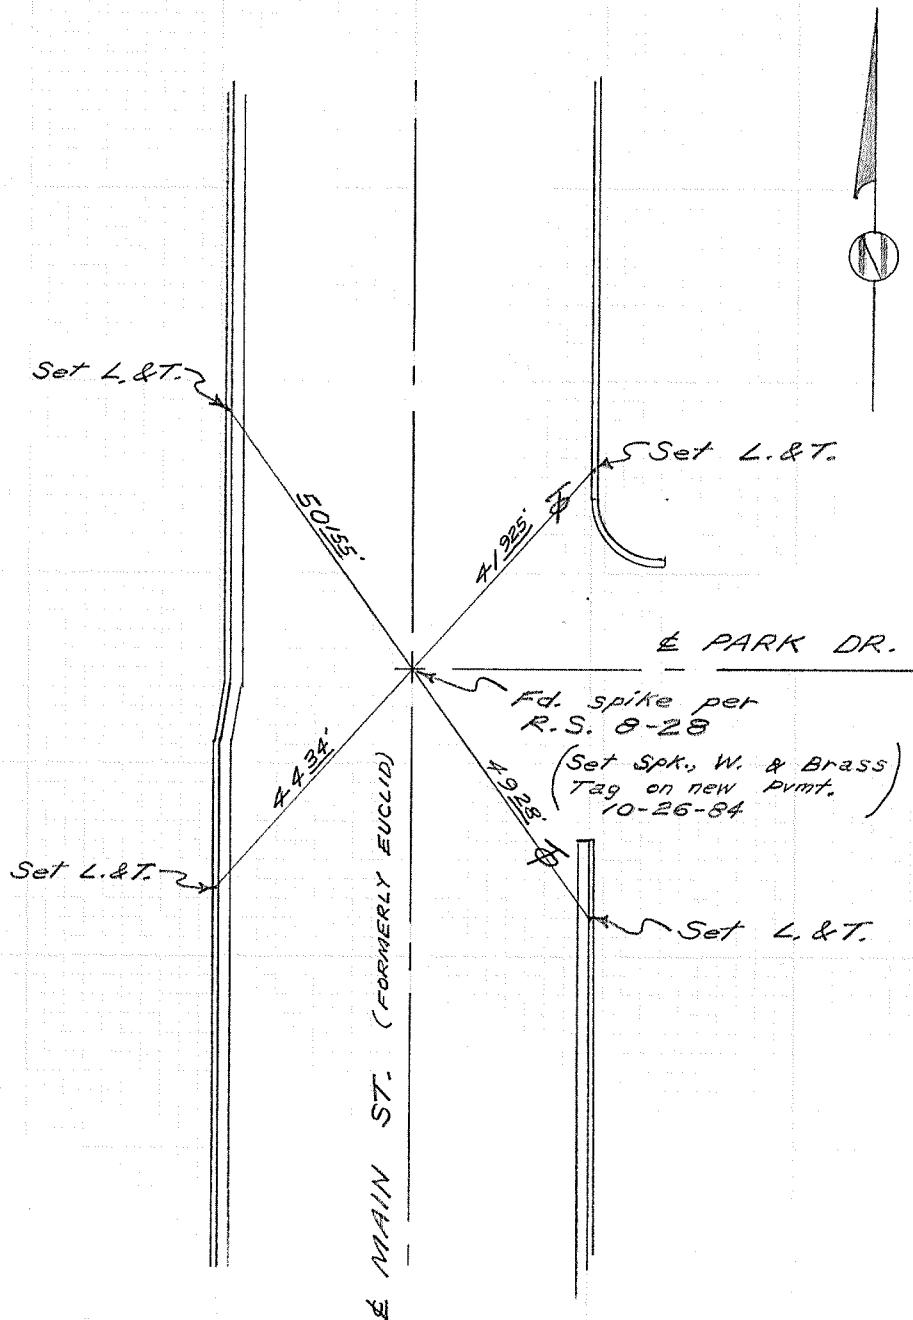


CITY OF GARDEN GROVE, CALIFORNIA

SURVEY OF GILBERT ST. P.I. N. of G.G. BLVD. T B NO. 3 PAGE 119
 SURVEY BY Prickett & Party TRACT NO.
 DATE Sept. 10, 1979

SURVEYORS SERVICE COMPANY STA MESA - STOCK NO. 411

DO NOT EXTEND NOTES THIS SIDE OF LINE

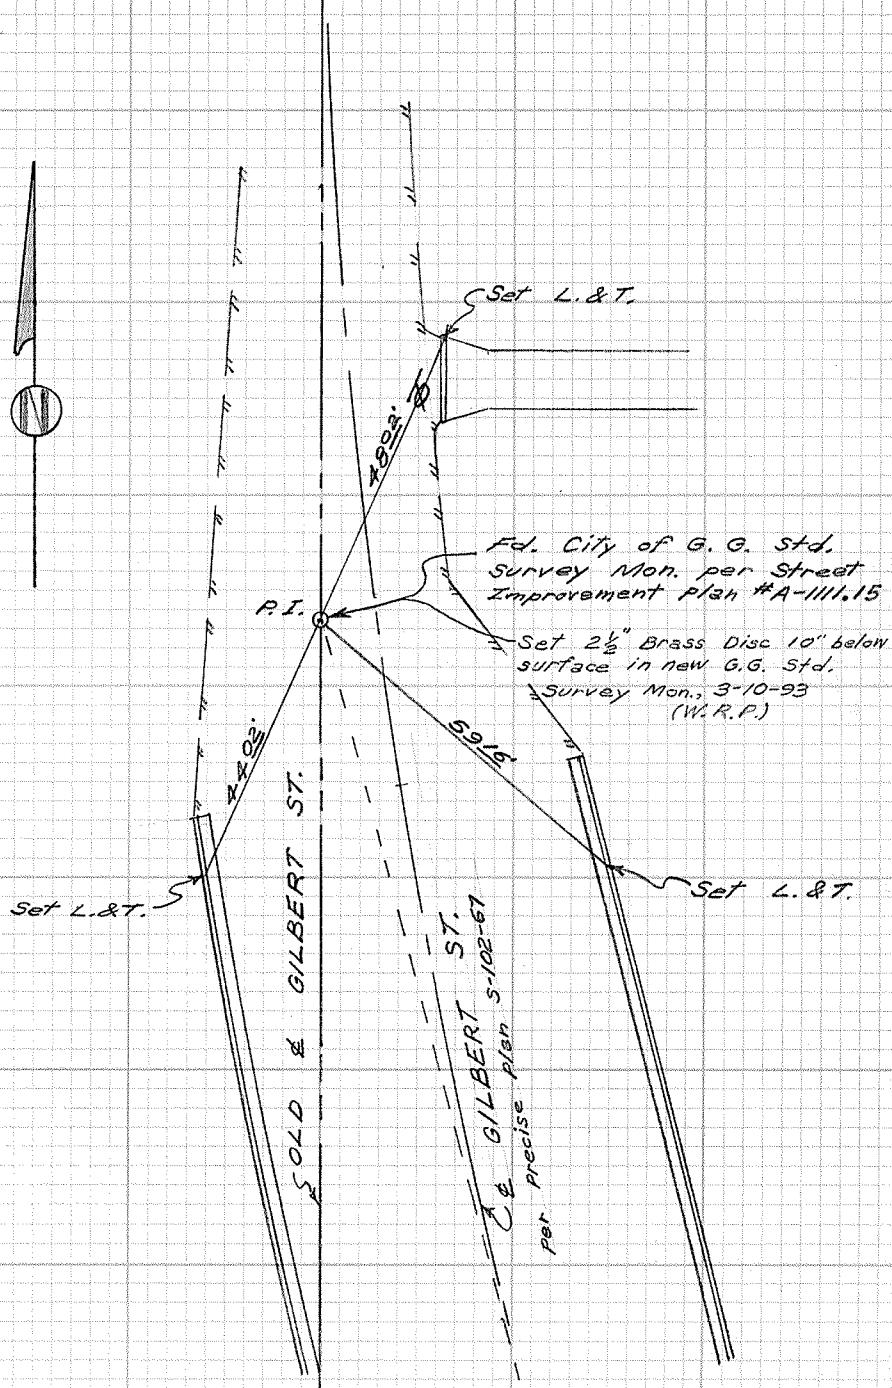


CITY OF GARDEN GROVE, CALIFORNIA

SURVEY OF Stanford & Gilbert TB NO. 3 PAGE 120
SURVEY BY Prickett & Party TRACT NO.
DATE Sept. 11, 1979

SURVEYORS SERVICE COMPANY OSTA MESA - STOCK NO. 411


DO NOT EXTEND NOTES THIS SIDE OF LINE

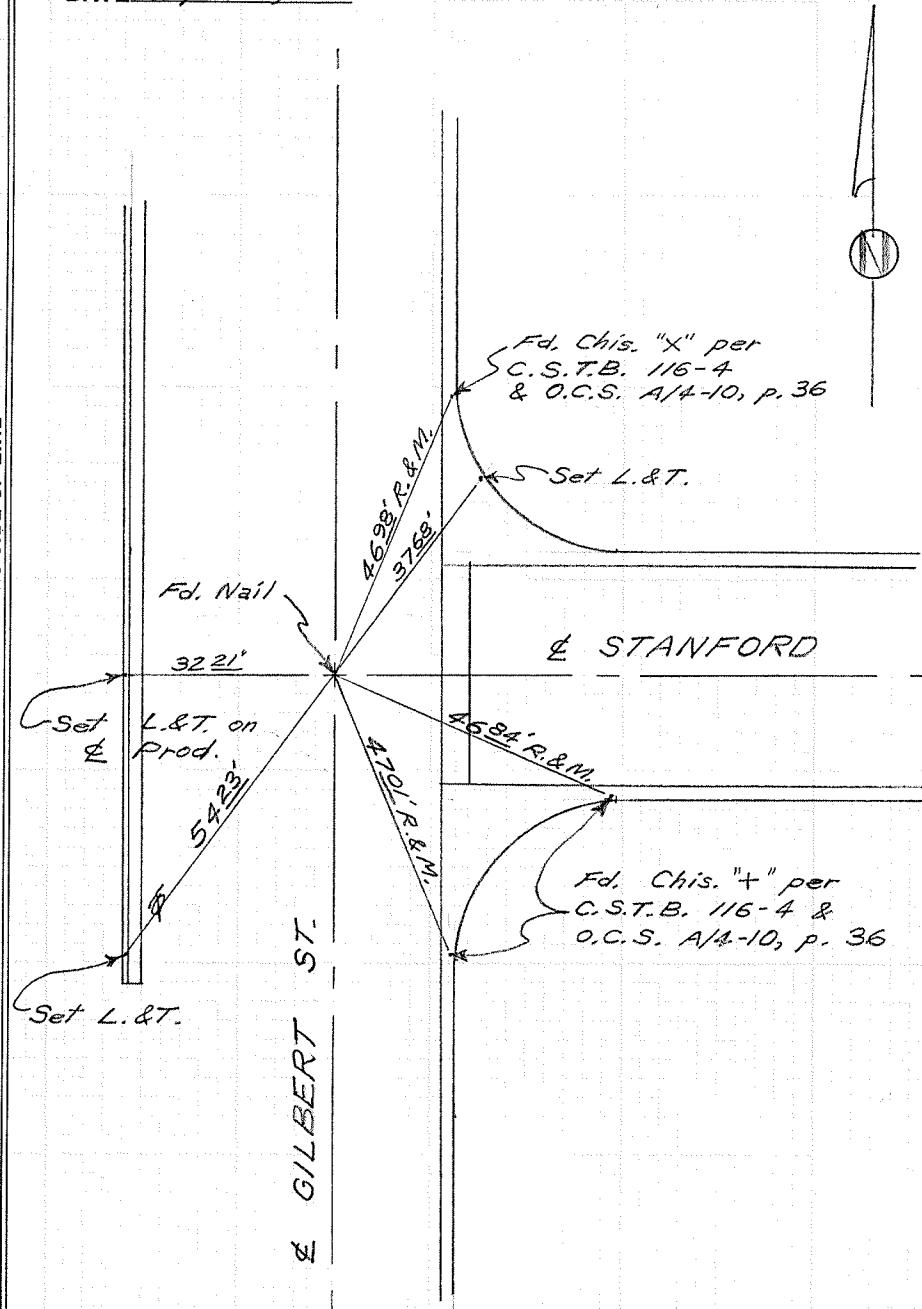

CITY OF GARDEN GROVE, CALIFORNIA

SURVEY OF GILBERT & STANFORD T.B. NO. 3 PAGE 120A
SURVEY BY SIMONS SURVEYING TRACT NO.
DATE OCT. 5, 1989

DO NOT EXTEND NOTES THIS SIDE OF LINE

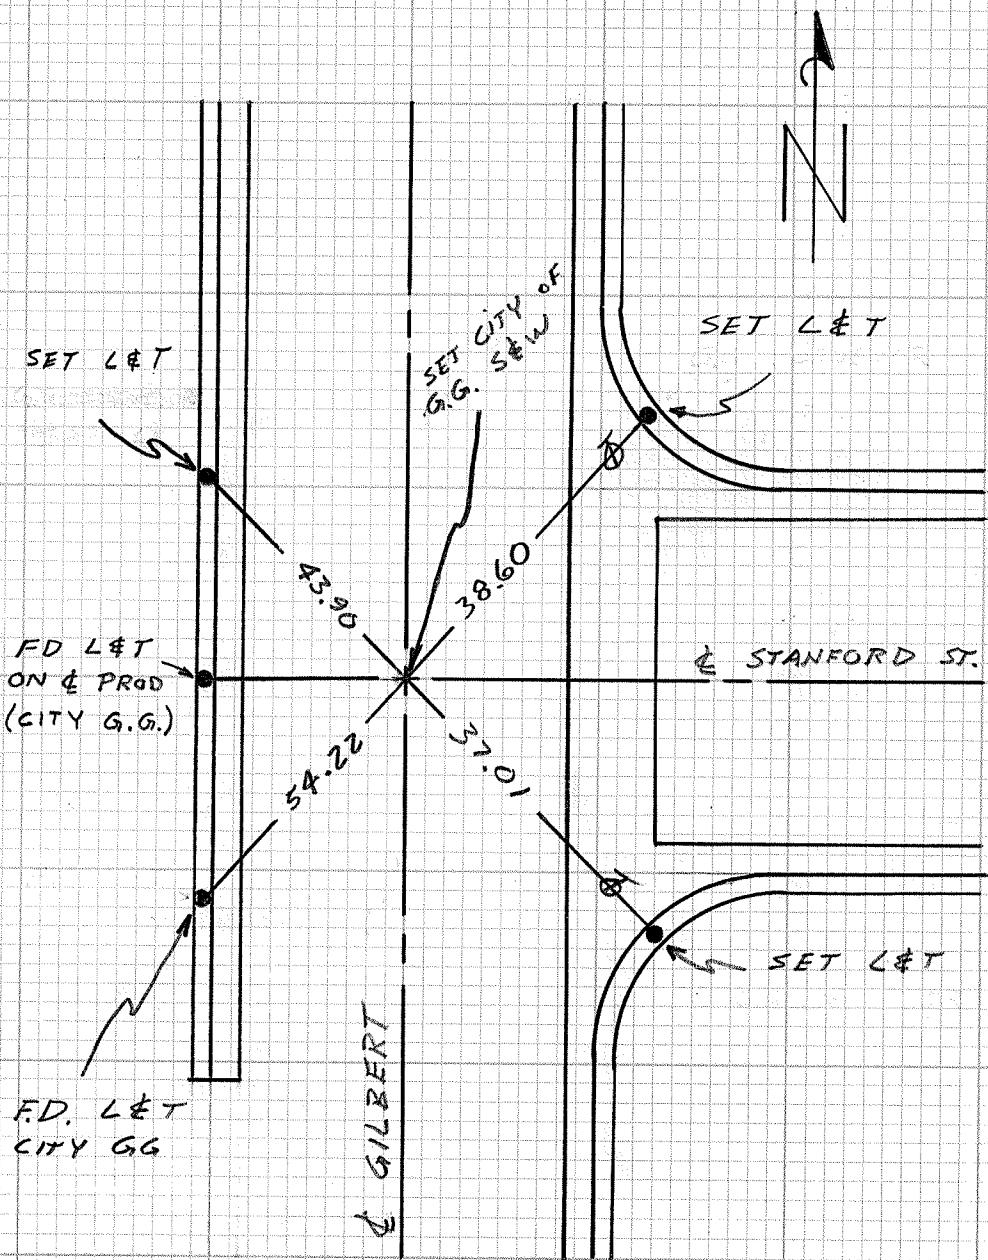


SURVEYORS SERVICE COMPANY COSTA MESA - STOCK NO. 411

CITY OF GARDEN GROVE, CALIFORNIA

SURVEY OF GILBERT ST. & MAYRENE DR. T B NO. 3 PAGE 121
SURVEY BY PRICKETT, KOENINGS, RAY TRACT NO. 1835
DATE SEPT. 10, 1979

DO NOT EXTEND NOTES THIS SIDE OF LINE

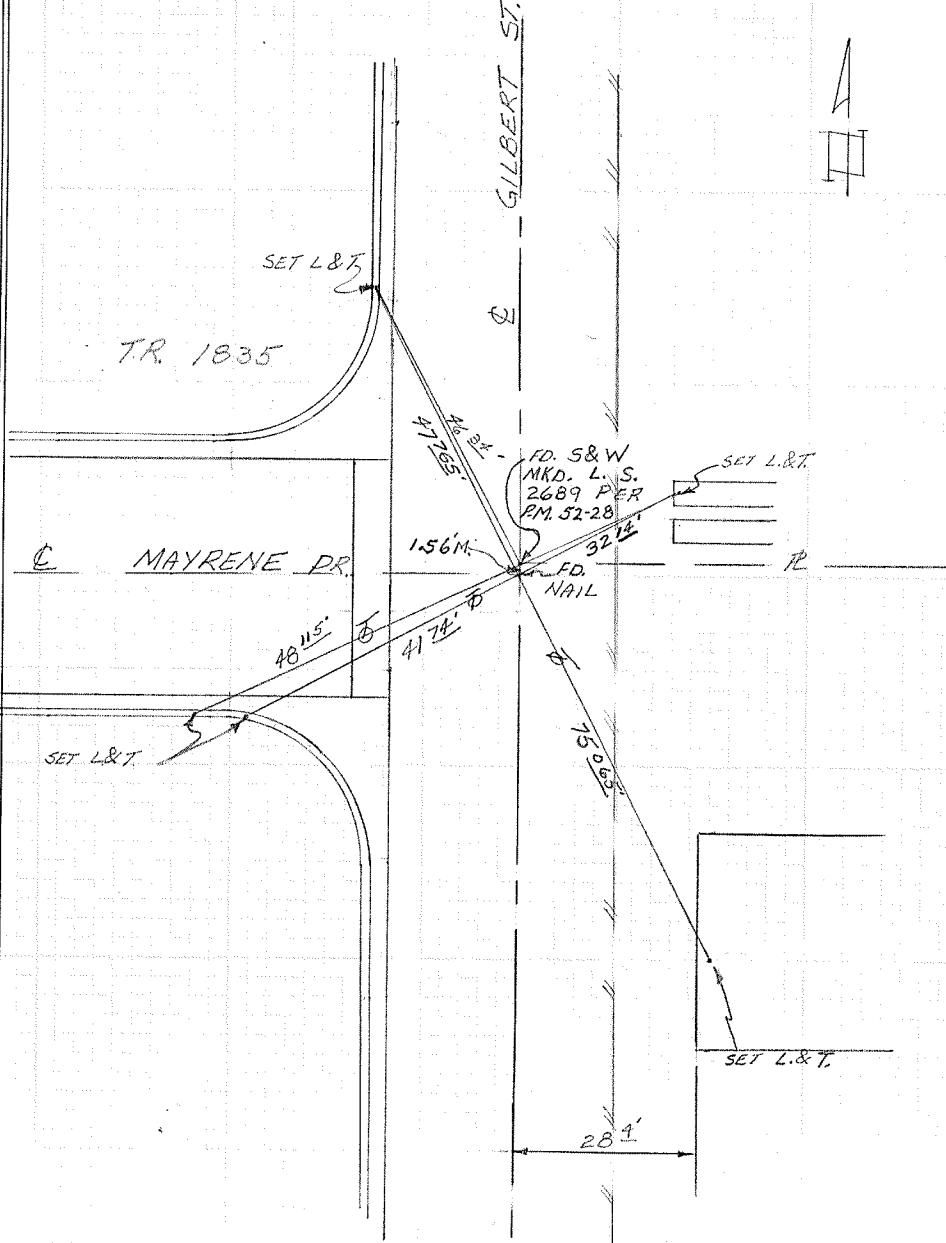

CITY OF GARDEN GROVE, CALIFORNIA

SURVEY OF GILBERT & MAYRENE

TB NO. 3

PAGE 121A

SURVEY BY SIMONS SURVEYING TRACT NO.

DATE OCT. 5, 1989

DO NOT EXTEND NOTES THIS SIDE OF LINE

